
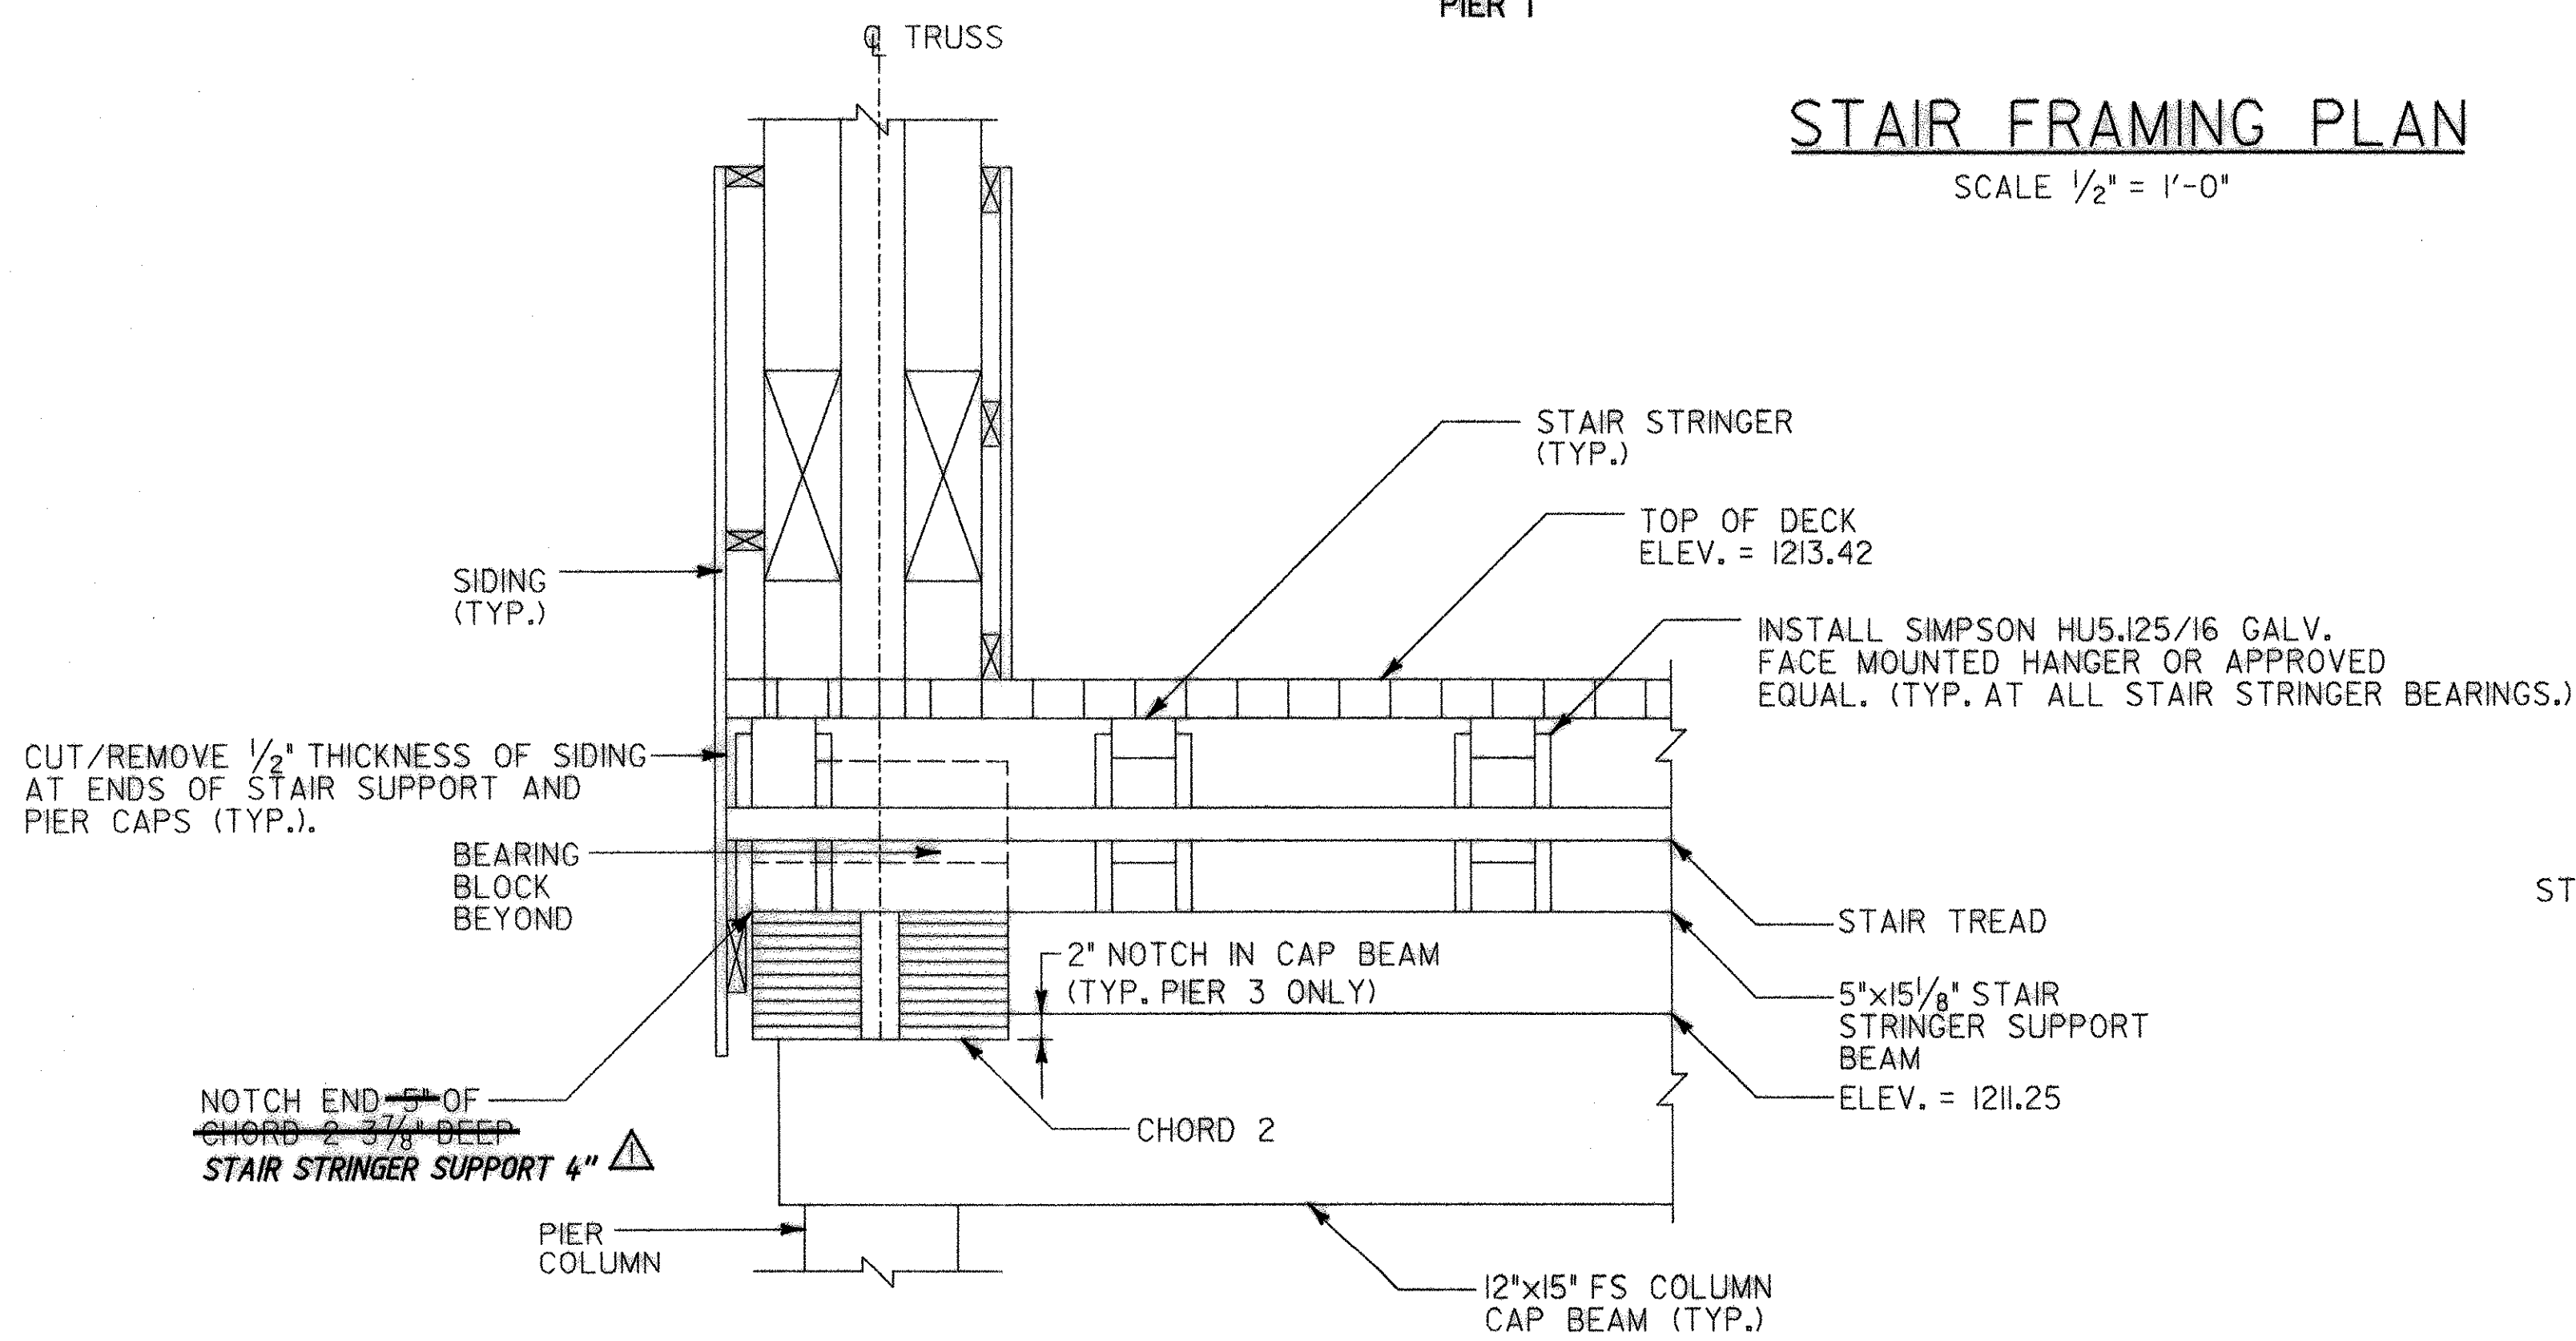



STAIR FRAMING PLAN

SCALE 1/2" = 1'-0"

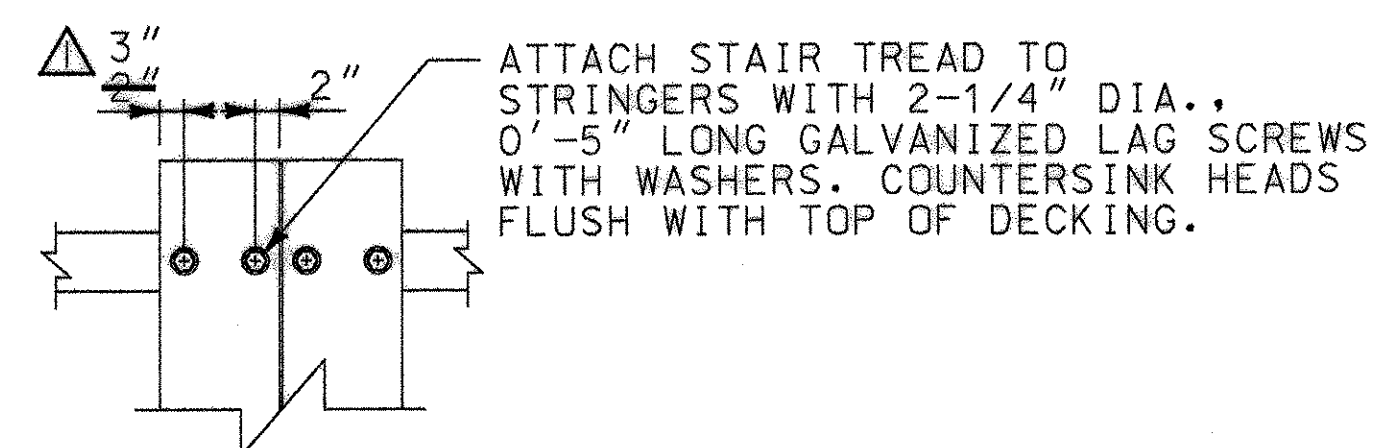

SECTION A-A

SCALE 1" = 1'-0"

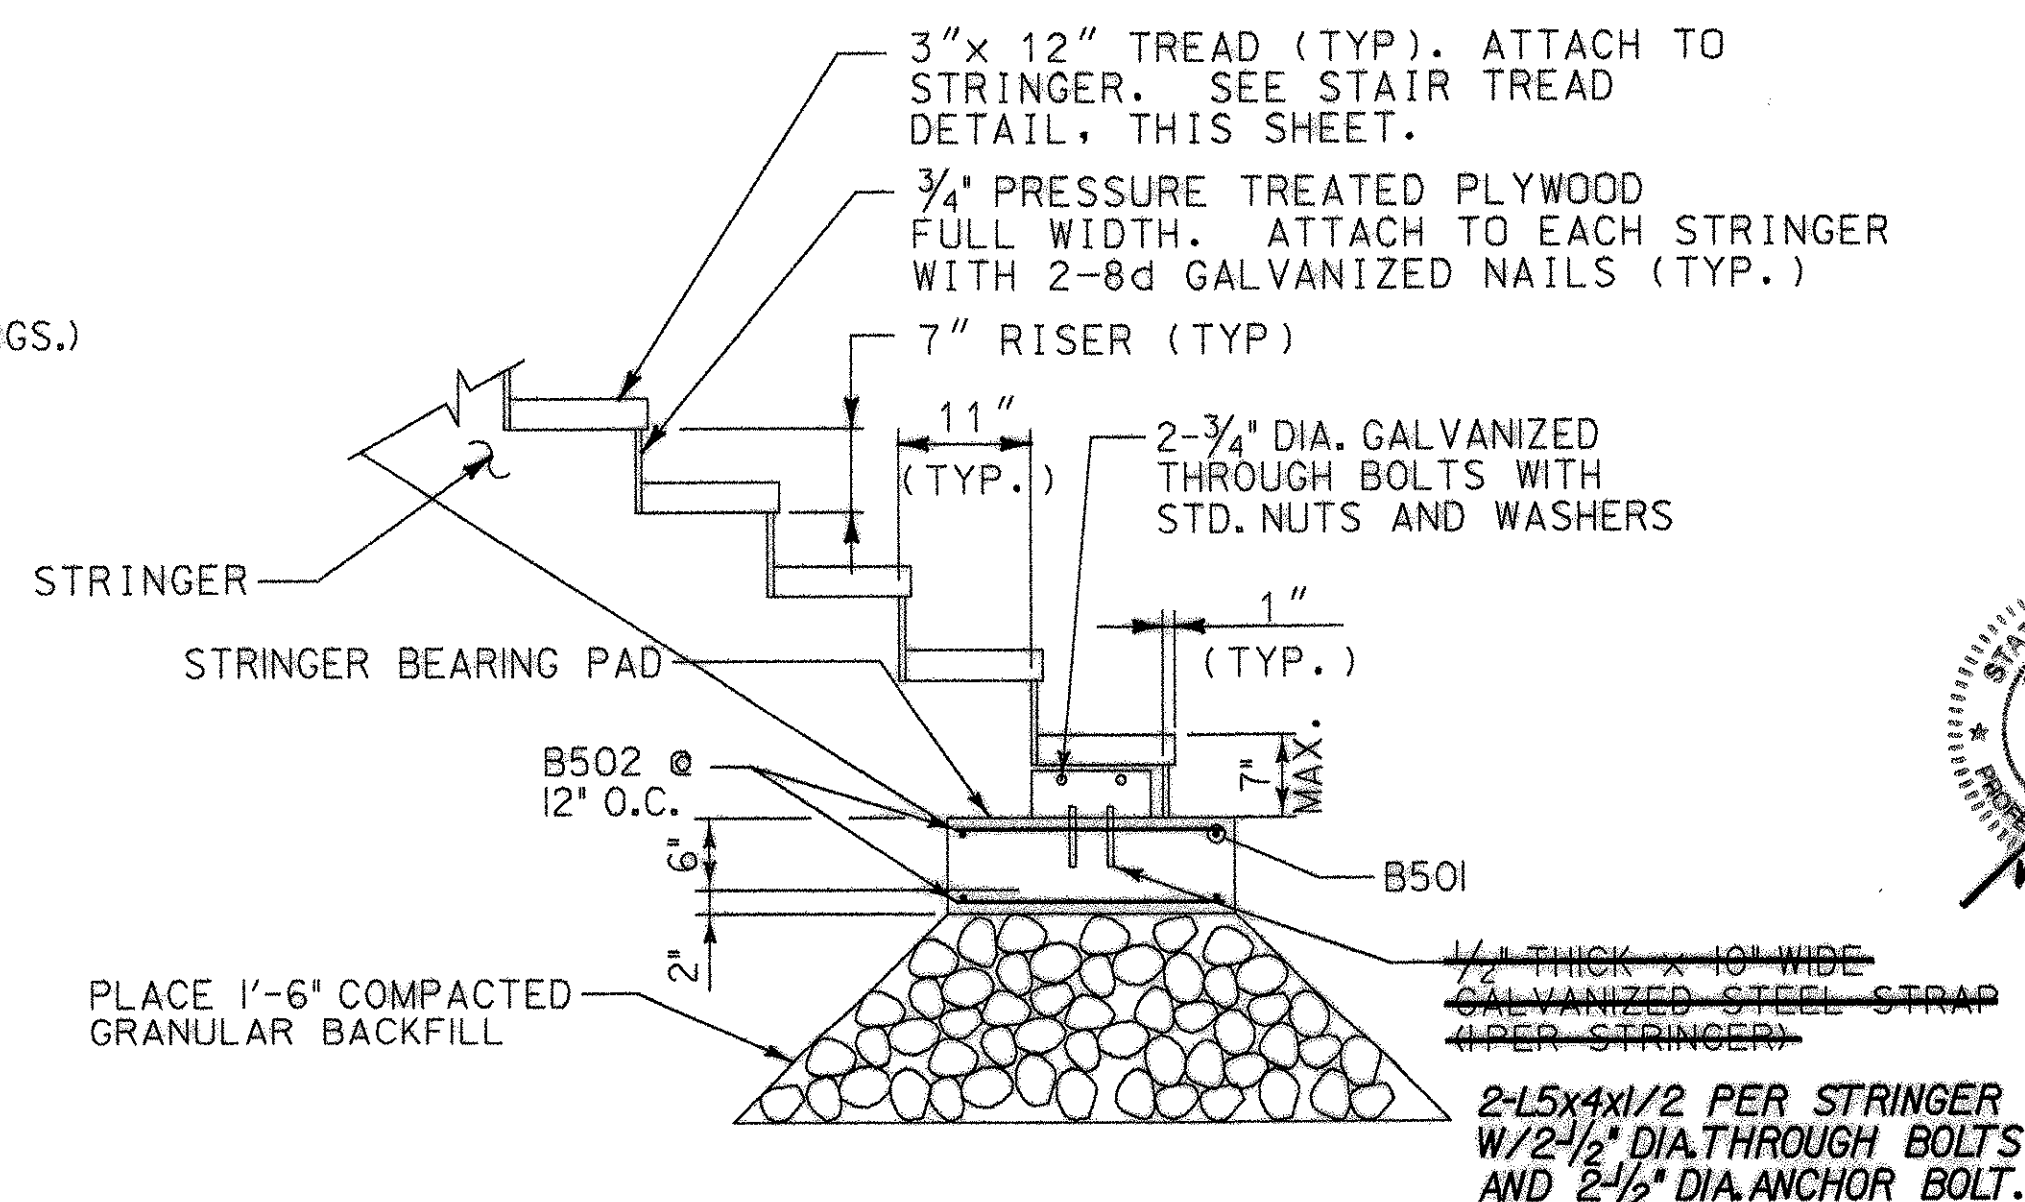


TYPICAL STRINGER ELEVATION

SCALE 3/4" = 1'-0"

PLAN NOTES

- SEE SHEET 10 FOR PIER DETAILS.
- THE CONTRACTOR SHALL SUBMIT CUT SHEETS FOR ALL CONNECTION HARDWARE TO THE ENGINEER FOR REVIEW AND APPROVAL PRIOR TO ORDERING.

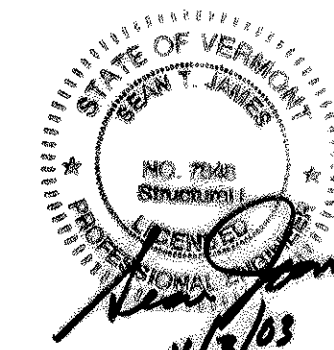

HIA CONSULTING ENGINEERS
 150 Dow Street - Manchester, NH 03101-1227
 Tel: 603-669-5555 Fax: 603-669-4668
 184 South Winslow Ave. - Burlington, VT 05401
 Tel: 802-860-1331 Fax: 802-860-6499
 Web Page: www.hiaengineers.com E-mail: hia@hiamn.com

RECORD COPY REVISIONS		DR BY JBM	CHK BY STJ
Town Of	BRIGHTON		Bridge No.
Highway No.			Log Sta.
		Surv. Sta.	
BRIGHTON PEDESTRIAN BRIDGE			
STAIR PLAN & DETAILS			
Designed By	S.T. JAMES	Drawn By	W. DRUDING
Checked By	R.H. DURFEE	Date	MAY 2002
		Bridge Design Supervisor	Date
PROJECT	BRIGHTON		PROJECT NO.
		Z9068PR2.dgn	STP BIKE (14)S
I.G.C. Info.			
Bridge Sheet No.	8	Sheet	8 of 14