



**TYPICAL PATH SECTION**  
NOT TO SCALE

**ELEVATION**  
NOT TO SCALE

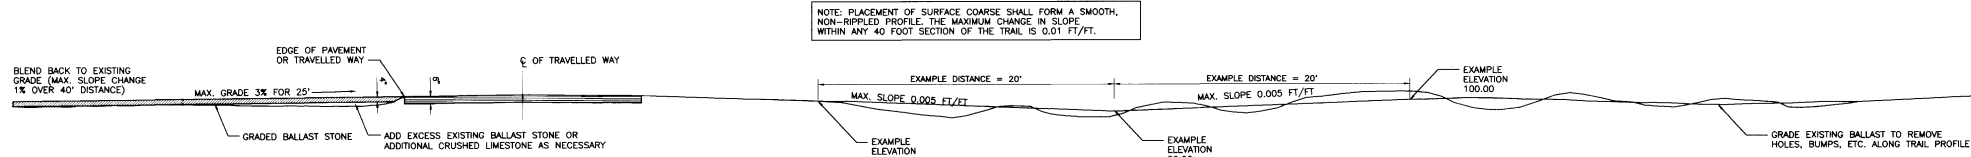


**TYPICAL PROFILE AT INTERSECTIONS OF PUBLIC AND RESIDENTIAL ROADS AND DRIVEWAYS**  
NOT TO SCALE

**TYPICAL PROFILE ALONG TRAIL CENTERLINE**  
SCALE: 1/4" = 1'-0"

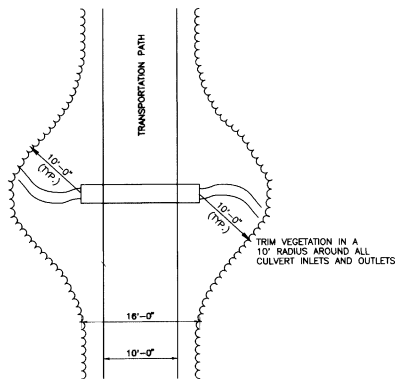

**TYPICAL CLEARING DETAIL AT ALL CULVERTS**  
NOT TO SCALE

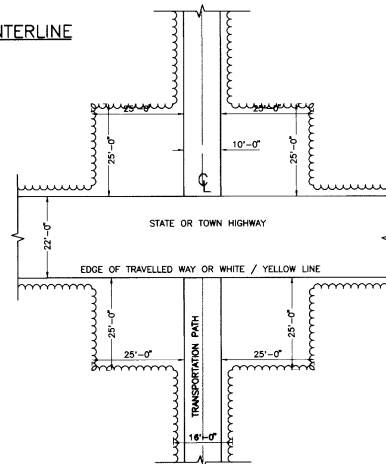

**TYPICAL CLEARING DETAIL AT ALL CROSSINGS**  
NOT TO SCALE

**TYPICAL SECTION AND DETAIL SHEET #1**

SURVEYED BY	N/A	DATE	N/A
DRAWN BY	SMR	DATE	7/8/96
SQUAD LEADER	N/A		
DESIGN FILE NO.	DETSHT1.DWG		
IPARM FILE		DATE PLOTTED	7-8-96
PROJ. NAME:	SHELDON-RICHFORD TRANSPORTATION PATH		
PROJ. NO.	STP BIKE (17) S		
SHEET	2 OF 43 SHEETS		

DATUM	
VERTICAL	N/A
HORIZONTAL	N/A



# QUANTITIES

## APPROXIMATE SUMMARY OF QUANTITIES

QUANTITIES TOTAL	UNITS	ITEMS	ITEM NO.	ROUNDING
1	LUMP SUM	CLEARING AND GRUBBING (MODIFIED)	201.10	
25	EACH	REMOVING SMALL TREES (MODIFIED)	201.15	EST.
3	EACH	REMOVING LARGE TREES (MODIFIED)	201.16	EST.
2	ACRES	THINNING AND TRIMMING (MODIFIED)	201.30	
9150	<b>CY</b>	AGGREGATE SURFACE COURSE (MODIFIED)	401.10	
310	TONS	BITUMINOUS CONCRETE PAVEMENT	406.25	
2	CUBIC YARD	CONCRETE, CLASS B	501.25	
48.5	MFBM	STRUCTURAL LUMBER AND TIMBER - TREATED	522.25	
56	LINEAR FEET	60" RCP (MODIFIED)	601.0865	EST.
140	LINEAR FEET	18" CPEP; SL (MODIFIED)	601.0915	
44	LINEAR FEET	24" CPEP; SL (MODIFIED)	601.0920	
50	LINEAR FEET	30" CPEP; SL (MODIFIED)	601.0925	
500	LINEAR FEET	12" CPEP; SL (MODIFIED)	601.2605	
1	EACH	PRC D.I. WITH COVER (MODIFIED)	604.26	
250	HOURS	POWER GRADER RENTAL	608.15	EST.
300	HOURS	ALL PURPOSE EXCAV. TYPE I	608.25	
300	HOURS	TRUCK RENTAL	608.37	
27	<b>CY</b>	STONE FILL, TYPE II	613.11	
1,100	LINEAR FEET	CHAIN LINK FENCE, 6 FEET (MODIFIED)	620.12	
20	EACH	BRACING ASSEMBLY FOR CHAIN-LINK FENCE, 6 FEET	620.21	2
2,000	LINEAR FEET	WOVEN WIRE FENCE WITH STEEL POSTS (MODIFIED)	620.25	EST.
54	EACH	DRIVE GATE FOR WOVEN WIRE FENCE (MODIFIED)	620.30	
12	EACH	STEEL BRACE FOR WOVEN WIRE FENCE	620.40	
500	LINEAR FEET	REMOVING AND RESETTING FENCE	620.50	EST.
500	LINEAR FEET	REMOVAL OF EXISTING FENCE	620.55	EST.
1	HOUR	UNIFORM TRAFFIC OFFICERS	630.10	EST.
10	HOUR	FLAGGERS	630.15	EST.
1	LUMP SUM	TESTING EQUIPMENT CONCRETE	631.16	
1	LUMP SUM	TESTING EQUIPMENT BITUMINOUS	631.17	
1	LUMP SUM	MOBILIZATION	635.10	
2560	LINEAR FEET	DURABLE 4" WHITE LINE	646.40	
1350	LINEAR FEET	DURABLE 8" WHITE LINE	646.42	
160	LINEAR FEET	24" STOP BAR	646.46	
200	SQ. YARDS	GEOTEXTILE FOR SILT FENCE	649.51	
800	POUNDS	SEED	651.15	EST.
6000	POUNDS	FERTILIZER	651.18	EST.
8	TONS	AGRICULTURE LIMESTONE	651.20	EST.
8	TONS	HAY MULCH	651.25	EST.
500	EACH	HAY BALES FOR EROSION CONTROL	651.26	EST.
2525	SQ. FEET	TRAFFIC SIGNS, TYPE A	675.20	95
12,700	POUNDS	FLANGED CHANNEL SIGN POSTS	675.30	95
1,700	POUNDS	TUBULAR ALUMINUM SIGN POSTS	675.32	33
12,700	POUNDS	SQUARE TUBE STEEL POSTS AND ANCHORS - OPTION FOR 675.30	675.34	33
20	EACH	REMOVING SIGNS	675.50	EST.
20	EACH	ERECTING SALVAGED SIGNS	675.60	EST.
30	TONS	COLLECTION & DISPOSAL OF BULKY METALLIC WASTE, (MODIFIED)	681.10	EST.

### QUANTITY SHEET


SURVEYED BY N/A DATE N/A  
 DRAWN BY SMR DATE 7-2-96  
 SQUAD LEADER N/A  
 DESIGN FILE NO. MAIN-LAY.DWG  
 I/PARM FILE DATE PLOTTED 7-3-96  
 PROJ. NAME SHELDON - RICHFORD TRANSPORTATION PATH  
 PROJ. NO. STP BIKE (17) S  
 SHEET 4 OF 43 SHEETS

**LEGEND**

- 105 STATE ROUTE
- 1 TOWN HIGHWAY CLASS I
- 3 TOWN HIGHWAY CLASS II
- 120 TOWN HIGHWAY CLASS III

NOTE: THE FOLLOWING AREAS (SHOWN AS THE HATCHED PATTERN) ARE ENVIRONMENTALLY SENSITIVE. NO EXCAVATION, STORAGE OF MATERIALS OR OTHER DISTURBANCE IS ALLOWED IN THESE AREAS UNLESS OTHERWISE SPECIFIED IN THE PLANS OR DIRECTED BY THE RESIDENT ENGINEER.

RR MM	OFFSET	RR MM	OFFSET
10.14	TO 10.65 LT&RT	13.95	TO 14.20 LT
10.80	TO 11.20 RT	13.95	TO 14.48 RT
11.80	TO 12.73 LT&RT	14.96	TO 16.91 LT&RT
12.81	TO 13.10 RT		

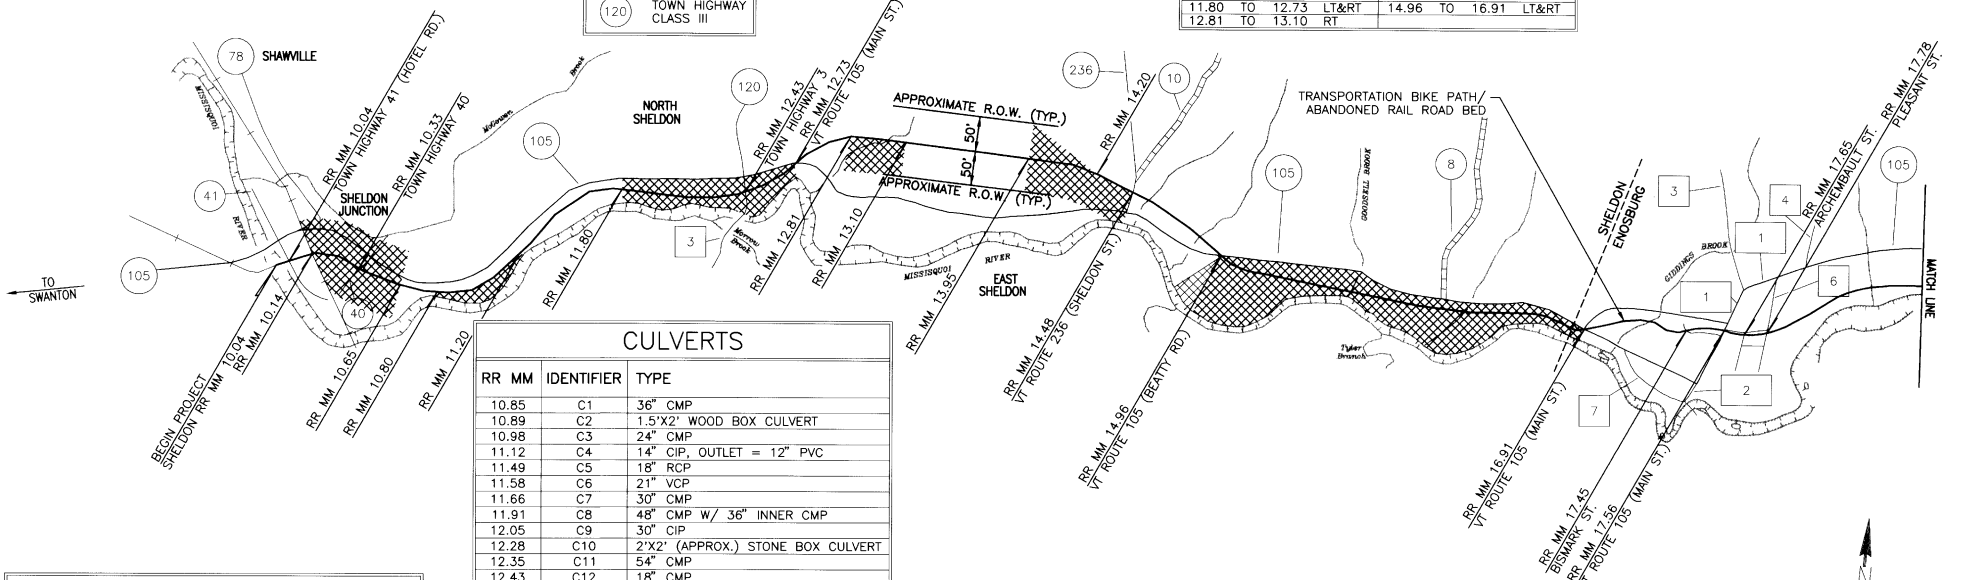

**CULVERTS**

RR MM	IDENTIFIER	TYPE
10.85	C1	36" CMP
10.89	C2	1.5'X2' WOOD BOX CULVERT
10.98	C3	24" CMP
11.12	C4	14" CIP, OUTLET = 12" PVC
11.49	C5	18" RCP
11.58	C6	21" VCP
11.66	C7	30" CMP
11.91	C8	48" CMP W/ 36" INNER CMP
12.05	C9	30" CIP
12.28	C10	2'X2' (APPROX.) STONE BOX CULVERT
12.35	C11	54" CMP
12.43	C12	18" CMP
12.54	C13	3'X4' STONE BOX CULVERT
12.73	C14	48" CMP
13.11	C15	18" VCP
13.75	C16	6' WIDE CONCRETE ARCH CULVERT
13.84	C17	4'X6' CONCRETE/STONE BOX CULVERT
13.91	C18	3'X4' CONCRETE BOX CULVERT
13.97	C19	24" CMP
14.23	C20	4'X5' (APPROX.) CONC. BOX CULVERT
14.35	C21	1'X1' (APPROX.) STONE BOX CULVERT
14.52	C22	6'-6"X4' CONCRETE BOX CULVERT
14.68	C23	2'X3' (APPROX.) STONE BOX INLET
"	"	18" (APPROX.) VCP OUTLET
15.14	C24	UNIDENTIFIED
15.25	C25	4'X4' (APPROX.) CONC. BOX CULVERT
15.34	C26	36" CMP
16.05	C27	2'X2' CONCRETE BOX CULVERT
16.27	C28	24" CMP
16.32	C29	4'X8' CONCRETE BOX CULVERT
16.43	C30	36" CMP
16.57	C31	24" CMP
16.67	C32	30" CMP
16.78	C33	36" CMP
16.83	C34	36" CMP
16.89	C35	2'X2' (APPROX.) CONC. BOX CULVERT
17.07	C36	36" CMP
18.03	C37	36" CMP

**SOLID WASTE**

RR MM	IDENTIFIER	TYPE
10.77	S1	6 CY APPLIANCES
10.85	S2	6 CY HOUSEHOLD
11.94	S3	2 CY GARBAGE
12.09	S4	2 CY PICNIC TABLE DEBRIS
12.59	S5	2 CY DEBRIS
14.09	S6	1 FALLEN TREE
14.40	S7	1 FALLEN TREE
14.59	S8	6 CY WOOD DEBRIS BALER - FARMER'S EQUIP.
14.95	S9	2 LF OF 41" CMP
15.12	S10	6 CY METAL APPLIANCES
16.95	S11	1 50 GAL DRUM
17.05	S12	6 CY BRUSH, PALLET
17.52	S13	6 CY DEBRIS - SHOP OWNER'S
17.92	S14	2 CY FALLEN / CUT TREES
18.02	S15	2 50 GAL DRUMS

NOTE: ALL SOLID WASTE DEPICTED SHALL BE PICKED UP, REMOVED AND DISPOSED OF AS DIRECTED BY THE RESIDENT ENGINEER AND PAID BY THE TON ITEM 681.10 COLLECTION & DISPOSAL OF BULKY METALLIC WASTE (MODIFIED)

DATUM

VERTICAL	N/A
HORIZONTAL	N/A

**NOTES:**

- THE TRANSPORTATION PATH RIGHT OF WAY IS APPROXIMATELY 50' EACH SIDE OF THE PATH CENTER. THIS SHALL BE THE LIMITS OF CONSTRUCTION.
- SEE LAYOUT SHEETS 1 THRU 9 FOR LOCATIONS OF SOLID WASTE AND CULVERTS.



PLAN NOT TO SCALE


**PROJECT LAYOUT #1**  
MM 9.87 - MM 18.5

SURVEYED BY	N/A	DATE	N/A
DRAWN BY	JCL	DATE	12/20/95
SQUAD LEADER	N/A		
DESIGN FILE NO.	PROJLAY.DWG		
FILE		DATE PLOTTED	3/27/96
PROJ. NAME	SHELDON - RICHFORD TRANSPORTATION PATH		
PROJ. NO.	STP BIKE (17) S		
SHEET	5 OF 43 SHEETS		






D:\DATA\PROJECTS\CONSTR\ME2\_Aug\_14\_15.mxd 08/15/96 CAD Plot: From SMC Comp

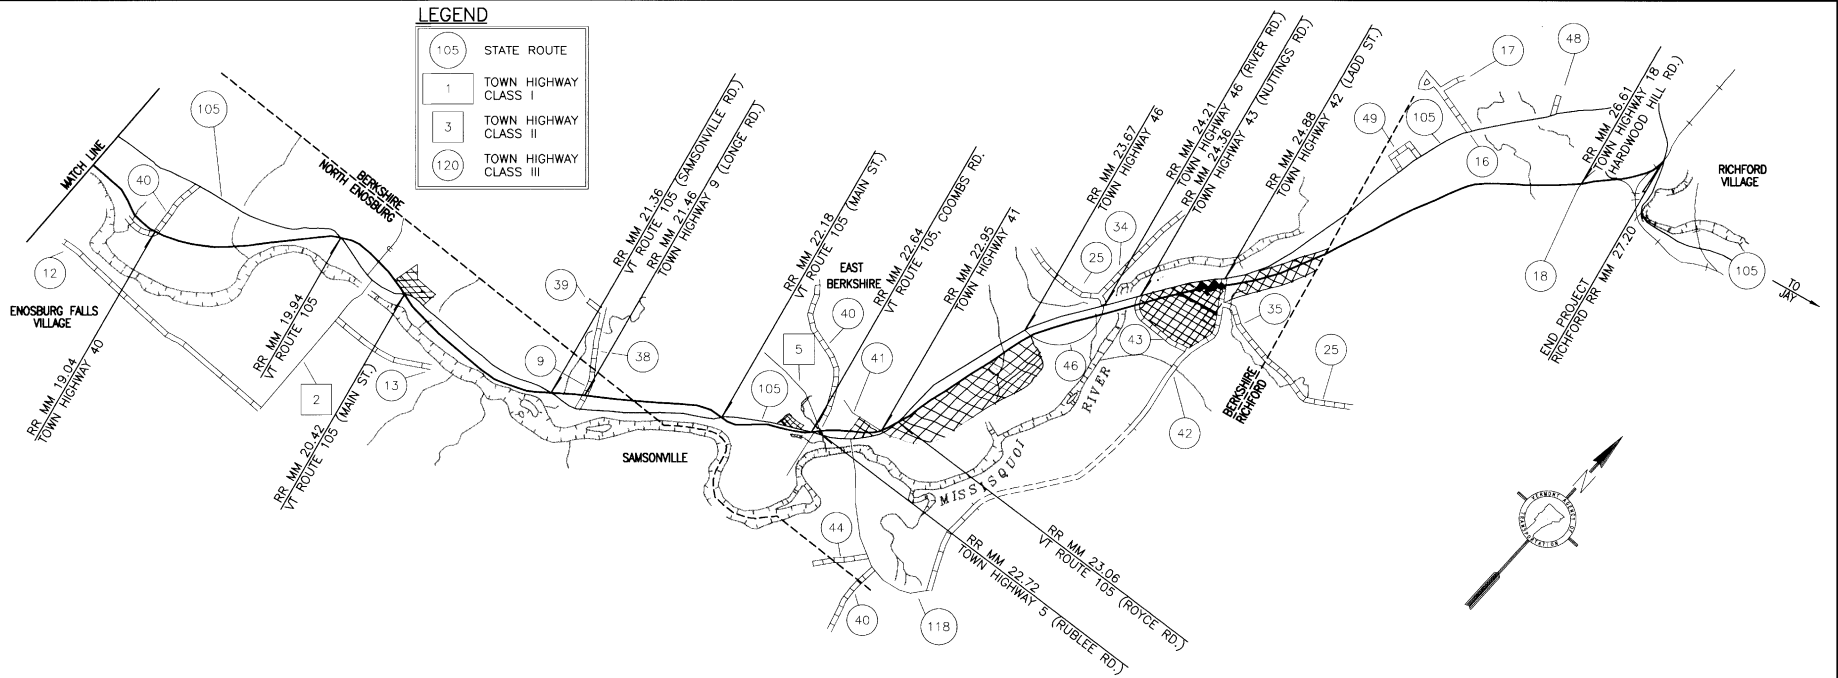

**LEGEND**

105	STATE ROUTE
1	TOWN HIGHWAY CLASS I
3	TOWN HIGHWAY CLASS II
120	TOWN HIGHWAY CLASS III

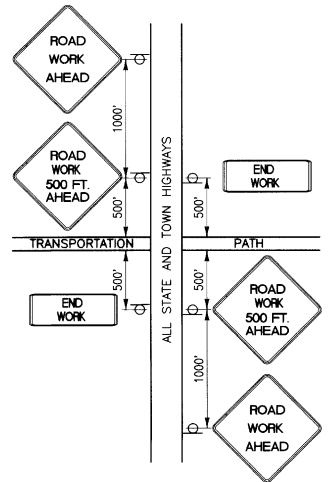

**NOTES:**

- CONSTRUCTION APPROACH SIGNING SHALL BE IN ACCORDANCE WITH THIS PLAN AND DETAIL, THE VERMONT STATE STANDARD SHEET E-100 AND CHAPTER 6 OF THE M.U.T.C.D.
- THIS DETAIL APPLIES TO CROSSINGS AT THE FOLLOWING LOCATIONS:


RR MM 19.04	RR MM 22.18	RR MM 23.06
RR MM 19.94	RR MM 22.64	RR MM 23.67
RR MM 20.42	RR MM 22.72	RR MM 24.21
RR MM 21.36	RR MM 22.95	RR MM 24.36
RR MM 21.46		RR MM 24.88
		RR MM 26.61
		RR MM 27.20

DATUM	
VERTICAL	N/A
HORIZONTAL	N/A

<b>CONSTRUCTION SIGN PLAN SHEET #2</b>		DESIGN FILE NO. CONSTR.DWG	
		IPARM FILE	DATE PLOTTED 3/27/96
SURVEYED BY N/A		DATE N/A	
DRAWN BY SDT		DATE 3/6/96	
DESIGN LEADER N/A			
PROJ. NAME SHELDON-RICHFORD TRANSPORTATION PATH			
PROJ. NO. STP BIKE (17) S			
SHEET 8 OF 43 SHEETS			

PLAN NOT TO SCALE

D:\DATA\PROJECTS\3104-1 - 182 Aug 14 10:47:07 1995 CADP Plot from SRS Corp

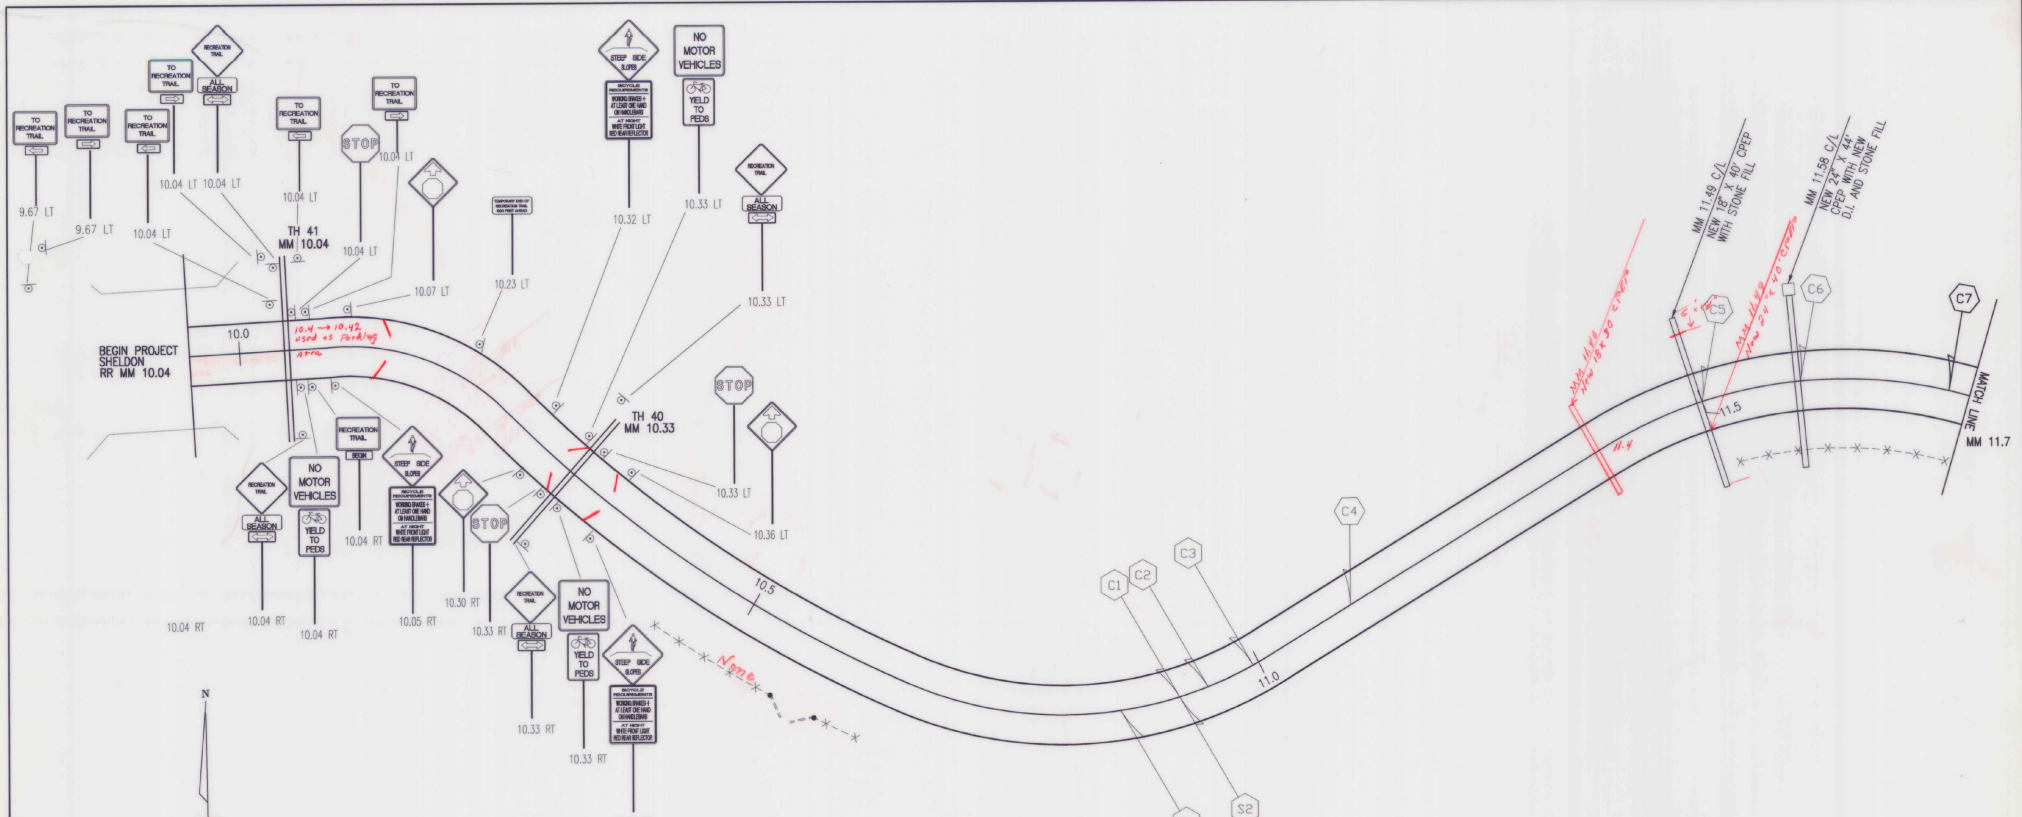


SOLID WASTE		
RR MM	IDENTIFIER	VOLUME & DESCRIPTION
10.77	S1	6 CY APPLIANCES
10.85	S2	6 CY HOUSEHOLD

**NOTES:**


1. THE TRANSPORTATION PATH RIGHT-OF-WAY IS APPROXIMATELY 50' EACH SIDE OF THE PATH CENTER. THIS SHALL BE THE LIMITS OF CONSTRUCTION
2. SEE SHEET 20 OF 43 FOR EXACT PLACEMENT OF SIGNS
3. THE RESIDENT ENGINEER SHALL BE RESPONSIBLE FOR COORDINATION WITH INDIVIDUAL LAND OWNERS TO VERIFY FENCE AND DRIVE GATE LOCATIONS AND INTEGRATION WITH EXISTING FENCE. EXISTING FENCE MAY BE LEFT IN PLACE AT THE REQUEST OF THE LAND OWNER. THE RESIDENT ENGINEER SHALL BE RESPONSIBLE FOR THE EXACT AMOUNT OF EXISTING FENCE REMOVAL AND FENCE INSTALLATION TO BE PAID TO THE CONTRACTOR.
4. SEE TABLE ON PROJECT LAYOUT SHEET (SHEET 5 OF 43) FOR CULVERT MILE MARKER (LOCATION)
5. SEE SHEET 19 OF 43 FOR TIMBER FENCE DETAIL.

**LEGEND**

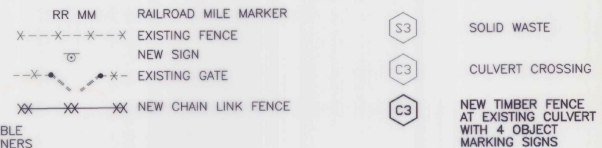

DATUM	
VERTICAL	N/A
HORIZONTAL	N/A

<b>LAYOUT SHEET #1</b>	SURVEYED BY	N/A	DATE	N/A
	DRAWN BY	JCL	DATE	12/20/95
MM 990 - MM 117	SQUAD LEADER	N/A		
	DESIGN FILE NO.	MAIN-LAY.DWG		
	IPARM FILE	DATE	3/27/96	
		FILE	PLOTTED	
	PROJ. NAME	SHELDON - RICHFORD TRANSPORTATION PATH		
	PROJ. NO.	STP BIKE (17) S		
		SHEET 9 OF 43 SHEETS		

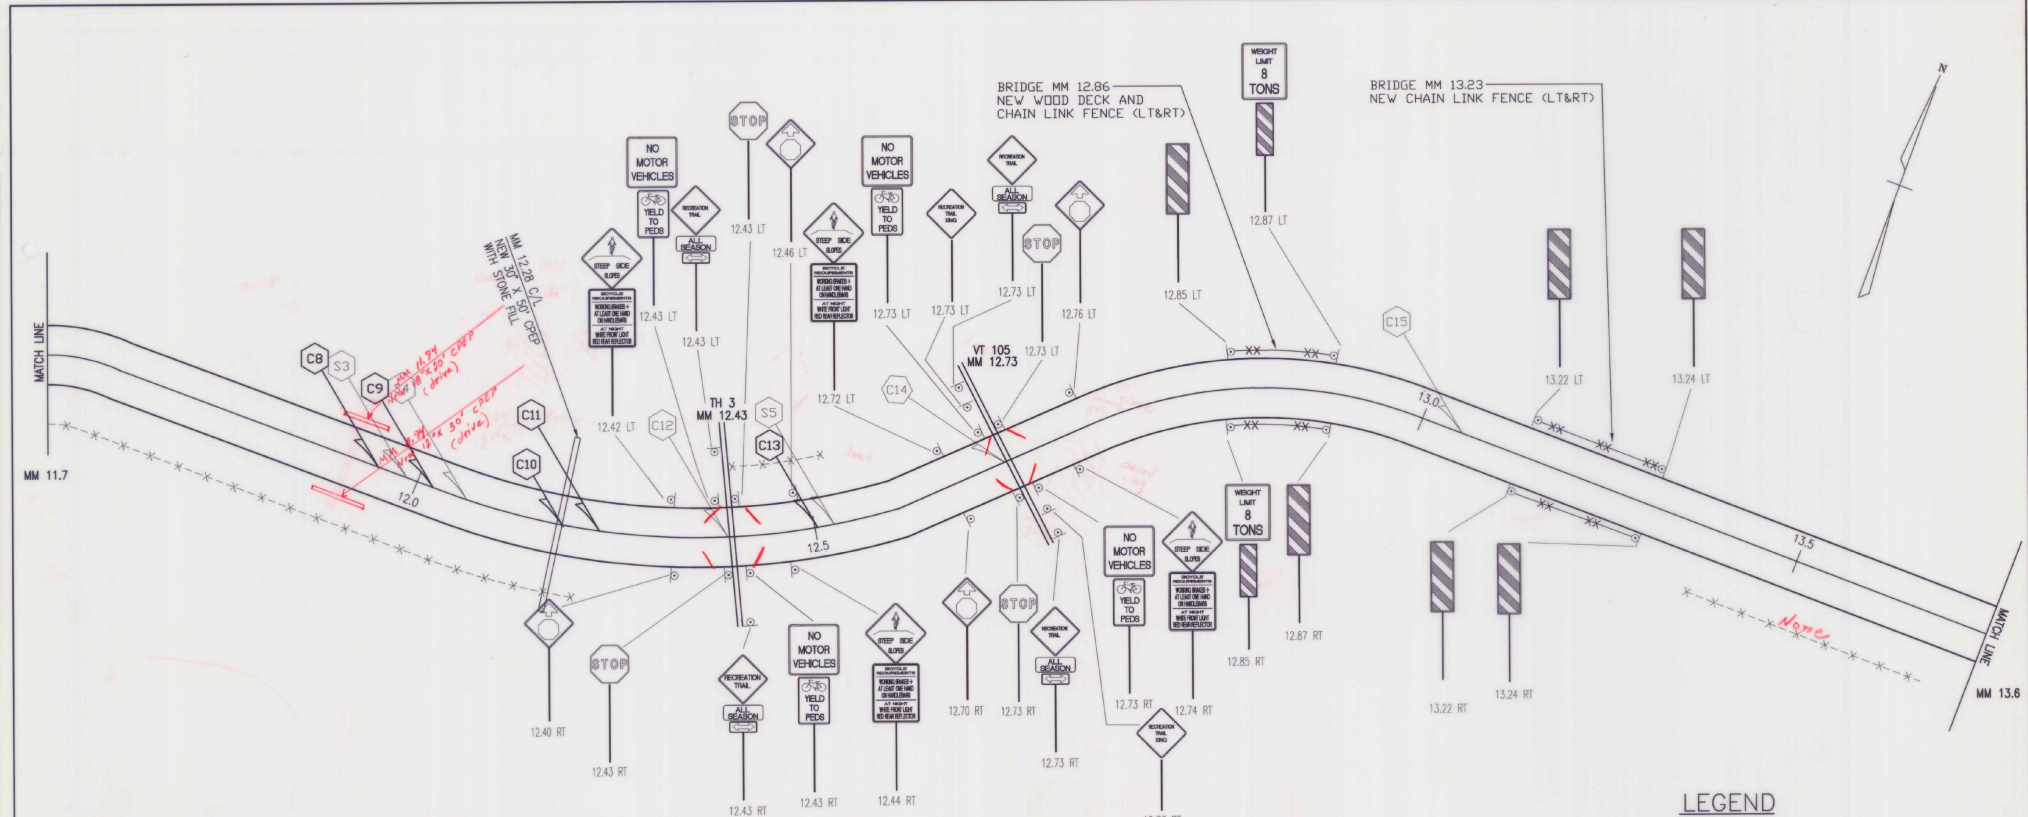

**LEGEND**

RR MM	RAILROAD MILE MARKER	S3	SOLID WASTE
---X---X---X---	EXISTING SIGN	C3	CULVERT CROSSING
---X---	NEW SIGN	C3	NEW TIMBER FENCE AT EXISTING CULVERT WITH 4 OBJECT MARKING SIGNS
-X-X-X-	EXISTING GATE		
XX XX XX	NEW CHAIN LINK FENCE		

- NOTES:**
1. THE TRANSPORTATION PATH RIGHT-OF-WAY IS APPROXIMATELY 50' EACH SIDE OF THE PATH CENTER. THIS SHALL BE THE LIMITS OF CONSTRUCTION
  2. SEE SHEET 20 OF 43 FOR EXACT PLACEMENT OF SIGNS
  3. THE RESIDENT ENGINEER SHALL BE RESPONSIBLE FOR COORDINATION WITH INDIVIDUAL LAND OWNERS TO VERIFY FENCE AND DRIVE GATE LOCATIONS AND INTEGRATION WITH EXISTING FENCE. EXISTING FENCE MAY BE LEFT IN PLACE AT THE REQUEST OF THE LAND OWNER. THE RESIDENT ENGINEER SHALL BE RESPONSIBLE FOR THE EXACT AMOUNT OF EXISTING FENCE REMOVAL AND FENCE INSTALLATION TO BE PAID TO THE CONTRACTOR.
  4. SEE TABLE ON PROJECT LAYOUT SHEET (SHEET 5 OF 43) FOR CULVERT MILE MARKER (LOCATION)
  5. SEE SHEET 18 OF 43 FOR WOOD DECK AND CHAIN LINK FENCE DIMENSIONS AND DETAILS
  6. SEE SHEET 19 OF 43 FOR TIMBER FENCE DETAIL


SOLID WASTE		
RR MM	IDENTIFIER	VOLUME & DESCRIPTION
11.94	S3	2 CY GARBAGE
12.09	S4	2 CY PICNIC TABLE DEBRIS
12.59	S5	2 CY DEBRIS

**LAYOUT SHEET #2**  
MM 11.7 - MM 13.6

SURVEYED BY	N/A	DATE	N/A
DRAWN BY	JCL	DATE	12/20/95
SQUAD LEADER	N/A		
DESIGN FILE NO.	MAIN-LAY.DWG		
IPARM FILE		DATE PLOTTED	3/27/96
PROJ. NAME	SHELDON - RICHFORD TRANSPORTATION PATH		
PROJ. NO.	STP BIKE (17) S		
SHEET	10 OF 43 SHEETS		

DATUM	
VERTICAL	N/A
HORIZONTAL	N/A

D:\LAYOUT\PROJECTS\2003\17 S - MM 11.7 - 13.6.DWG 1596 CAD PLOT FROM DMS DWG

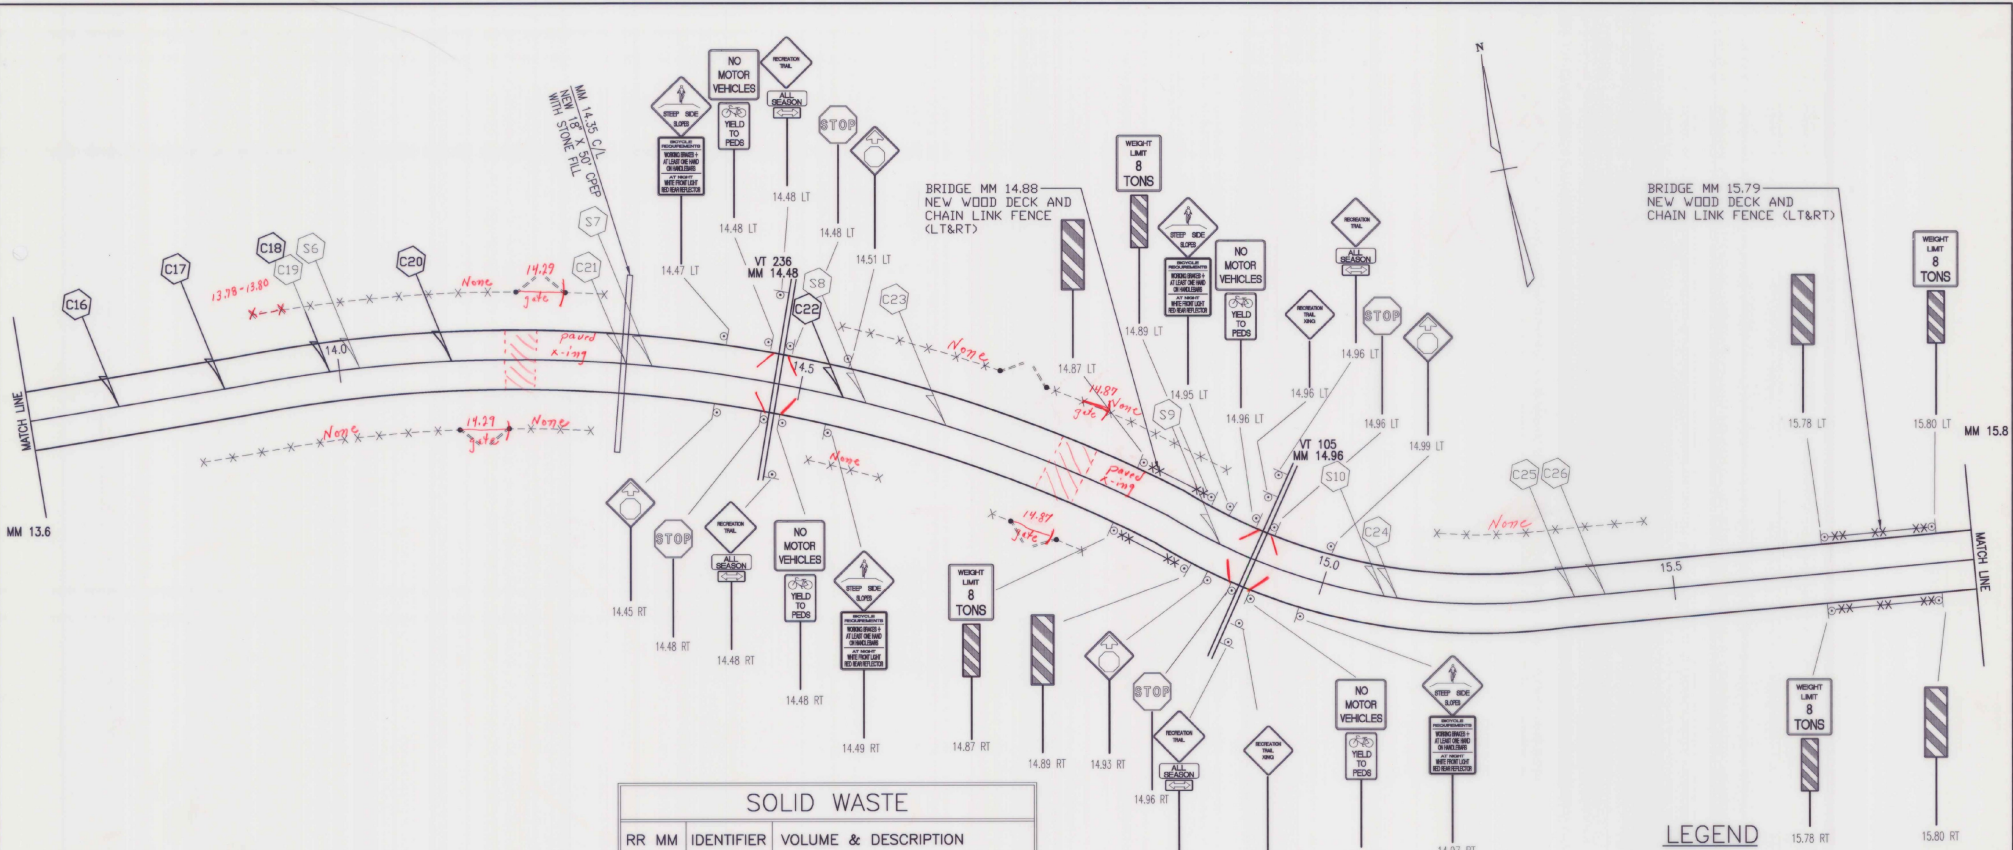


SOLID WASTE		
RR MM	IDENTIFIER	VOLUME & DESCRIPTION
14.09	S6	1 FALLEN TREE
14.40	S7	1 FALLEN TREE
14.59	S8	WOOD & BALER - FARMER'S ITEMS
14.95	S9	2 LF OF 41" CMP
15.12	S10	6 CY METAL APPLIANCES

**NOTES:**

1. THE TRANSPORTATION PATH RIGHT-OF-WAY IS APPROXIMATELY 50' EACH SIDE OF THE PATH CENTER. THIS SHALL BE THE LIMITS OF CONSTRUCTION
2. SEE SHEET 20 OF 43 FOR EXACT PLACEMENT OF SIGNS
3. THE RESIDENT ENGINEER SHALL BE RESPONSIBLE FOR COORDINATION WITH INDIVIDUAL LAND OWNERS TO VERIFY FENCE AND DRIVE GATE LOCATIONS AND INTEGRATION WITH EXISTING FENCE. EXISTING FENCE MAY BE LEFT IN PLACE AT THE REQUEST OF THE LAND OWNER. THE RESIDENT ENGINEER SHALL BE RESPONSIBLE FOR THE EXACT AMOUNT OF EXISTING FENCE REMOVAL AND FENCE INSTALLATION TO BE PAID TO THE CONTRACTOR.
4. SEE TABLE ON PROJECT LAYOUT SHEET (SHEET 5 OF 43) FOR CULVERT MILE MARKER (LOCATION)
5. SEE SHEET 18 OF 43 FOR WOOD DECK AND CHAIN LINK FENCE DIMENSIONS AND DETAILS
6. SEE SHEET 19 OF 43 FOR TIMBER FENCE DETAIL.

**LEGEND**

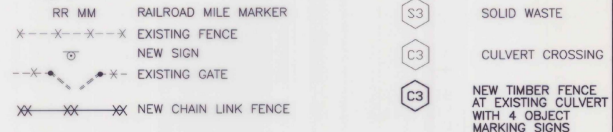


DATUM	
VERTICAL	N/A
HORIZONTAL	N/A

**LAYOUT SHEET #3**  
MM 13.6 - MM 15.8

SURVEYED BY	N/A	DATE	N/A
DRAWN BY	JCL	DATE	12/20/95
SQUAD LEADER	N/A		
DESIGN FILE NO.	MAIN-LAY.DWG		
IPBM FILE		DATE PLOTTED	3/27/96
PROJ. NAME	SHELDON - RICHFORD TRANSPORTATION PATH		
PROJ. NO.	STP BIKE (17) S		
SHEET	11 OF 43 SHEETS		



D:\DATA\PLANS\G07\LAY-5 Mod Aug 14 10:20:21 1996 CAD FILE FROM SHR.DWG

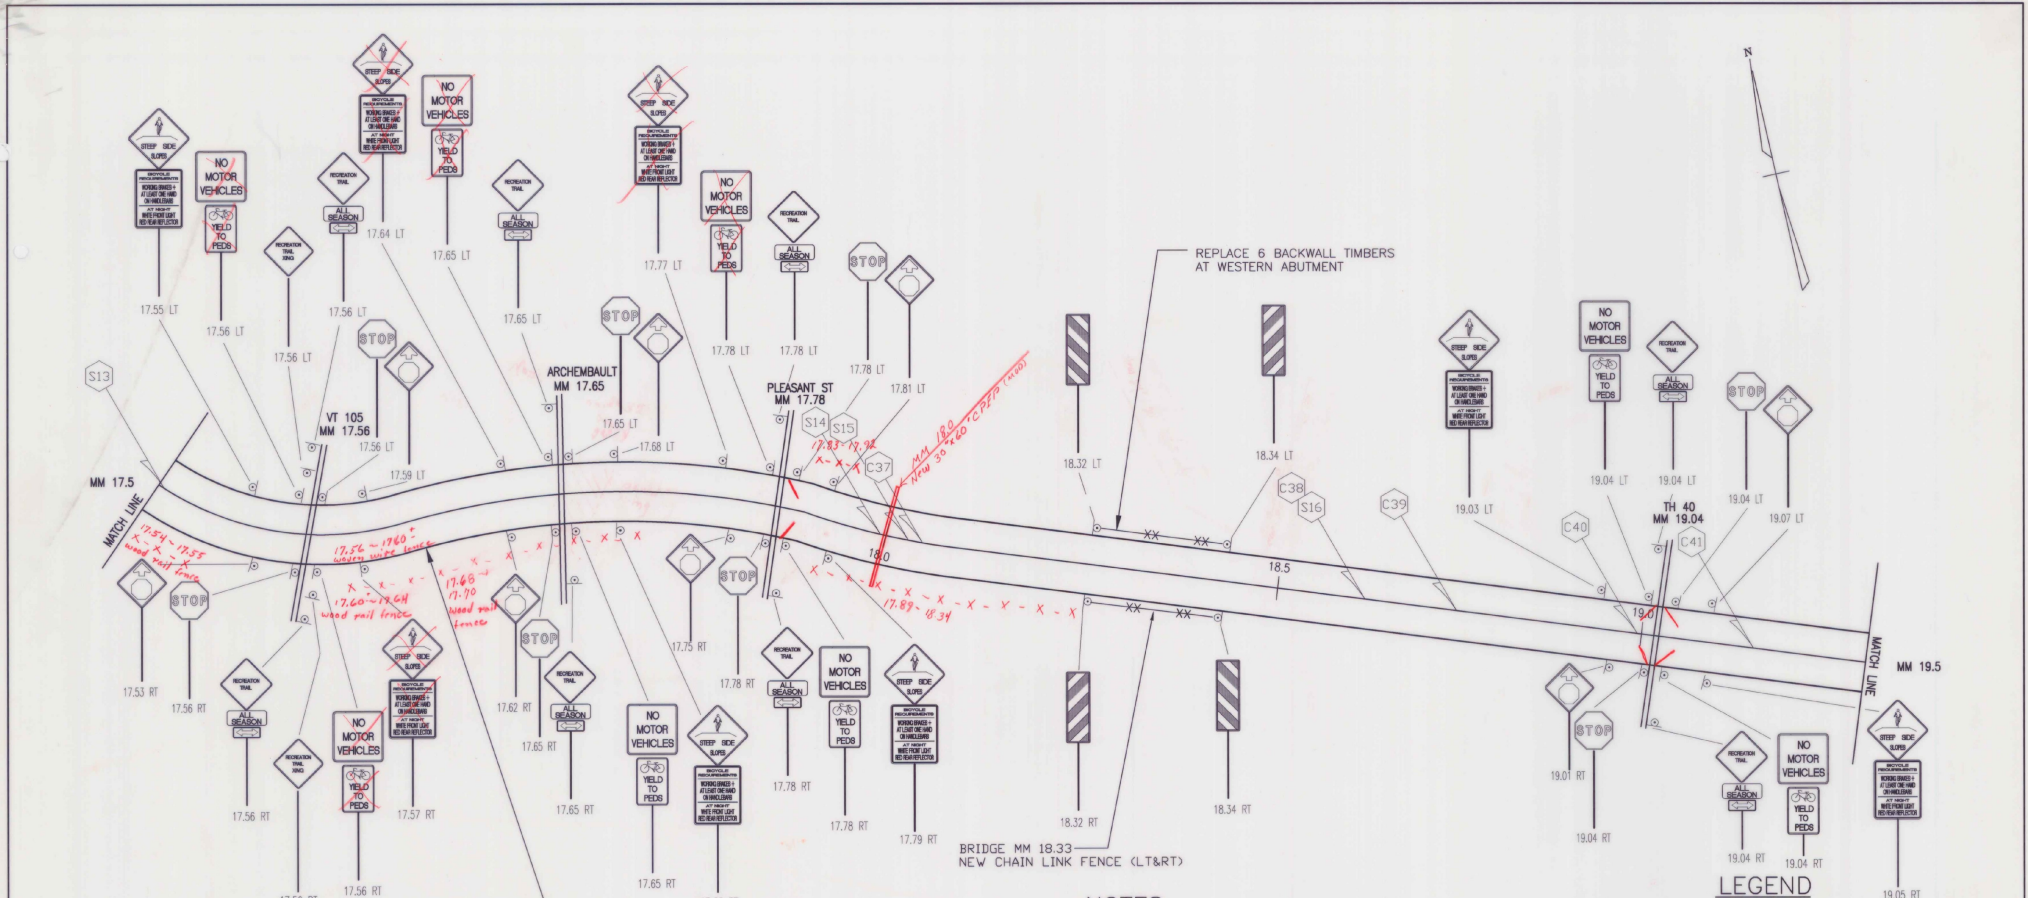


2" ASPHALT TRAIL SURFACE FROM MM 17.56 TO MM 17.78

SOLID WASTE		
RR MM	IDENTIFIER	VOLUME & DESCRIPTION
17.52	S13	DEBRIS - SHOP OWNER'S ITEMS
17.92	S14	2 CY FALLEN / CUT TREES
18.02	S15	2 50 GAL. DRUMS
18.64	S16	1 FULL SIZE REFRIGERATOR

**NOTES:**

- THE TRANSPORTATION PATH RIGHT-OF-WAY IS APPROXIMATELY 50' EACH SIDE OF THE PATH CENTER. THIS SHALL BE THE LIMITS OF CONSTRUCTION
- SEE SHEET 20 OF 43 FOR EXACT PLACEMENT OF SIGNS
- THE RESIDENT ENGINEER SHALL BE RESPONSIBLE FOR COORDINATION WITH INDIVIDUAL LAND OWNERS TO VERIFY FENCE AND DRIVE GATE LOCATIONS AND INTEGRATION WITH EXISTING FENCE. EXISTING FENCE MAY BE LEFT IN PLACE AT THE REQUEST OF THE LAND OWNER. THE RESIDENT ENGINEER SHALL BE RESPONSIBLE FOR THE EXACT AMOUNT OF EXISTING FENCE REMOVAL AND FENCE INSTALLATION TO BE PAID TO THE CONTRACTOR.
- SEE TABLE ON PROJECT LAYOUT SHEETS (SHEET 5-6 OF 43) FOR CULVERT MILE MARKER (LOCATION)
- SEE SHEET 18 OF 43 FOR WOOD DECK AND CHAIN LINK FENCE DIMENSIONS AND DETAILS

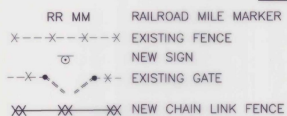


DATUM  
 VERTICAL N/A  
 HORIZONTAL N/A

**LAYOUT SHEET #5**  
 MM 17.5 - MM 19.5

SURVEYED BY	N/A	DATE	N/A
DRAWN BY	JCL	DATE	12/20/95
SQUAD LEADER	N/A		
DESIGN FILE NO.	MAIN-LAY.DWG		
PARM FILE		DATE PLOTTED	3/27/96
PROJ. NAME	SHELDON - RICHFORD TRANSPORTATION PATH		
PROJ. NO.	STP BIKE (17) S		
SHEET	13 OF 43 SHEETS		



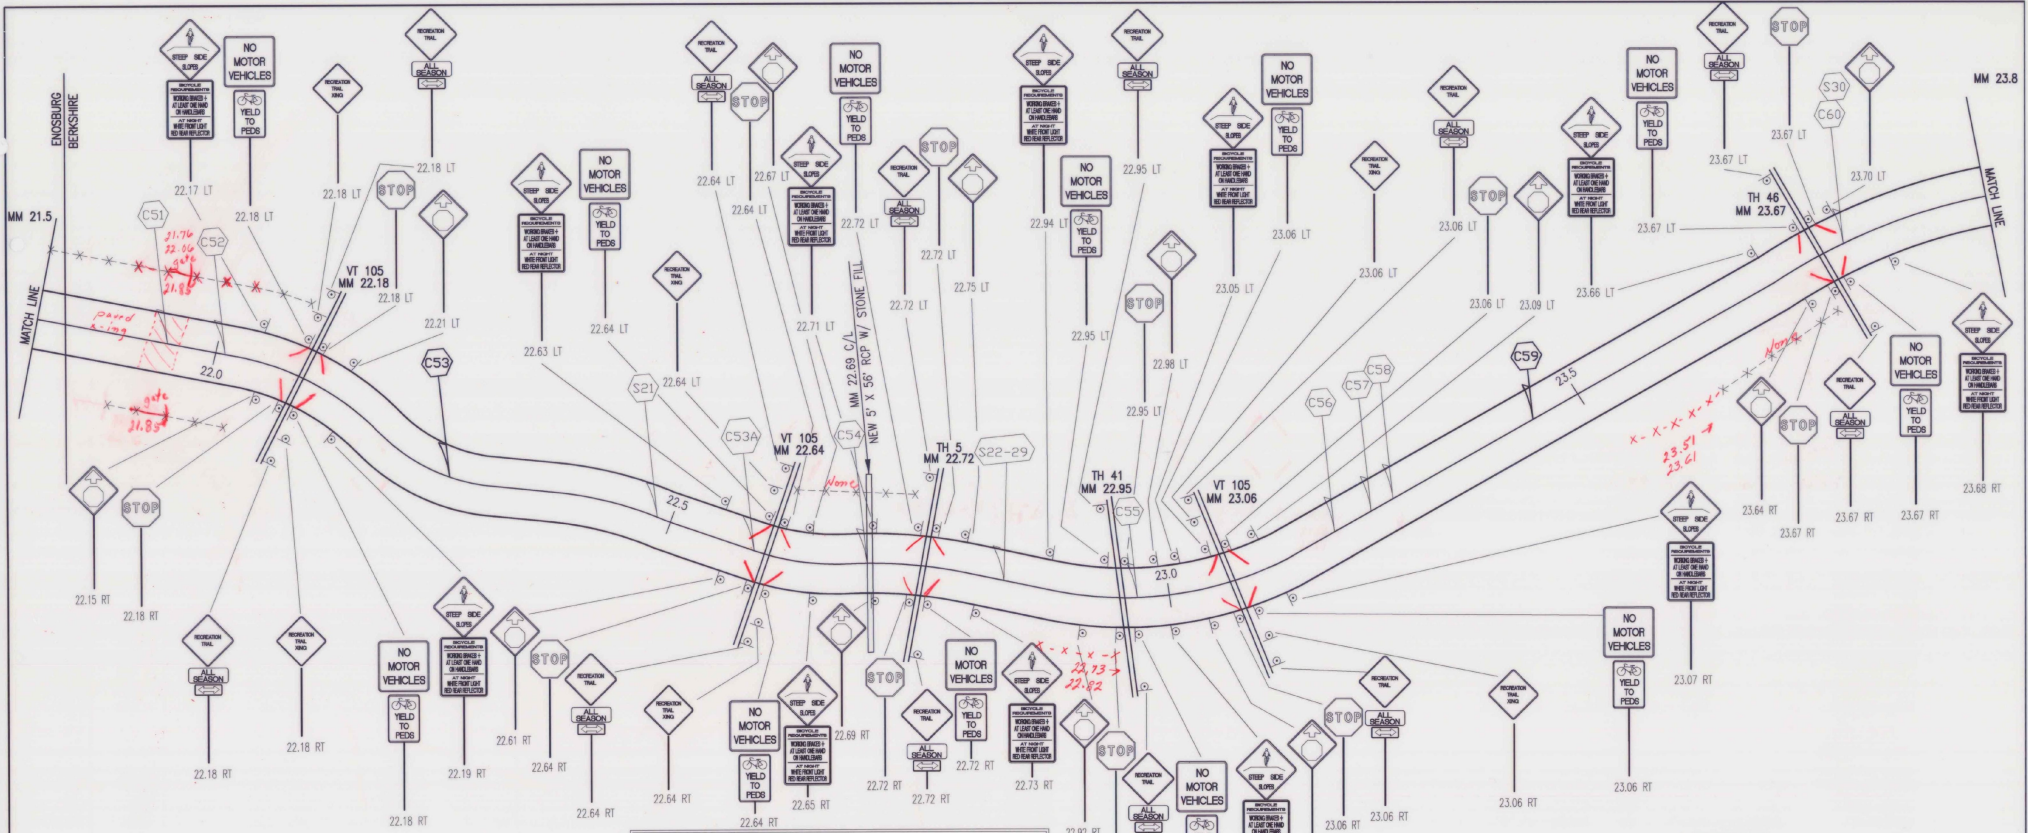

SOLID WASTE			
RR MM	IDENTIFIER	VOLUME & DESCRIPTION	
22.47	S21	6 CY AUTOMOTIVE DEBRIS	
22.76	S22	1 CY SET OF STEPS	
22.78	S23	50 GAL. DRUM	
22.81	S24	6 CY PAINT CANS (30), WOOD DEBRIS	
22.82	S25	2 CY WOOD DEBRIS	
22.85	S26	2 CY WOOD DEBRIS, 50 GAL. DRUM	
22.86	S27	2 CY MULCH, CONC. BLOCKS, TIRES	
22.88	S28	6 CY CANS, WOOD, TIRES	
22.89	S29	3 50 GAL. DRUMS, BRANCHES, FRAME	
23.70	S30	1/2 50 GAL. DRUM	

**LEGEND**

RR MM RAILROAD MILE MARKER  
 -x-x-x-x-x- EXISTING FENCE  
 ⊕ NEW SIGN  
 -x-x-x-x- EXISTING GATE  
 XX-XX-XX NEW CHAIN LINK FENCE

S3 SOLID WASTE  
 C3 CULVERT CROSSING  
 C3 NEW TIMBER FENCE AT EXISTING CULVERT WITH 4 OBJECT MARKING SIGNS

- NOTES:**
1. THE TRANSPORTATION PATH RIGHT-OF-WAY IS APPROXIMATELY 50' EACH SIDE OF THE PATH CENTER. THIS SHALL BE THE LIMITS OF CONSTRUCTION
  2. SEE SHEET 20 OF 43 FOR EXACT PLACEMENT OF SIGNS
  3. THE RESIDENT ENGINEER SHALL BE RESPONSIBLE FOR COORDINATION WITH INDIVIDUAL LAND OWNERS TO VERIFY FENCE AND DRIVE GATE LOCATIONS AND INTEGRATION WITH EXISTING FENCE. EXISTING FENCE MAY BE LEFT IN PLACE AT THE REQUEST OF THE LAND OWNER. THE RESIDENT ENGINEER SHALL BE RESPONSIBLE FOR THE EXACT AMOUNT OF EXISTING FENCE REMOVAL AND FENCE INSTALLATION TO BE PAID TO THE CONTRACTOR.
  4. SEE TABLE ON PROJECT LAYOUT SHEET (SHEET 6 OF 43) FOR CULVERT MILE MARKER (LOCATION)
  5. SEE SHEET 19 OF 43 FOR TIMBER FENCE DETAIL.

**LAYOUT SHEET #7**  
 MM 215 - MM 238


SURVEYED BY N/A DATE N/A  
 DRAWN BY JCL DATE 12/20/95  
 SQUAD LEADER N/A  
 DESIGN FILE NO. MAIN-LAY.DWG  
 PLOT FILE DATE PLOTTED 3/27/96

PROJ. NAME SHELDON - RICHFORD TRANSPORTATION PATH  
 PROJ. NO. STP BIKE (17) S  
 SHEET 15 OF 43 SHEETS

DATUM  
 VERTICAL N/A  
 HORIZONTAL N/A

LAY-7 Thu Aug 15 07:26:40 1996 CADD PLOT: "S" SDR Comp



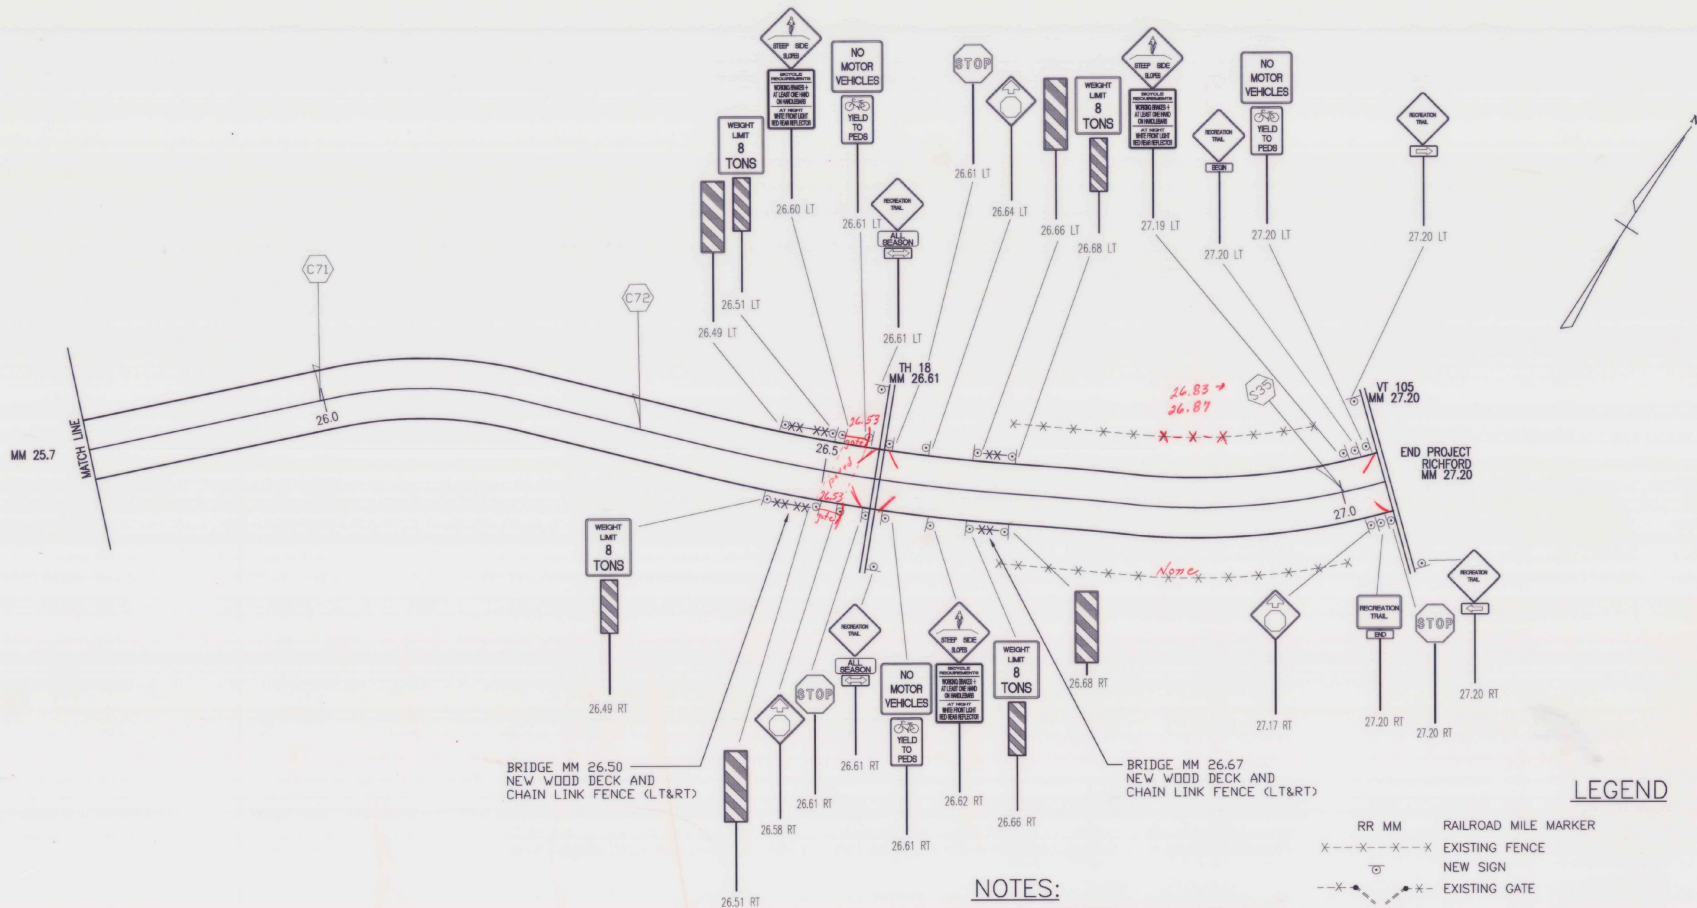

**LEGEND**

- RR MM RAILROAD MILE MARKER
- X-X-X-X EXISTING FENCE
- NEW SIGN
- EXISTING GATE
- NEW CHAIN LINK FENCE
- S3 SOLID WASTE
- C3 CULVERT CROSSING

**NOTES:**




1. THE TRANSPORTATION PATH RIGHT-OF-WAY IS APPROXIMATELY 50' EACH SIDE OF THE PATH CENTER. THIS SHALL BE THE LIMITS OF CONSTRUCTION
2. SEE SHEET 20 OF 43 FOR EXACT PLACEMENT OF SIGNS
3. THE RESIDENT ENGINEER SHALL BE RESPONSIBLE FOR COORDINATION WITH INDIVIDUAL LAND OWNERS TO VERIFY FENCE AND DRIVE GATE LOCATIONS AND INTEGRATION WITH EXISTING FENCE. EXISTING FENCE MAY BE LEFT IN PLACE AT THE REQUEST OF THE LAND OWNER. THE RESIDENT ENGINEER SHALL BE RESPONSIBLE FOR THE EXACT AMOUNT OF EXISTING FENCE REMOVAL AND FENCE INSTALLATION TO BE PAID TO THE CONTRACTOR.
4. SEE TABLE ON PROJECT LAYOUT SHEET (SHEET 6 OF 43) FOR CULVERT MILE MARKER (LOCATION)
5. SEE SHEET 18 OF 43 FOR WOOD DECK AND CHAIN LINK FENCE DIMENSIONS AND DETAILS

SOLID WASTE		
RR MM	IDENTIFIER	VOLUME & DESCRIPTION
27.06	S35	2 CY PLASTIC BARRELS, METAL




DATUM	
VERTICAL	N/A
HORIZONTAL	N/A

<b>LAYOUT SHEET #9</b>	
MM 257 - MM 272	
SURVEYED BY	N/A DATE N/A
DRAWN BY	JCL DATE 12/20/95
SQUAD LEADER	N/A
DESIGN FILE NO.	MAIN-LAY.DWG
DATE PLOTTED	3/27/96
PROJ. NAME	SHELDON - RICHFORD TRANSPORTATION PATH
PROJ. NO.	STP BIKE (17) S
SHEET 17	OF 43 SHEETS

D:\MVP\1034589\31\1034589\_31.dwg Thu Aug 15 10:40:30 1996 CAD Plot From 386 Comp

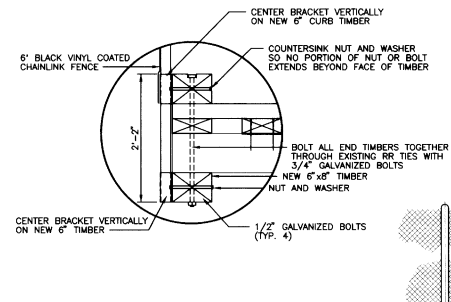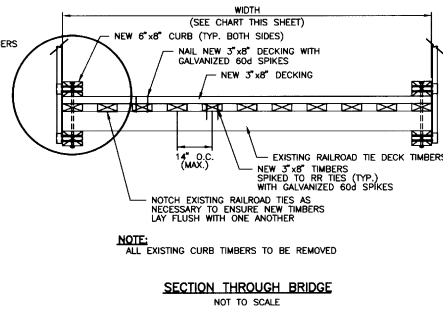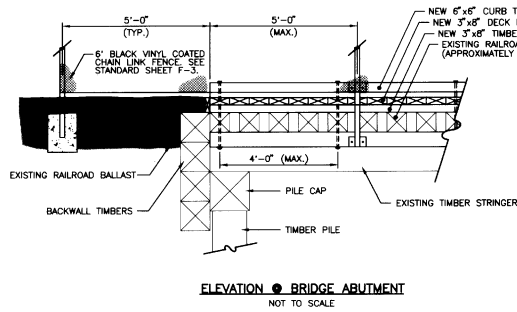




**DECK TYPE A**

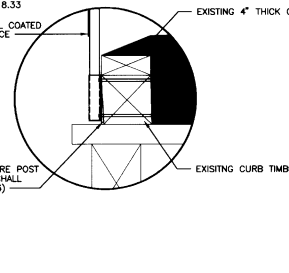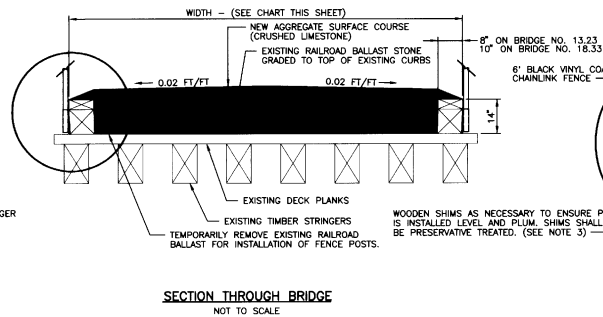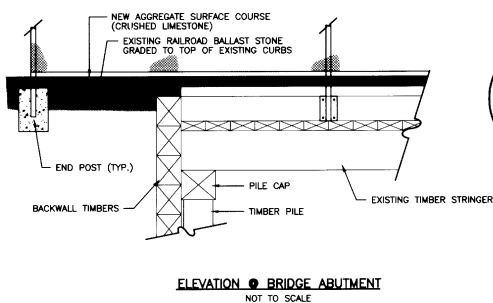

**DECK TYPE B**

BRIDGE DATA						
BRIDGE NO.	BRIDGE TYPE	LENGTH	WIDTH	DECK TYPE	EXISTING CURB	
12.86	SINGLE SPAN TIMBER	24'-0"	12'-0"	A	N	
13.23	FIVE SPAN TIMBER	62'-10"	12'-0"	B	Y	
14.88	SINGLE SPAN STEEL STEEL STRINGERS	24'-0"	12'-0"	A	Y	
15.79	SINGLE SPAN TIMBER	72'-0"	12'-0"	A	Y	
17.51	SIX SPAN TIMBER	85'-0"	12'-0"	A	Y	
18.33	THREE SPAN TIMBER	38'-0"	13'-2"	B	Y	
24.31	SINGLE SPAN STEEL TRUSS	142'-0"	18'-4"	A	Y	
26.50	SINGLE SPAN STEEL GIRDER	39'-9"	12'-1"	A	Y	
26.67	TWO SPAN TIMBER	26'-9"	12'-0"	A	Y	

**NOTE:**  
BRIDGE NOS. 14.88, 24.31 AND 26.50 HAVE STEEL STRINGERS OR GIRDERS UNDER THE RAILROAD THE TIMBER DECK. USE DETAILS FOR DECK TYPE A FOR THESE BRIDGES.

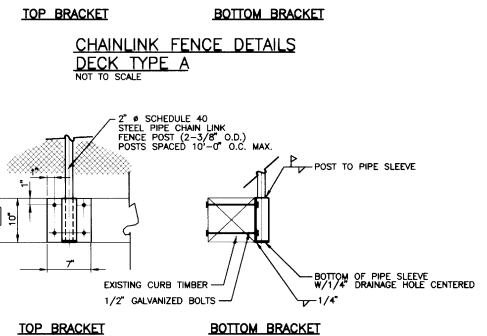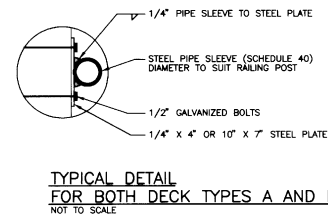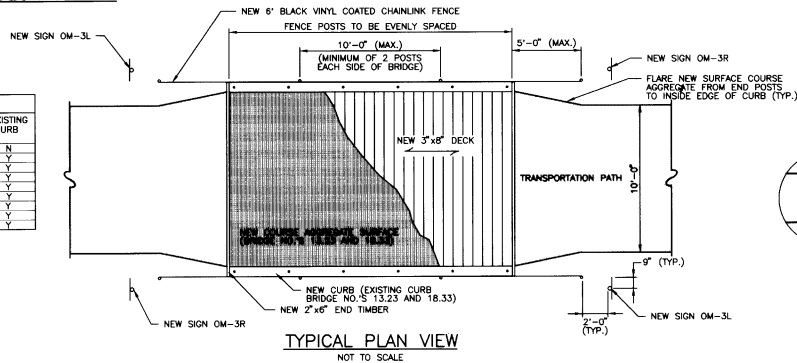


**GENERAL NOTES**

1. ALL WORK SHOWN ON THIS SHEET EXCEPT CHAIN LINK FENCE, AGGREGATE FOR SURFACE COURSE AND WORK RELATED TO NOTE 7 BELOW, SHALL BE PAID UNDER ITEM 522.25, STRUCTURAL LUMBER AND TIMBER - TREATED.
2. FIELD WELDS SHALL BE CLEANED AND PAINTED WITH TWO COATS OF ZINC RICH (GALVANIZED) COATING, PER SUBSECTION 708.02(D). PROTECT ALL EXPOSED TIMBERS FROM PAINT OVER-SPRAY.
3. ALL LUMBER AND TIMBER SHALL BE PRESERVATIVE TREATED WITH PRESERVATIVE TYPE IV, PER SUBSECTION 726.01.
4. ALL LUMBER AND TIMBER SHALL BE SOUTHERN PINE, COASTAL DOUGLAS FIR, WESTERN HEMLOCK OR OTHER EASTERN (LOCAL) MATERIAL OF SELECT STRUCTURAL GRADE MEETING A MINIMUM FIBER STRESS IN BENDING ABOUT EITHER AXIS OF 1,200 PSI.
5. ALL LUMBER SHALL BE FULL SIZE TO THE DIMENSIONS SHOWN.
6. SEVERAL OF THE UPPER BACKWALL TIMBERS (10'X12" X VARIABLE LENGTH OF 13' TO 18') ON BRIDGE NO. 18.33 ARE ROTTED OR DAMAGED. SOME OF THESE TIMBERS SHALL BE REPLACED AS DIRECTED BY THE RESIDENT ENGINEER AND BE PAID UNDER ITEM NO. 522.25 STRUCTURAL LUMBER AND TIMBER-TREATED.

DATUM	
VERTICAL	N/A
HORIZONTAL	N/A

<b>BRIDGE DETAIL SHEET</b>	
SURVEYED BY	N/A
DRAWN BY	CDM
SQUAD LEADER	N/A
DATE	N/A
DATE	3/6/96
DESIGN FILE NO.	
IPARM FILE	
DATE PLOTTED	3/6/96
PROJ. NAME	SHELDON-RICHFORD TRANSPORTATION PATH
PROJ. NO.	STP BIKE (17) S
SHEET	18 OF 43 SHEETS

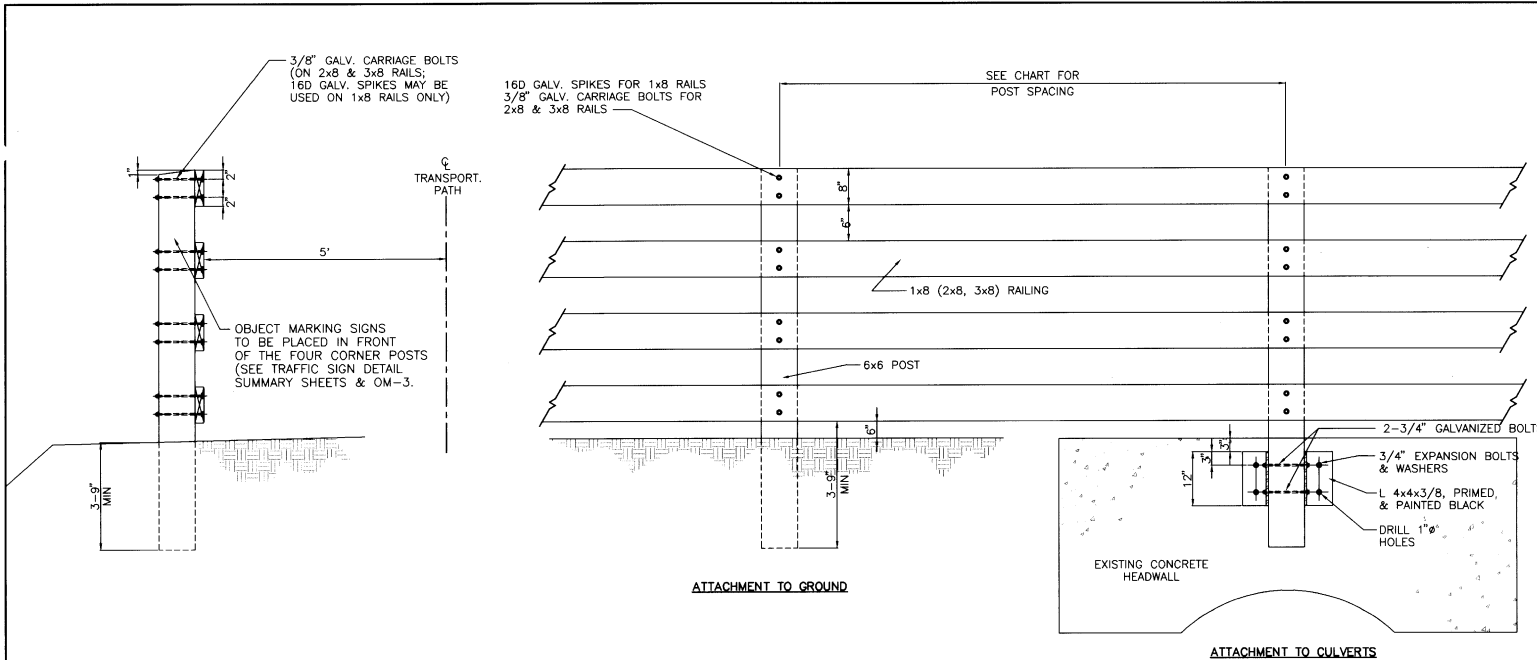

**GENERAL NOTES**

1. ALL WORK SHOWN ON THIS SHEET SHALL BE PAID UNDER ITEM 522.25, STRUCTURAL LUMBER AND TIMBER - TREATED.
2. ALL LUMBER AND TIMBER SHALL BE PRESERVATIVE TREATED WITH PRESERVATIVE TYPE IV, PER SUBSECTION 726.01
3. ALL LUMBER AND TIMBER SHALL BE SOUTHERN PINE, COASTAL DOUGLAS FIR, WESTERN HEMLOCK, OR OTHER EASTERN (LOCAL) MATERIAL OF SELECT STRUCTURAL GRADE MEETING A MINIMUM AXIS OF 1,200 PSI.
4. ALL LUMBER SHALL BE NOMINAL PLANED SIZE.
5. QUANTITY FOR TIMBER FENCE BASED ON AVERAGE LENGTH OF 12 FEET AT 6 FOOT POST SPACING. ACTUAL FENCE PLACEMENTS AS DIRECTED BY THE RESIDENT ENGINEER.

RAIL SIZE	MAXIMUM POST SPACING
1 x 8 (N)	3'
2 x 8 (N)	6'
3 x 8 (N)	12'

N - NOMINAL LUMBER SIZE (PLANED); ie: 2 x 8 ACTUALLY IS 1 3/4" x 7 1/2".

TYPICAL FENCE DETAIL INSTALLATION

SEGMENT 1 TABLE

MILE MARKER	LENGTH OF FENCE +	NOTES
MM 3.15±	12'	
MM 3.27	12'	
MM 3.55	12'	
MM 4.31	12'	
MM 4.90	20'	NOTE: EXISTING TIMBER FENCE REPLACE RAILS ONLY
MM 6.36	12'	
MM 7.45	12'	
MM 9.40	12'	

+ SEE NOTE #5

DATUM	
VERTICAL	N/A
HORIZONTAL	N/A



PLAN NOT TO SCALE

**FENCE DETAILS**

SURVEYED BY N/A DATE N/A  
 DRAWN BY SMR DATE 7/15/96  
 SQUAD LEADER N/A  
 DESIGN FILE NO. FEN-DET  
 I/PARM FILE DATE PLOTTED 7/15/96  
 PROJ. NAME SHELDON-RICHFORD TRANSPORTATION PATH  
 PROJ. NO. STP BIKE (17) S  
 SHEET 19 of 43 SHEETS

NOTE: RECREATION TRAIL BEGIN AND END SIGNS APPLY ONLY TO CROSSINGS AT RR MM 10.04, AND 27.20

NOTE: DIMENSIONS NOT SHOWN ASSUMED TO BE SYMMETRICAL TO SIGNS ON OPPOSITE SIDE OF HIGHWAY OR PATH.

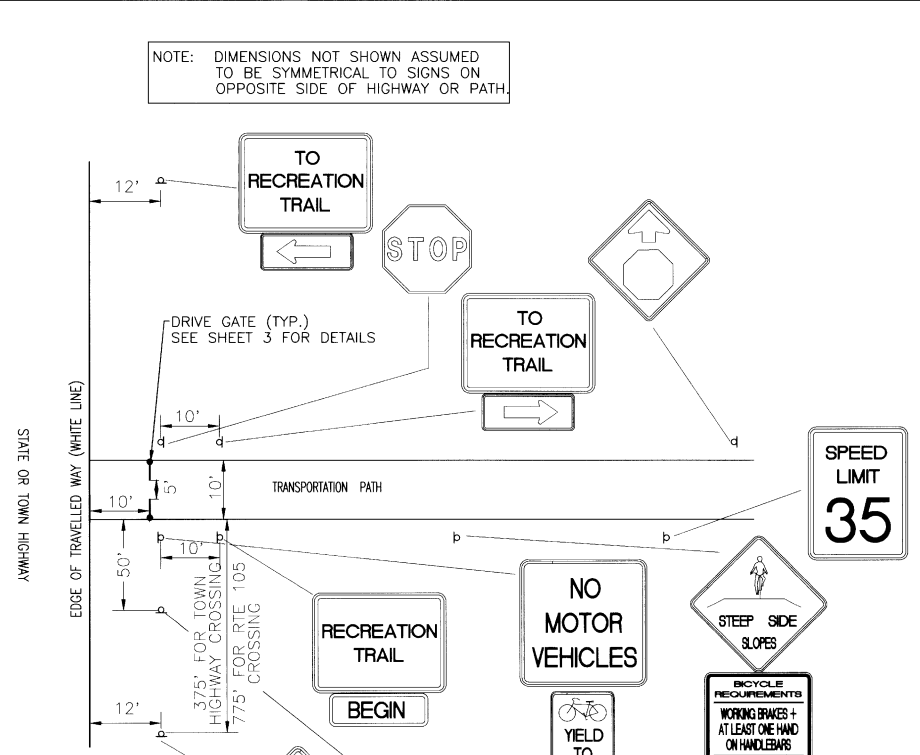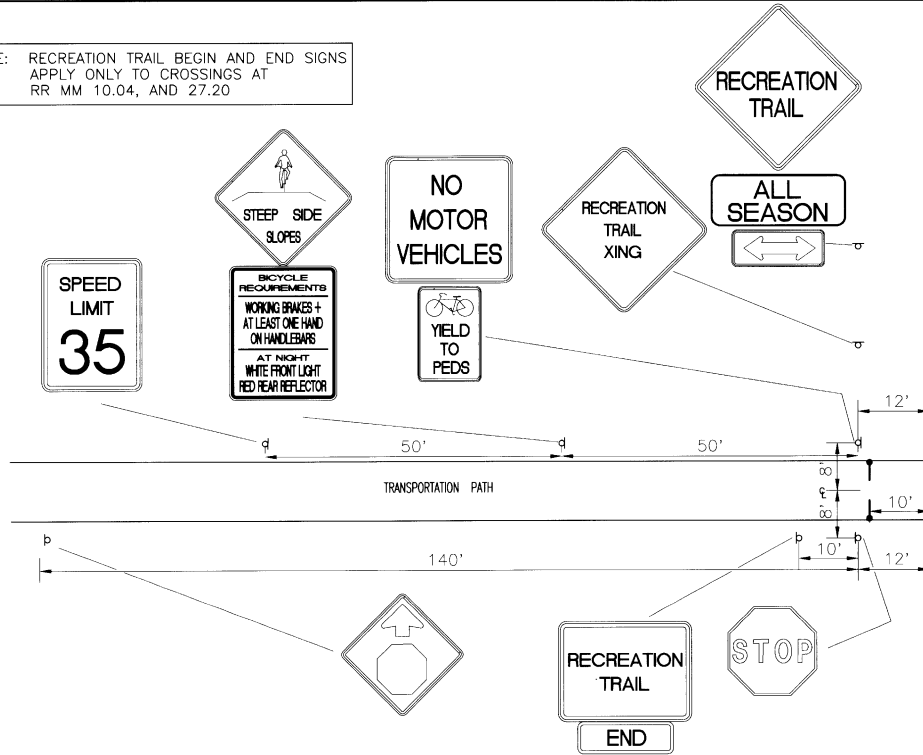

**TYPICAL TRAFFIC SIGN PLACEMENT**  
NOT TO SCALE

**NOTES:**


1. RESIDENT ENGINEER SHALL VERIFY IN THE FIELD THE PLACEMENT AND LOCATION OF ALL SIGNS PRIOR TO THE CONTRACTOR INSTALLING THEM
2. SEE SHEET 21 OF 43 FOR TRAFFIC SIGN DETAILS.
3. ATTACH BICYCLE REQUIREMENT SIGN TO SPEED LIMIT SIGN POST INSTEAD OF THE STEEP SIDE SLOPE SIGN POST AS SHOWN ON PLANS.
4. SPEED LIMIT SIGNS TO BE PLACED AT THE FOLLOWING LOCATIONS:

RR MM 9.90	RR MM 17.45	RR MM 21.46	RR MM 24.36
RR MM 10.04	RR MM 17.56	RR MM 22.18	RR MM 24.88
RR MM 10.33	RR MM 17.65	RR MM 22.64	RR MM 26.61
RR MM 12.43	RR MM 17.78	RR MM 22.72	
RR MM 12.73	RR MM 19.04	RR MM 22.95	
RR MM 14.48	RR MM 19.94	RR MM 23.06	
RR MM 14.96	RR MM 20.42	RR MM 23.67	
RR MM 16.91	RR MM 21.36	RR MM 24.21	

DATUM	
VERTICAL	N/A
HORIZONTAL	N/A


**TYPICAL TRAFFIC SIGN PLACEMENT**

SURVEYED BY	N/A	DATE	N/A
DRAWN BY	SDT	DATE	3/6/96
SQUAD LEADER	N/A		
DESIGN FILE NO.			
IPARM FILE	TRAFFIC.DWG	DATE PLOTTED	3/27/96
PROJ. NAME	SHELDON-RICHFORD TRANSPORTATION PATH		
PROJ. NO.	STP BIKE (17) S		
SHEET	20	OF	43 SHEETS

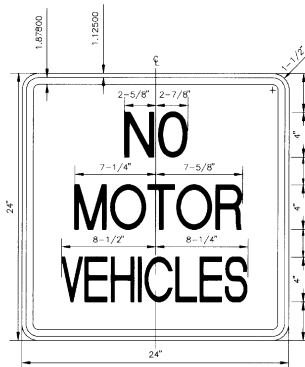

**SIGN DETAIL R5-3**  
NOT TO SCALE


**COLORS FOR R5-3**  
LEGEND: BLACK (NON-REFL.)  
BACKGROUND: WHITE (REFL.)

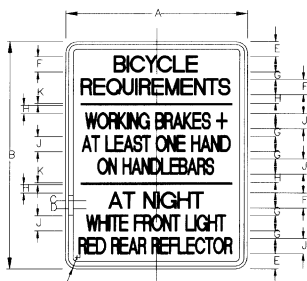


**SIGN DETAIL VR-043**  
NOT TO SCALE  
**COLORS FOR VR-043**  
LEGEND & BORDER: BLACK(NON-REFLECTORIZED)  
BACKGROUND: WHITE(REFLECTORIZED)

note : for specification refer to std E-140


DIMENSIONS (INCHES)							
SIGN STD.	A	B	C	D	E	F	G
	24	30	3/8	5/8	2	2-1/4	I
SIGN STD.	H	J	K	AA			
	1-1/8	2-1/4	1/4	1-1/2			

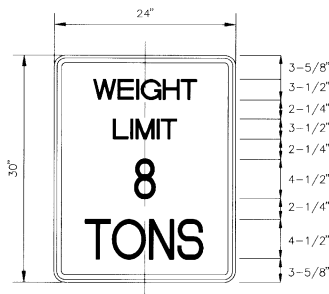


**SIGN DETAIL R12-1**  
NOT TO SCALE  
**COLORS FOR R12-1**  
LEGEND: BLACK (NON-REFLECTORIZED)  
BACKGROUND: WHITE (REFLECTORIZED)

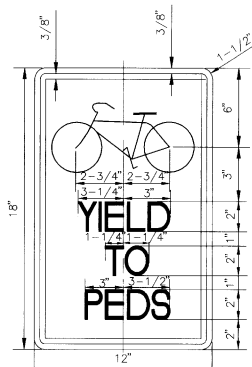


**SIGN DETAIL R9-6**  
NOT TO SCALE  
**COLORS FOR R9-6**  
LEGEND: BLACK  
BACKGROUND: WHITE (REFL.)

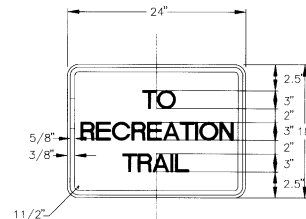


**SIGN DETAIL VBS-5**  
NOT TO SCALE  
**COLORS FOR VBS-5**  
LEGEND & BORDER: WHITE(REFLECTORIZED)  
BACKGROUND: GREEN(REFLECTORIZED)

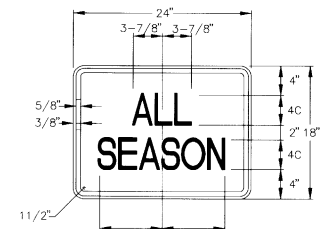


**SIGN DETAIL VW-622p**  
NOT TO SCALE  
**COLORS FOR VW-622p**  
LEGEND & BORDER: BLACK(NON-REFLECTORIZED)  
BACKGROUND: YELLOW(REFLECTORIZED)  
note : for specification refer to std E-152

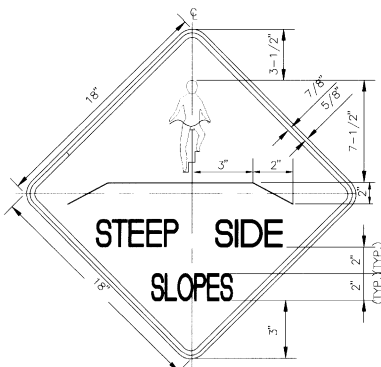


**SIGN DETAIL VBS-1**  
NOT TO SCALE

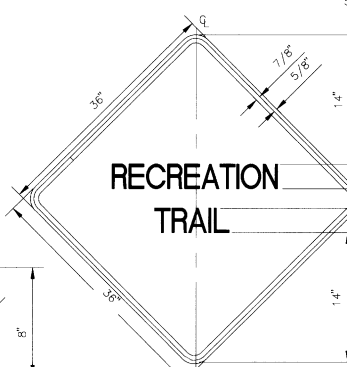


**SIGN DETAIL VBS-2**  
NOT TO SCALE

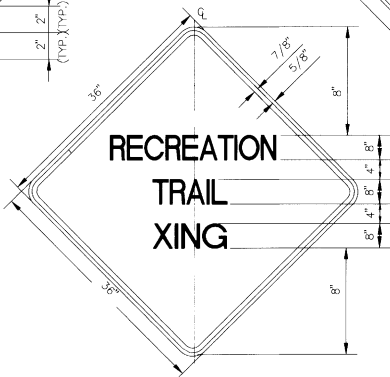



**SIGN DETAIL VBS-4**  
NOT TO SCALE  
**COLORS FOR VBS-1, VBS-2, VBS-4:**  
LEGEND: BLACK  
BACKGROUND: YELLOW (REFL.)

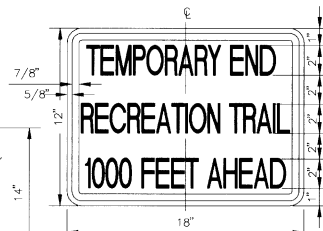

**SIGN DETAIL VBS-3**  
NOT TO SCALE  
**COLORS FOR VBS-3**  
LEGEND: BLACK  
BACKGROUND: YELLOW (REFL.)

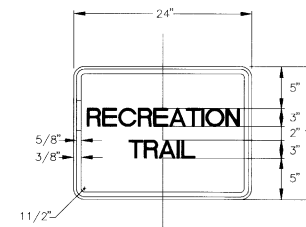


**SIGN DETAIL VBS-5**  
NOT TO SCALE  
**COLORS FOR VBS-5**  
LEGEND & BORDER: WHITE(REFLECTORIZED)  
BACKGROUND: GREEN(REFLECTORIZED)

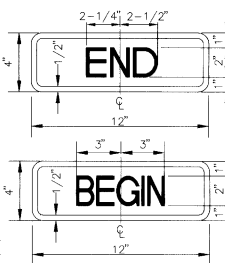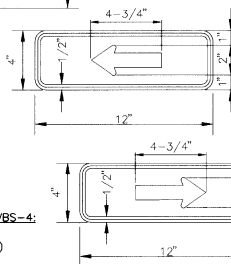

**SIGN DETAIL M4-12**  
NOT TO SCALE

**COLORS FOR M4-11 & M4-12:**  
LEGEND: WHITE (REFL.)  
BACKGROUND: GREEN (REFL.)

**SIGN DETAIL M4-11**  
NOT TO SCALE

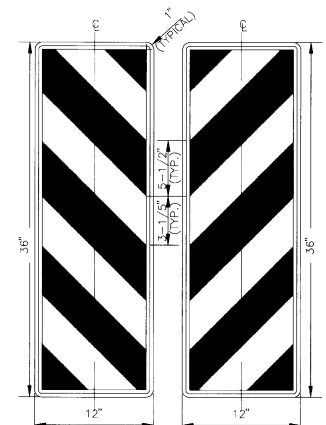

**COLORS FOR OM-3L & OM-3R:**  
WIDE STRIPE: BLACK  
NARROW STRIPE: YELLOW (REFL.)

NOTE: ALL BORDERS SAME COLOR AS LEGEND

DATUM	
VERTICAL	N/A
HORIZONTAL	N/A

**TRAFFIC SIGN DETAILS**

SURVEYED BY	N/A	DATE	N/A
DRAWN BY	SDT	DATE	3/6/96
SQUAD LEADER	N/A		
DESIGN FILE NO.	SIGN-DET		
PARM FILE		DATE PLOTTED	3/27/96
PROJ. NAME	SHELDON-RICHFORD TRANSPORTATION PATH		
PROJ. NO.	STP BIKE (17) S		
SHEET	21 OF 43 SHEETS		

TRAFFIC SIGN SUMMARY SHEET

MILEMARKER, STATION, OR SIGN NUMBER	SIGN LEGEND	SIGN DIMENSIONS	NEW AND SALVAGED SIGNS				EXIST. POSTS			NEW SIGN POSTS													REMARKS	SIGN DETAIL				
			AREA	M.U.T.C.D. NO.	SALV. SIGN	SALV. T.I.S.	RET.	SALV.	NO. OF POSTS	FLANGED CHANNEL LB./FT.			TUBULAR ALUMINUM		TUBULAR STEEL				W-SHAPE STEEL		FTG. SIZE			SIGN FRAME	DETAIL ON SHEET NUMBER	STD. SHEET NUMBER		
										1.12	2.0	3.0	3.0"Ø	4.0"Ø	FOUND-ATION	3"Ø	3.5"Ø	4.0"Ø	5.0"Ø	POST SIZE	WEIGHT	24"					30"	
MM 10.04 LT		24' x 18' 12' x 4'	3.33									X													SEE SHEET 20 FOR SIGN PLACEMENT DIMENSIONS	21		
MM 10.04 LT		24' x 18' 12' x 4'	3.33																						SEE SHEET 20 FOR SIGN PLACEMENT DIMENSIONS	21		
MM 10.04 LT		24' x 18' 12' x 4'	3.33									X													SEE SHEET 20 FOR SIGN PLACEMENT DIMENSIONS	21		
MM 10.04 LT		24' x 18' 12' x 4'	3.33									X													SEE SHEET 20 FOR SIGN PLACEMENT DIMENSIONS	21		
MM 10.04 LT		36' x 36' 24' x 18' 24' x 12'	14	W1-7									X												SEE SHEET 20 FOR SIGN PLACEMENT DIMENSIONS	21	E-152	
MM 10.23 LT		18' x 12'	1.5									X													SEE SHEET 20 FOR SIGN PLACEMENT DIMENSIONS		E-143	
MM 10.04 RT		36' x 36' 24' x 18' 24' x 12'	14	W1-7									X												SEE SHEET 20 FOR SIGN PLACEMENT DIMENSIONS	21	E-152	
MM 10.04 RT		24' x 24' 12' x 18'	5.5	R5-3 R9-6										X											SEE SHEET 20 FOR SIGN PLACEMENT DIMENSIONS			
MM 10.04 RT		24' x 18' 12' x 4'	3.33	M4-11								X													SEE SHEET 20 FOR SIGN PLACEMENT DIMENSIONS	21		
MM 10.04 LT		18' x 18'	3.75	R1-1								X													SEE SHEET 20 FOR SIGN PLACEMENT DIMENSIONS	21	E-143	
MM 10.05 RT		18' x 18' 24' x 30'	7.25										X												SEE SHEET 20 FOR SIGN PLACEMENT DIMENSIONS	21		
MM 10.07 LT		18' x 18'	2.25	R3-1A								X													SEE SHEET 20 FOR SIGN PLACEMENT DIMENSIONS	21	E-150	
MM 10.30 RT		18' x 18'	2.25	R3-1A								X													SEE SHEET 20 FOR SIGN PLACEMENT DIMENSIONS		E-150	
MM 10.32 LT		18' x 18' 24' x 30'	7.25										X												SEE SHEET 20 FOR SIGN PLACEMENT DIMENSIONS	21		
MM 10.33 LT		24' x 24' 12' x 18'	5.5	R5-3 R9-6									X												SEE SHEET 20 FOR SIGN PLACEMENT DIMENSIONS	21		
MM 10.33 LT		36' x 36' 24' x 18' 24' x 12'	14	W1-7									X												SEE SHEET 20 FOR SIGN PLACEMENT DIMENSIONS	21	E-152	
MM 10.33 RT		18' x 18'	2.25	R1-1								X													SEE SHEET 20 FOR SIGN PLACEMENT DIMENSIONS		E-143	
MM 10.33 RT		36' x 36' 24' x 18' 24' x 12'	14	W1-7									X												SEE SHEET 20 FOR SIGN PLACEMENT DIMENSIONS	21	E-152	
FINAL POST LENGTHS ARE TO BE DETERMINED IN THE FIELD. POST SIZES ARE COMPUTED BASED ON INFORMATION FURNISHED ON THE STANDARD SHEETS AND THE TRAFFIC & SAFETY DIVISION'S "SIGN POST DESIGN GUIDELINE".			SF.		EA.	SF.	EA.	EA.			LBS.	LBS.	LBS.	LBS.	LBS.	EA.	LBS.	LBS.	LBS.	LBS.		LBS.	EA.	EA.				
TOTALS			110.15								244.78	174.6	130.7															
											419.38			130.7														

TRAFFIC SIGN SUMMARY SHEET #1

PREPARED BY \_\_\_\_\_ SMR DATE 2/8/96  
 CHECKED BY \_\_\_\_\_ DATE \_\_\_\_\_  
 DESIGN SUPERVISOR \_\_\_\_\_  
 PROJ. \_\_\_\_\_ SHELDON-RICHMOND TRANSPORTATION PATH  
 STP BKE (17) S  
 PROJ. NO. \_\_\_\_\_ OF 22  
 SIGN SUMMARY SHEET NO. \_\_\_\_\_  
 SHEET 22 OF 43 SHEETS

TRAFFIC SIGN SUMMARY SHEET

MILEMARKER, STATION, OR SIGN NUMBER	SIGN LEGEND	SIGN DIMENSIONS	NEW AND SALVAGED SIGNS				EXIST. POSTS		NEW SIGN POSTS														REMARKS	SIGN DETAIL					
			AREA	M.U.T.C.D. NO.	SALV. SIGN	SALV. T.I.S.	RET.	SALV.	NO. OF POSTS	FLANGED CHANNEL LB./FT.			TUBULAR ALUMINUM		TUBULAR STEEL				W-SHAPE STEEL		FTG. SIZE	SIGN FRAME		DETAIL ON SHEET NUMBER	STD. SHEET NUMBER				
										1.12	2.0	3.0	3.0"φ	4.0"φ	FOUND. ACTION	3"φ	3.5"φ	4.0"φ	5.0"φ	POST SIZE						WEIGHT	24"	30"	
MM 10.33 RT		24' X 24' 12' X 18'	5.5	R5-3 R9-6						1			X												SEE SHEET 20 FOR SIGN PLACEMENT DIMENSIONS	21			
MM 10.33 LT		18' X 18'	2.25	R1-1						1		X													SEE SHEET 20 FOR SIGN PLACEMENT DIMENSIONS		E-143		
MM 10.34 RT		18' X 18' 24' X 30'	7.25							1			X												SEE SHEET 20 FOR SIGN PLACEMENT DIMENSIONS	21			
MM 10.36 LT		18' X 18'	2.25	R3-1A						1		X													SEE SHEET 20 FOR SIGN PLACEMENT DIMENSIONS		E-150		
MM 12.40 RT		18' X 18'	2.25	R3-1A						1		X													SEE SHEET 20 FOR SIGN PLACEMENT DIMENSIONS		E-150		
MM 12.42 LT		18' X 18' 24' X 30'	7.25							1			X												SEE SHEET 20 FOR SIGN PLACEMENT DIMENSIONS	21			
MM 12.43 RT		18' X 18'	2.25	R1-1						1		X													SEE SHEET 20 FOR SIGN PLACEMENT DIMENSIONS		E-143		
MM 12.43 RT		36' X 36' 24' X 18' 24' X 12'	14	W1-7						1			X												SEE SHEET 20 FOR SIGN PLACEMENT DIMENSIONS	21	E-152		
MM 12.43 RT		24' X 24' 12' X 18'	5.5	R5-3 R9-6						1			X												SEE SHEET 20 FOR SIGN PLACEMENT DIMENSIONS		21		
MM 12.43 LT		24' X 24' 12' X 18'	5.5	R5-3 R9-6						1			X												SEE SHEET 20 FOR SIGN PLACEMENT DIMENSIONS		21		
MM 12.43 LT		36' X 36' 24' X 18' 24' X 12'	14	W1-7						1			X												SEE SHEET 20 FOR SIGN PLACEMENT DIMENSIONS	21	E-152		
MM 12.43 LT		18' X 18'	2.25	R1-1						1		X													SEE SHEET 20 FOR SIGN PLACEMENT DIMENSIONS		E-143		
MM 12.44 RT		18' X 18' 24' X 30'	7.25							1			X												SEE SHEET 20 FOR SIGN PLACEMENT DIMENSIONS	21			
MM 12.46 LT		18' X 18'	2.25	R3-1A						1		X													SEE SHEET 20 FOR SIGN PLACEMENT DIMENSIONS		E-150		
MM 12.70 RT		18' X 18'	2.25	R3-1A						1		X													SEE SHEET 20 FOR SIGN PLACEMENT DIMENSIONS		E-150		
MM 12.72 LT		18' X 18' 24' X 30'	7.25							1			X												SEE SHEET 20 FOR SIGN PLACEMENT DIMENSIONS	21			
MM 12.73 RT		18' X 18'	2.25	R1-1						1		X													SEE SHEET 20 FOR SIGN PLACEMENT DIMENSIONS		E-143		
MM 12.73 RT		36' X 36' 24' X 18' 24' X 12'	14	W1-7						1			X												SEE SHEET 20 FOR SIGN PLACEMENT DIMENSIONS	21	E-152		
FINAL POST LENGTHS ARE TO BE DETERMINED IN THE FIELD. POST SIZES ARE COMPUTED BASED ON INFORMATION FURNISHED ON THE STANDARD SHEETS AND THE TRAFFIC & SAFETY DIVISION'S "SIGN POST DESIGN GUIDELINE".			SF.	EA.	SF.	EA.	EA.				LBS.	LBS.	LBS.	LBS.	LBS.	EA.	LBS.	LBS.	LBS.	LBS.		LBS.	EA.	EA.					
TOTALS			105.5									504.0	307.2	98.0	98.0														

**TRAFFIC SIGN SUMMARY SHEET #2**  
 PREPARED BY: \_\_\_\_\_ DATE: 7/8/96  
 CHECKED BY: \_\_\_\_\_ DATE: \_\_\_\_\_  
 DESIGN SUPERVISOR: \_\_\_\_\_  
 PROJ. NO. \_\_\_\_\_  
 SIGN SUMMARY SHEET NO. 2 OF 22  
 SHEET 23 OF 43 SHEETS

TRAFFIC SIGN SUMMARY SHEET

MILEMARKER, STATION, OR SIGN NUMBER	SIGN LEGEND	SIGN DIMENSIONS	NEW AND SALVAGED SIGNS		EXIST. POSTS		NEW SIGN POSTS														REMARKS	SIGN DETAIL						
			AREA	M.U.T.C.D. NO.	SALV. SIGN	SALV. T.I.S.	RET.	SALV.	NO. OF POSTS	FLANGED CHANNEL LB./FT.			TUBULAR ALUMINUM		TUBULAR STEEL					W-SHAPE STEEL		24"	30"	SIGN FRAME	DETAIL ON SHEET NUMBER	STD. SHEET NUMBER		
										1.12	2.0	3.0	3.0"φ	4.0"φ	FOUND. ATION	3"φ	3.5"φ	4.0"φ	5.0"φ	POST SIZE							WEIGHT	
MM 12.73 RT		24' X 24' 12' X 18'	5.5	R5-3 R9-6					1			X														SEE SHEET 20 FOR SIGN PLACEMENT DIMENSIONS	21	
MM 12.73 LT		24' X 24' 12' X 18'	5.5	R5-3 R9-6					1			X														SEE SHEET 20 FOR SIGN PLACEMENT DIMENSIONS	21	
MM 12.73 LT		36' X 36' 24' X 18' 24' X 12'	14	W1-7					1			X														SEE SHEET 20 FOR SIGN PLACEMENT DIMENSIONS	21	E-152
MM 12.73 LT		18' X 18'	2.25	R1-1					1		X															SEE SHEET 20 FOR SIGN PLACEMENT DIMENSIONS		E-143
MM 12.74 RT		18' X 18' 24' X 30'	7.25						1			X														SEE SHEET 20 FOR SIGN PLACEMENT DIMENSIONS	21	
MM 12.76 LT		18' X 18'	2.25	R3-1A					1		X															SEE SHEET 20 FOR SIGN PLACEMENT DIMENSIONS		E-150
MM 12.85 RT		24' X 30' 12' X 36'	8.00	R12-1 DM-3R					1			X														SEE SHEET 20 FOR SIGN PLACEMENT DIMENSIONS	21	
MM 12.85 LT		12' X 36'	3.00	DM-3L					1		X															SEE SHEET 20 FOR SIGN PLACEMENT DIMENSIONS	21	
MM 12.87 RT		12' X 36'	3.00	DM-3R					1		X															SEE SHEET 20 FOR SIGN PLACEMENT DIMENSIONS	21	
MM 12.87 LT		24' X 30' 12' X 36'	8.00	R12-1 DM-3L					1			X														SEE SHEET 20 FOR SIGN PLACEMENT DIMENSIONS	21	
MM 13.22 RT		12' X 36'	3.00	DM-3R					1		X															SEE SHEET 20 FOR SIGN PLACEMENT DIMENSIONS	21	
MM 13.22 LT		12' X 36'	3.00	DM-3L					1		X															SEE SHEET 20 FOR SIGN PLACEMENT DIMENSIONS	21	
MM 13.24 RT		12' X 36'	3.00	DM-3R					1		X															SEE SHEET 20 FOR SIGN PLACEMENT DIMENSIONS	21	
MM 13.24 LT		12' X 36'	3.00	DM-3L					1		X															SEE SHEET 20 FOR SIGN PLACEMENT DIMENSIONS	21	
MM 14.45 RT		18' X 18'	2.25	R3-1A					1		X															SEE SHEET 20 FOR SIGN PLACEMENT DIMENSIONS		E-150
MM 14.47 LT		18' X 18' 24' X 30'	7.25						1			X														SEE SHEET 20 FOR SIGN PLACEMENT DIMENSIONS	21	
MM 14.48 RT		18' X 18'	2.25	R1-1					1		X															SEE SHEET 20 FOR SIGN PLACEMENT DIMENSIONS		E-143
MM 14.48 RT		36' X 36' 24' X 18' 24' X 12'	14	W1-7					1			X														SEE SHEET 20 FOR SIGN PLACEMENT DIMENSIONS	21	E-152
FINAL POST LENGTHS ARE TO BE DETERMINED IN THE FIELD. POST SIZES ARE COMPUTED BASED ON INFORMATION FURNISHED ON THE STANDARD SHEETS AND THE TRAFFIC & SAFETY DIVISION'S "SIGN POST DESIGN GUIDELINE".			SF.	EA.	SF.	EA.	EA.			LBS.	LBS.	LBS.	LBS.	LBS.	EA.	LBS.	LBS.	LBS.	LBS.		LBS.	EA.	EA.					
TOTALS			96.5								531.0	260.4	270.6	65.4	65.4													

**TRAFFIC SIGN SUMMARY SHEET #3**  
 PREPARED BY: \_\_\_\_\_ DATE: 7/8/95  
 CHECKED BY: \_\_\_\_\_  
 DESIGN SUPERVISOR: \_\_\_\_\_  
 PROJ. NO.: \_\_\_\_\_  
 SHELTON-RICHFORD TRANSPORTATION PATH  
 STP BIKE (1) S  
 SIGN SUMMARY SHEET NO. 3 OF 22  
 SHEET 24 OF 43 SHEETS

TRAFFIC SIGN SUMMARY SHEET

MILEMARKER, STATION, OR SIGN NUMBER	SIGN LEGEND	SIGN DIMENSIONS	NEW AND SALVAGED SIGNS			EXIST. POSTS		NEW SIGN POSTS														REMARKS	SIGN DETAIL				
			AREA	M.U.T.C.D. NO.	SALV. SIGN	SALV. T.J.S.	RET.	SALV.	NO. OF POSTS	FLANGED CHANNEL LB./FT.			TUBULAR ALUMINUM		TUBULAR STEEL				W-SHAPE STEEL		FTG. SIZE		SIGN FRAME	DETAIL ON SHEET NUMBER	STD. SHEET NUMBER		
										1.12	2.0	3.0	3.0"φ	4.0"φ	FOUND-ATION	3"φ	3.5"φ	4.0"φ	5.0"φ	POST SIZE	WEIGHT					24"	30"
MM 14.48 RT		24' X 24' 12' X 18'	5.5	R5-3					1			X													SEE SHEET 20 FOR SIGN PLACEMENT DIMENSIONS	21	
MM 14.48 LT		24' X 24' 12' X 18'	5.5	R5-3					1			X													SEE SHEET 20 FOR SIGN PLACEMENT DIMENSIONS	21	
MM 14.48 LT		36' X 36' 24' X 18' 24' X 12'	14	W1-7					1				X												SEE SHEET 20 FOR SIGN PLACEMENT DIMENSIONS	21	E-152
MM 14.48 LT		18' X 18'	2.25	R1-1					1		X														SEE SHEET 20 FOR SIGN PLACEMENT DIMENSIONS		E-143
MM 14.49 RT		18' X 18' 24' X 30'	7.25						1			X													SEE SHEET 20 FOR SIGN PLACEMENT DIMENSIONS	21	
MM 14.51 LT		18' X 18'	2.25	R3-1A					1		X														SEE SHEET 20 FOR SIGN PLACEMENT DIMENSIONS		E-150
MM 14.87 RT		24' X 30' 12' X 36'	8.00	R12-1 DM-3R					1			X													SEE SHEET 20 FOR SIGN PLACEMENT DIMENSIONS	21	
MM 14.87 LT		12' X 36'	3.00	DM-3L					1		X														SEE SHEET 20 FOR SIGN PLACEMENT DIMENSIONS	21	
MM 14.89 RT		12' X 36'	3.00	DM-3R					1		X														SEE SHEET 20 FOR SIGN PLACEMENT DIMENSIONS	21	
MM 14.89 LT		24' X 30' 12' X 36'	8.00	R12-1 DM-3L					1			X													SEE SHEET 20 FOR SIGN PLACEMENT DIMENSIONS	21	
MM 14.93 RT		18' X 18'	2.25	R3-1A					1		X														SEE SHEET 20 FOR SIGN PLACEMENT DIMENSIONS		E-150
MM 14.95 LT		18' X 18' 24' X 30'	7.25						1			X													SEE SHEET 20 FOR SIGN PLACEMENT DIMENSIONS	21	
MM 14.96 RT		18' X 18'	2.25	R1-1					1		X														SEE SHEET 20 FOR SIGN PLACEMENT DIMENSIONS		E-143
MM 14.96 RT		36' X 36' 24' X 18' 24' X 12'	14	W1-7					1				X												SEE SHEET 20 FOR SIGN PLACEMENT DIMENSIONS	21	E-152
MM 14.96 RT		24' X 24' 12' X 18'	5.5	R5-3					1			X													SEE SHEET 20 FOR SIGN PLACEMENT DIMENSIONS	21	
MM 14.96 LT		24' X 24' 12' X 18'	5.5	R5-3					1			X													SEE SHEET 20 FOR SIGN PLACEMENT DIMENSIONS	21	
MM 14.96 LT		36' X 36' 24' X 18' 24' X 12'	14	W1-7					1				X												SEE SHEET 20 FOR SIGN PLACEMENT DIMENSIONS	21	E-152
MM 14.96 LT		18' X 18'	2.25	R1-1					1		X														SEE SHEET 20 FOR SIGN PLACEMENT DIMENSIONS		E-143
FINAL POST LENGTHS ARE TO BE DETERMINED IN THE FIELD. POST SIZES ARE COMPUTED BASED ON INFORMATION FURNISHED ON THE STANDARD SHEETS AND THE TRAFFIC & SAFETY DIVISION'S " SIGN POST DESIGN GUIDELINE ".			SF.	EA.	SF.	EA.	EA.				LBS.	LBS.	LBS.	LBS.	LBS.	EA.	LBS.	LBS.	LBS.	LBS.		LBS.	EA.	EA.			
TOTALS			111.75								176.4	354.6	98.0														
											531.0		98.0														
																							PREPARED BY: <u>SMR</u> DATE: <u>7/8/96</u> CHECKED BY: _____ DATE: _____ DESIGN SUPERVISOR: _____ PROJ.: SHELTON-RICHMOND TRANSPORTATION PATH STP BKE (17) S SIGN SUMMARY SHEET NO. <u>4</u> OF <u>22</u> SHEET <u>25</u> OF <u>43</u> SHEETS				

E:\DATA\1996\DESIGN\TRAFFIC\SUMMARY SHEET.dwg Thu Aug 15 08:15:26 1996 CDD P101 From DMJ Dwg

**TRAFFIC SIGN SUMMARY SHEET #4**

TRAFFIC SIGN SUMMARY SHEET

MILEMARKER, STATION, OR SIGN NUMBER	SIGN LEGEND	SIGN DIMENSIONS	NEW AND SALVAGED SIGNS		EXIST. POSTS		NEW SIGN POSTS														REMARKS	SIGN DETAIL								
			AREA	M.U.I.C.D. NO.	SALV. SIGN	SALV. T.I.S.	RET.	SALV.	NO. OF POSTS	FLANGED CHANNEL LB./FT.			TUBULAR ALUMINUM		TUBULAR STEEL					W-SHAPE STEEL		FIG. SIZE	SIGN FRAME	DETAIL ON SHEET NUMBER	STD. SHEET NUMBER					
										1.12	2.0	3.0	3.0"φ	4.0"φ	FOUND.	3"φ	3.5"φ	4.0"φ	5.0"φ	POST SIZE						WEIGHT	24"	30"		
MM 14.97 RT		18' X 18' 24' X 30'	7.25																								SEE SHEET 20 FOR SIGN PLACEMENT DIMENSIONS	21		
MM 14.99 LT		18' X 18'	2.25	R3-1A																							SEE SHEET 20 FOR SIGN PLACEMENT DIMENSIONS		E-150	
MM 15.78 RT		24' X 30' 12' X 36'	8.00	R12-1																							SEE SHEET 20 FOR SIGN PLACEMENT DIMENSIONS	21		
MM 15.78 LT		12' X 36'	3.00	DM-3L																							SEE SHEET 20 FOR SIGN PLACEMENT DIMENSIONS	21		
MM 15.80 RT		12' X 36'	3.00	DM-3R																							SEE SHEET 20 FOR SIGN PLACEMENT DIMENSIONS	21		
MM 15.80 LT		24' X 30' 12' X 36'	8.00	R12-1																							SEE SHEET 20 FOR SIGN PLACEMENT DIMENSIONS	21		
MM 16.88 RT		18' X 18'	2.25	R3-1A																							SEE SHEET 20 FOR SIGN PLACEMENT DIMENSIONS		E-150	
MM 16.90 LT		18' X 18' 24' X 30'	7.25																								SEE SHEET 20 FOR SIGN PLACEMENT DIMENSIONS	21		
MM 16.91 RT		18' X 18'	2.25	R1-1																							SEE SHEET 20 FOR SIGN PLACEMENT DIMENSIONS		E-143	
MM 16.91 RT		36' X 36' 24' X 18' 24' X 12'	14	W1-7																							SEE SHEET 20 FOR SIGN PLACEMENT DIMENSIONS	21	E-152	
MM 16.91 RT		24' X 24'	5.5	R5-3																							SEE SHEET 20 FOR SIGN PLACEMENT DIMENSIONS	21		
MM 16.91 LT		12' X 18'	5.5	R9-6																							SEE SHEET 20 FOR SIGN PLACEMENT DIMENSIONS	21		
MM 16.91 LT		36' X 36' 24' X 18' 24' X 12'	14	W1-7																							SEE SHEET 20 FOR SIGN PLACEMENT DIMENSIONS	21	E-152	
MM 16.91 LT		18' X 18'	2.25	R1-1																							SEE SHEET 20 FOR SIGN PLACEMENT DIMENSIONS		E-143	
MM 16.92 RT		18' X 18' 24' X 30'	7.25																									SEE SHEET 20 FOR SIGN PLACEMENT DIMENSIONS	21	
MM 16.94 LT		18' X 18'	2.25	R3-1A																							SEE SHEET 20 FOR SIGN PLACEMENT DIMENSIONS		E-150	
MM 17.30 RT		24' X 30' 12' X 36'	8.00	R12-1																							SEE SHEET 20 FOR SIGN PLACEMENT DIMENSIONS	21		
MM 17.30 LT		12' X 36'	3.00	DM-3L																							SEE SHEET 20 FOR SIGN PLACEMENT DIMENSIONS	21		
FINAL POST LENGTHS ARE TO BE DETERMINED IN THE FIELD. POST SIZES ARE COMPUTED BASED ON INFORMATION FURNISHED ON THE STANDARD SHEETS AND THE TRAFFIC & SAFETY DIVISION'S " SIGN POST DESIGN GUIDELINE ".			SF.		EA.	SF.	EA.	EA.			LBS.	LBS.	LBS.	LBS.	LBS.	EA.	LBS.	LBS.	LBS.	LBS.		LBS.	EA.	EA.		<b>TRAFFIC SIGN SUMMARY SHEET #5</b>		PREPARED BY: SMR CHECKED BY: _____ DESIGN SUPERVISOR: _____ PROJ. NO.: SHELTON-RICHFORD TRANSPORTATION PATH SIGN SUMMARY SHEET NO. 5 OF 22 SHEET 26 OF 43 SHEETS	DATE: 7/8/96	
TOTALS			105.0								568.5	363.9	65.4	65.4																

D:\MULTIMEDIA\REF\SYSTEMS\TRAFFIC SIGN SUMMARY SHEET.DWG Thu Aug 15 08:19:46 1996 2400 Plot Plot SWI SWI CADD



TRAFFIC SIGN SUMMARY SHEET

MILEMARKER, STATION, OR SIGN NUMBER	SIGN LEGEND	SIGN DIMENSIONS	NEW AND SALVAGED SIGNS				EXIST. POSTS		NEW SIGN POSTS														REMARKS	SIGN DETAIL				
			AREA	M.U.I.C.D. NO.	SALV. SIGN	SALV. T.I.S.	RET.	SALV.	NO. OF POSTS	FLANGED CHANNEL LB./FT.			TUBULAR ALUMINUM		TUBULAR STEEL				W-SHAPE STEEL		FTG. SIZE			SIGN FRAME	DETAIL ON SHEET NUMBER	STD. SHEET NUMBER		
										1.12	2.0	3.0	3.0"φ	4.0"φ	FOUND-ATION	3"φ	3.5"φ	4.0"φ	5.0"φ	POST SIZE	WEIGHT	24"					30"	
MM 17.56 LT		18' X 18'	2.25	R1-1								X													SEE SHEET 20 FOR SIGN PLACEMENT DIMENSIONS		E-143	
MM 17.57 RT		18' X 18' 24' X 30'	7.25										X												SEE SHEET 20 FOR SIGN PLACEMENT DIMENSIONS	21		
MM 17.59 LT		18' X 18'	2.25	R3-1A								X													SEE SHEET 20 FOR SIGN PLACEMENT DIMENSIONS		E-150	
MM 17.62 RT		18' X 18'	2.25	R3-1A								X													SEE SHEET 20 FOR SIGN PLACEMENT DIMENSIONS		E-150	
MM 17.64 LT		18' X 18' 24' X 30'	7.25										X												SEE SHEET 20 FOR SIGN PLACEMENT DIMENSIONS	21		
MM 17.65 RT		18' X 18'	2.25	R1-1								X													SEE SHEET 20 FOR SIGN PLACEMENT DIMENSIONS		E-143	
MM 17.65 RT		36' X 36' 24' X 18' 24' X 12'	14	W1-7									X												SEE SHEET 20 FOR SIGN PLACEMENT DIMENSIONS	21	E-152	
MM 17.65 RT		24' X 24' 12' X 18'	5.5	R5-3 R9-6									X												SEE SHEET 20 FOR SIGN PLACEMENT DIMENSIONS	21		
MM 17.65 LT		24' X 24' 12' X 18'	5.5	R5-3 R9-6									X												SEE SHEET 20 FOR SIGN PLACEMENT DIMENSIONS	21		
MM 17.65 LT		36' X 36' 24' X 18' 24' X 12'	14	W1-7									X												SEE SHEET 20 FOR SIGN PLACEMENT DIMENSIONS	21	E-152	
MM 17.65 LT		18' X 18'	2.25	R1-1								X													SEE SHEET 20 FOR SIGN PLACEMENT DIMENSIONS		E-143	
MM 17.66 RT		18' X 18' 24' X 30'	7.25										X												SEE SHEET 20 FOR SIGN PLACEMENT DIMENSIONS	21		
MM 17.68 LT		18' X 18'	2.25	R3-1A								X													SEE SHEET 20 FOR SIGN PLACEMENT DIMENSIONS		E-150	
MM 17.75 RT		18' X 18'	2.25	R3-1A								X													SEE SHEET 20 FOR SIGN PLACEMENT DIMENSIONS		E-150	
MM 17.77 LT		18' X 18' 24' X 30'	7.25										X												SEE SHEET 20 FOR SIGN PLACEMENT DIMENSIONS	21		
MM 17.78 RT		18' X 18'	2.25	R1-1								X													SEE SHEET 20 FOR SIGN PLACEMENT DIMENSIONS		E-143	
MM 17.78 RT		36' X 36' 24' X 18' 24' X 12'	14	W1-7									X												SEE SHEET 20 FOR SIGN PLACEMENT DIMENSIONS	21	E-152	
MM 17.78 RT		24' X 24' 12' X 18'	5.5	R5-3 R9-6									X												SEE SHEET 20 FOR SIGN PLACEMENT DIMENSIONS	21		
FINAL POST LENGTHS ARE TO BE DETERMINED IN THE FIELD. POST SIZES ARE COMPUTED BASED ON INFORMATION FURNISHED ON THE STANDARD SHEETS AND THE TRAFFIC & SAFETY DIVISION'S "SIGN POST DESIGN GUIDELINE".			SF.		EA.	SF.	EA.	EA.			LBS.	LBS.	LBS.	LBS.	LBS.	EA.	LBS.	LBS.	LBS.	LBS.		LBS.	EA.	EA.				
TOTALS			105.5								196.8	307.2	98.0															
											504.0		98.0															

TRAFFIC SIGN SUMMARY SHEET #7

PREPARED BY: SMR DATE: 1/18/96  
 CHECKED BY: \_\_\_\_\_ DATE: \_\_\_\_\_  
 DESIGN SUPERVISOR: \_\_\_\_\_  
 PROJ.: SHELTON-RICHFORD TRANSPORTATION PATH  
 STP BIKE (17) S  
 SIGN SUMMARY SHEET NO. 7 OF 22  
 SHEET 28 OF 43 SHEETS

TRAFFIC SIGN SUMMARY SHEET

MILEMARKER, STATION, OR SIGN NUMBER	SIGN LEGEND	SIGN DIMENSIONS	NEW AND SALVAGED SIGNS				EXIST. POSTS		NEW SIGN POSTS														REMARKS	SIGN DETAIL				
			AREA	M.U.T.C.D. NO.	SALV. SIGN	SALV. T.I.S.	RET.	SALV.	NO. OF POSTS	FLANGED CHANNEL LB./FT.			TUBULAR ALUMINUM		TUBULAR STEEL					W-SHAPE STEEL		FIG. SIZE		SIGN FRAME	DETAIL ON SHEET NUMBER	STD. SHEET NUMBER		
										1.12	2.0	3.0	3.0"φ	4.0"φ	FOUND. ATION	3"φ	3.5"φ	4.0"φ	5.0"φ	POST SIZE	WEIGHT						24"	30"
MM 17.78 LT		24' X 24' 12' X 18'	5.5	R5-3 R9-6					1			X														SEE SHEET 20 FOR SIGN PLACEMENT DIMENSIONS	21	
MM 17.78 LT		36' X 36' 24' X 18' 24' X 12'	14	W1-7					1			X														SEE SHEET 20 FOR SIGN PLACEMENT DIMENSIONS	21	E-152
MM 17.78 LT		18' X 18'	2.25	R1-1					1		X															SEE SHEET 20 FOR SIGN PLACEMENT DIMENSIONS		E-143
MM 17.79 RT		18' X 18' 24' X 30'	7.25						1			X														SEE SHEET 20 FOR SIGN PLACEMENT DIMENSIONS	21	
MM 17.81 LT		18' X 18'	2.25	R3-1A					1		X															SEE SHEET 20 FOR SIGN PLACEMENT DIMENSIONS		E-150
MM 18.32 RT		12' X 36'	3.00	DM-3R					1		X															SEE SHEET 20 FOR SIGN PLACEMENT DIMENSIONS	21	
MM 18.32 LT		12' X 36'	3.00	DM-3L					1		X															SEE SHEET 20 FOR SIGN PLACEMENT DIMENSIONS	21	
MM 18.34 RT		12' X 36'	3.00	DM-3R					1		X															SEE SHEET 20 FOR SIGN PLACEMENT DIMENSIONS	21	
MM 18.34 LT		12' X 36'	3.00	DM-3L					1		X															SEE SHEET 20 FOR SIGN PLACEMENT DIMENSIONS	21	
MM 19.01 RT		18' X 18'	2.25	R3-1A					1		X															SEE SHEET 20 FOR SIGN PLACEMENT DIMENSIONS		E-150
MM 19.03 LT		18' X 18' 24' X 30'	7.25						1			X														SEE SHEET 20 FOR SIGN PLACEMENT DIMENSIONS	21	
MM 19.04 RT		18' X 18'	2.25	R1-1					1		X															SEE SHEET 20 FOR SIGN PLACEMENT DIMENSIONS		E-143
MM 19.04 RT		36' X 36' 24' X 18' 24' X 12'	14	W1-7					1			X														SEE SHEET 20 FOR SIGN PLACEMENT DIMENSIONS	21	E-152
MM 19.04 RT		24' X 24' 12' X 18'	5.5	R5-3 R9-6					1			X														SEE SHEET 20 FOR SIGN PLACEMENT DIMENSIONS	21	
MM 19.04 LT		24' X 24' 12' X 18'	5.5	R5-3 R9-6					1			X														SEE SHEET 20 FOR SIGN PLACEMENT DIMENSIONS	21	
MM 19.04 LT		36' X 36' 24' X 18' 24' X 12'	14	W1-7					1			X														SEE SHEET 20 FOR SIGN PLACEMENT DIMENSIONS	21	E-152
MM 19.04 LT		18' X 18'	2.25	R1-1					1		X															SEE SHEET 20 FOR SIGN PLACEMENT DIMENSIONS		E-143
MM 19.05 RT		18' X 18' 24' X 30'	7.25						1			X														SEE SHEET 20 FOR SIGN PLACEMENT DIMENSIONS	21	
FINAL POST LENGTHS ARE TO BE DETERMINED IN THE FIELD. POST SIZES ARE COMPUTED BASED ON INFORMATION FURNISHED ON THE STANDARD SHEETS AND THE TRAFFIC & SAFETY DIVISION'S "SIGN POST DESIGN GUIDELINE".			SF.	EA.	SF.	EA.	EA.			LBS.	LBS.	LBS.	LBS.	EA.	LBS.	LBS.	LBS.	LBS.		LBS.	EA.	EA.						
TOTALS			103.5								492.3	261.9	98.0															

**TRAFFIC SIGN SUMMARY SHEET #8**  
 PREPARED BY: \_\_\_\_\_ SMR DATE: 7/8/96  
 CHECKED BY: \_\_\_\_\_ DATE: \_\_\_\_\_  
 DESIGN SUPERVISOR: \_\_\_\_\_  
 PROJ. NO. SHELTON-RICHFORD TRANSPORTATION PATH  
 SIGN SUMMARY SHEET NO. 8 OF 22  
 SHEET 29 OF 43 SHEETS

D:\DATA\PROJECTS\1996\199607\19960715\19960715.DWG Thu Aug 10 10:33:33 1996 CAD Plot From SMC Corp

TRAFFIC SIGN SUMMARY SHEET

MILEMARKER, STATION, OR SIGN NUMBER	SIGN LEGEND	SIGN DIMENSIONS	NEW AND SALVAGED SIGNS		EXIST. POSTS		NEW SIGN POSTS														REMARKS	SIGN DETAIL						
			AREA	M.U.I.C.D. NO.	SALV. SIGN	SALV. T.I.S.	RET.	SALV.	NO. OF POSTS	FLANGED CHANNEL LB./FT.			TUBULAR ALUMINUM		TUBULAR STEEL				W-SHAPE STEEL			FTG. SIZE	SIGN FRAME	DETAIL ON SHEET NUMBER	STD. SHEET NUMBER			
										112	2.0	3.0	3.0"φ	4.0"φ	FOUND-ATION	3"φ	3.5"φ	4.0"φ	5.0"φ	POST SIZE						WFIGHT	24"	30"
MM 19.07 LT		18' X 18'	2.25	R3-1A					1		X															SEE SHEET 20 FOR SIGN PLACEMENT DIMENSIONS		E-150
MM 19.91 RT		18' X 18'	2.25	R3-1A					1		X															SEE SHEET 20 FOR SIGN PLACEMENT DIMENSIONS		E-150
MM 19.93 LT		18' X 18' 24' X 30'	7.25						1			X														SEE SHEET 20 FOR SIGN PLACEMENT DIMENSIONS	21	
MM 19.94 RT		18' X 18'	2.25	R1-1					1		X															SEE SHEET 20 FOR SIGN PLACEMENT DIMENSIONS		E-143
MM 19.94 RT		36' X 36' 24' X 18' 24' X 12'	14	W1-7					1			X														SEE SHEET 20 FOR SIGN PLACEMENT DIMENSIONS	21	E-152
MM 19.94 RT		24' X 24' 12' X 18'	5.5	R5-3 R9-6					1			X														SEE SHEET 20 FOR SIGN PLACEMENT DIMENSIONS	21	
MM 19.94 LT		24' X 24' 12' X 18'	5.5	R5-3 R9-6					1			X														SEE SHEET 20 FOR SIGN PLACEMENT DIMENSIONS	21	
MM 19.94 LT		36' X 36' 24' X 18' 24' X 12'	14	W1-7					1			X														SEE SHEET 20 FOR SIGN PLACEMENT DIMENSIONS	21	E-152
MM 19.94 LT		18' X 18'	2.25	R1-1					1		X															SEE SHEET 20 FOR SIGN PLACEMENT DIMENSIONS		E-143
MM 19.95 RT		18' X 18' 24' X 30'	7.25						1			X														SEE SHEET 20 FOR SIGN PLACEMENT DIMENSIONS	21	
MM 19.97 LT		18' X 18'	2.25	R3-1A					1		X															SEE SHEET 20 FOR SIGN PLACEMENT DIMENSIONS		E-150
MM 20.39 RT		18' X 18'	2.25	R3-1A					1		X															SEE SHEET 20 FOR SIGN PLACEMENT DIMENSIONS		E-150
MM 20.41 LT		18' X 18' 24' X 30'	7.25						1			X														SEE SHEET 20 FOR SIGN PLACEMENT DIMENSIONS	21	
MM 20.42 RT		18' X 18'	2.25	R1-1					1		X															SEE SHEET 20 FOR SIGN PLACEMENT DIMENSIONS		E-143
MM 20.42 RT		36' X 36' 24' X 18' 24' X 12'	14	W1-7					1			X														SEE SHEET 20 FOR SIGN PLACEMENT DIMENSIONS	21	E-152
MM 20.42 RT		24' X 24' 12' X 18'	5.5	R5-3 R9-6					1			X														SEE SHEET 20 FOR SIGN PLACEMENT DIMENSIONS	21	
MM 20.42 LT		24' X 24' 12' X 18'	5.5	R5-3 R9-6					1			X														SEE SHEET 20 FOR SIGN PLACEMENT DIMENSIONS	21	
MM 20.42 LT		36' X 36' 24' X 18' 24' X 12'	14	W1-7					1			X														SEE SHEET 20 FOR SIGN PLACEMENT DIMENSIONS	21	E-152
FINAL POST LENGTHS ARE TO BE DETERMINED IN THE FIELD. POST SIZES ARE COMPUTED BASED ON INFORMATION FURNISHED ON THE STANDARD SHEETS AND THE TRAFFIC & SAFETY DIVISION'S " SIGN POST DESIGN GUIDELINE ".			SF.		EA.	SF.	EA.	EA.			LBS.	LBS.	LBS.	LBS.	LBS.	EA.	LBS.	LBS.	LBS.	LBS.		LBS.	EA.	EA.		TRAFFIC SIGN SUMMARY SHEET #9		PREPARED BY: SMR DATE: 1/18/06 CHECKED BY: _____ DATE: _____ DESIGN SUPERVISOR: _____ PROJECT NO.: _____ SIGN SUMMARY SHEET NO.: 9 OF 22 SHEET 30 OF 43 SHEETS
TOTALS			115.5								476.7	303.9	130.7	130.7														

TRAFFIC SIGN SUMMARY SHEET

MILEMARKER, STATION, OR SIGN NUMBER	SIGN LEGEND	SIGN DIMENSIONS	NEW AND SALVAGED SIGNS				EXIST. POSTS			NEW SIGN POSTS														REMARKS	SIGN DETAIL				
			AREA	M.U.T.C.D. NO.	SALV. SIGN	SALV. T.I.S.	RET.	SALV.	NO. OF POSTS	FLANGED CHANNEL LB./FT.			TUBULAR ALUMINUM		TUBULAR STEEL					W-SHAPE STEEL		FTG. SIZE	SIGN FRAME		DETAIL ON SHEET NUMBER	STD. SHEET NUMBER			
										1.12	2.0	3.0	3.0"φ	4.0"φ	FOUNDATION	3"φ	3.5"φ	4.0"φ	5.0"φ	POST SIZE	WEIGHT						24"	30"	
MM 20.42 LT		18' X 18'	2.25	R1-1									X													SEE SHEET 20 FOR SIGN PLACEMENT DIMENSIONS		E-143	
MM 20.43 RT		18' X 18' 24' X 30'	7.25																							SEE SHEET 20 FOR SIGN PLACEMENT DIMENSIONS	21		
MM 20.45 LT		18' X 18'	2.25	R3-1A									X													SEE SHEET 20 FOR SIGN PLACEMENT DIMENSIONS		E-150	
MM 20.61 RT		12' X 36'	3.00	DM-3R									X													SEE SHEET 20 FOR SIGN PLACEMENT DIMENSIONS	21		
MM 20.61 LT		12' X 36'	3.00	DM-3L									X													SEE SHEET 20 FOR SIGN PLACEMENT DIMENSIONS	21		
MM 20.63 RT		12' X 36'	3.00	DM-3R									X													SEE SHEET 20 FOR SIGN PLACEMENT DIMENSIONS	21		
MM 20.63 LT		12' X 36'	3.00	DM-3L									X													SEE SHEET 20 FOR SIGN PLACEMENT DIMENSIONS	21		
MM 21.33 RT		18' X 18'	2.25	R3-1A									X													SEE SHEET 20 FOR SIGN PLACEMENT DIMENSIONS		E-150	
MM 21.35 LT		18' X 18' 24' X 30'	7.25											X												SEE SHEET 20 FOR SIGN PLACEMENT DIMENSIONS	21		
MM 21.36 RT		18' X 18'	2.25	R1-1									X													SEE SHEET 20 FOR SIGN PLACEMENT DIMENSIONS		E-143	
MM 21.36 RT		36' X 36' 24' X 18' 24' X 12'	14	W1-7										X												SEE SHEET 20 FOR SIGN PLACEMENT DIMENSIONS	21	E-152	
MM 21.36 RT		24' X 24' 12' X 18'	5.5	R5-3 R9-6										X												SEE SHEET 20 FOR SIGN PLACEMENT DIMENSIONS	21		
MM 21.36 LT		24' X 24' 12' X 18'	5.5	R5-3 R9-6										X												SEE SHEET 20 FOR SIGN PLACEMENT DIMENSIONS	21		
MM 21.36 LT		36' X 36' 24' X 18' 24' X 12'	14	W1-7										X												SEE SHEET 20 FOR SIGN PLACEMENT DIMENSIONS	21	E-152	
MM 21.36 LT		18' X 18'	2.25	R1-1									X													SEE SHEET 20 FOR SIGN PLACEMENT DIMENSIONS		E-143	
MM 21.37 RT		18' X 18' 24' X 30'	7.25												X											SEE SHEET 20 FOR SIGN PLACEMENT DIMENSIONS	21		
MM 21.37 RT		12' X 36'	3.00	DM-3R									X													SEE SHEET 20 FOR SIGN PLACEMENT DIMENSIONS	21		
MM 21.37 LT		12' X 36'	3.00	DM-3L									X													SEE SHEET 20 FOR SIGN PLACEMENT DIMENSIONS	21		
FINAL POST LENGTHS ARE TO BE DETERMINED IN THE FIELD. POST SIZES ARE COMPUTED BASED ON INFORMATION FURNISHED ON THE STANDARD SHEETS AND THE TRAFFIC & SAFETY DIVISION'S " SIGN POST DESIGN GUIDELINE ".			SF.	EA.	SF.	EA.	EA.				LBS.	LBS.	LBS.	LBS.	LBS.	EA.	LBS.	LBS.	LBS.	LBS.		LBS.	EA.	EA.					
TOTALS			90.0								284.4	219.9	65.4																
											504.3		65.4																

PREPARED BY: \_\_\_\_\_ DATE: 7/8/96  
 CHECKED BY: \_\_\_\_\_ DATE: \_\_\_\_\_  
 DESIGN SUPERVISOR: \_\_\_\_\_  
 PROJ. NO.: \_\_\_\_\_ SHELTON-RICHFORD TRANSPORTATION PATH  
 SIGN SUMMARY SHEET NO. 10 OF 22  
 SHEET 31 OF 43 SHEETS

TRAFFIC SIGN  
 SUMMARY SHEET #10

TRAFFIC SIGN SUMMARY SHEET

MILEMARKER, STATION, OR SIGN NUMBER	SIGN LEGEND	SIGN DIMENSIONS	NEW AND SALVAGED SIGNS				EXIST. POSTS		NEW SIGN POSTS														REMARKS	SIGN DETAIL				
			AREA	M.U.T.C.D. NO.	SALV. SIGN	SALV. T.I.S.	RET.	SALV.	NO. OF POSTS	FLANGED CHANNEL LB./FT.			TUBULAR ALUMINUM				TUBULAR STEEL				W-SHAPE STEEL			FIG. SIZE	SIGN FRAME	DETAIL ON SHEET NUMBER	STD. SHEET NUMBER	
										1.12	2.0	3.0	3.0"φ	4.0"φ	FOUND-ACTION	3"φ	3.5"φ	4.0"φ	5.0"φ	POST SIZE	WEIGHT	24"						30"
MM 21.39 RT		12' X 36'	3.00	DM-3R																						SEE SHEET 20 FOR SIGN PLACEMENT DIMENSIONS	21	
MM 21.39 LT		12' X 36'	3.00	DM-3L																						SEE SHEET 20 FOR SIGN PLACEMENT DIMENSIONS	21	
MM 21.39 LT		18' X 18'	2.25	R3-1A																						SEE SHEET 20 FOR SIGN PLACEMENT DIMENSIONS		E-150
MM 21.43 RT		18' X 18'	2.25	R3-1A																						SEE SHEET 20 FOR SIGN PLACEMENT DIMENSIONS		E-150
MM 21.45 LT		18' X 18' 24' X 30'	7.25																							SEE SHEET 20 FOR SIGN PLACEMENT DIMENSIONS	21	
MM 21.46 RT		18' X 18'	2.25	R1-1																						SEE SHEET 20 FOR SIGN PLACEMENT DIMENSIONS		E-143
MM 21.46 RT		36' X 36' 24' X 18' 24' X 12'	14	W1-7																						SEE SHEET 20 FOR SIGN PLACEMENT DIMENSIONS	21	E-152
MM 21.46 RT		24' X 24' 12' X 18'	5.5	R5-3 R9-6																						SEE SHEET 20 FOR SIGN PLACEMENT DIMENSIONS		21
MM 21.46 LT		24' X 24' 12' X 18'	5.5	R5-3 R9-6																						SEE SHEET 20 FOR SIGN PLACEMENT DIMENSIONS		21
MM 21.46 LT		36' X 36' 24' X 18' 24' X 12'	14	W1-7																						SEE SHEET 20 FOR SIGN PLACEMENT DIMENSIONS	21	E-152
MM 21.46 LT		18' X 18'	2.25	R1-1																						SEE SHEET 20 FOR SIGN PLACEMENT DIMENSIONS		E-143
MM 21.47 RT		18' X 18' 24' X 30'	7.25																							SEE SHEET 20 FOR SIGN PLACEMENT DIMENSIONS		21
MM 21.49 LT		18' X 18'	2.25	R1-1																						SEE SHEET 20 FOR SIGN PLACEMENT DIMENSIONS		E-143
MM 22.15 RT		18' X 18'	2.25	R3-1A																						SEE SHEET 20 FOR SIGN PLACEMENT DIMENSIONS		E-150
MM 22.17 LT		18' X 18' 24' X 30'	7.25																							SEE SHEET 20 FOR SIGN PLACEMENT DIMENSIONS		21
MM 22.18 RT		18' X 18'	2.25	R1-1																						SEE SHEET 20 FOR SIGN PLACEMENT DIMENSIONS		E-143
MM 22.18 RT		36' X 36' 24' X 18' 24' X 12'	14	W1-7																						SEE SHEET 20 FOR SIGN PLACEMENT DIMENSIONS	21	E-152
MM 22.18 RT		24' X 24' 12' X 18'	5.5	R5-3 R9-6																						SEE SHEET 20 FOR SIGN PLACEMENT DIMENSIONS		21
FINAL POST LENGTHS ARE TO BE DETERMINED IN THE FIELD. POST SIZES ARE COMPUTED BASED ON INFORMATION FURNISHED ON THE STANDARD SHEETS AND THE TRAFFIC & SAFETY DIVISION'S " SIGN POST DESIGN GUIDELINE ".			SF.	EA.	SF.	EA.	EA.			LBS.	LBS.	LBS.	LBS.	LBS.	EA.	LBS.	LBS.	LBS.	LBS.		LBS.	EA.	EA.	<b>TRAFFIC SIGN SUMMARY SHEET #11</b>		PREPARED BY: SMR DATE: 7/8/96 CHECKED BY: _____ DATE: _____ DESIGN SUPERVISOR: _____ PROJ. NO.: _____ SIGN SUMMARY SHEET NO. 11 OF 22 SHEET 32 OF 43 SHEETS		
TOTALS			102.0							487.5	225.6	261.9	98.0	98.0														

D:\MAPS\PLANS\96\315107A11 Thu Aug 15 08:46:46 1996 CAD Plot From SHL C:\96

TRAFFIC SIGN SUMMARY SHEET

MILEMARKER, STATION, OR SIGN NUMBER	SIGN LEGEND	SIGN DIMENSIONS	NEW AND SALVAGED SIGNS		EXIST. POSTS		NEW SIGN POSTS														REMARKS	SIGN DETAIL						
			AREA	M.U.T.C.D. NO.	SALV. SIGN	SALV. T.I.S.	RET.	SALV.	NO. OF POSTS	FLANGED CHANNEL LBS./FT.			TUBULAR ALUMINUM		TUBULAR STEEL				W-SHAPE STEEL			FTG. SIZE		SIGN FRAME	DETAIL ON SHEET NUMBER	STD. SHEET NUMBER		
										1.12	2.0	3.0	3.0"φ	4.0"φ	3"φ	3.5"φ	4.0"φ	5.0"φ	POST SIZE	WEIGHT		24"	30"					
MM 22.18 LT		24' X 24' 12' X 18'	5.5	R5-3 R9-6					1			X													SEE SHEET 20 FOR SIGN PLACEMENT DIMENSIONS	21		
MM 22.18 LT		36' X 36' 24' X 18' 24' X 12'	14	W1-7					1			X													SEE SHEET 20 FOR SIGN PLACEMENT DIMENSIONS	21	E-152	
MM 22.18 LT		18' X 18'	2.25	R1-1					1		X														SEE SHEET 20 FOR SIGN PLACEMENT DIMENSIONS		E-143	
MM 22.19 RT		18' X 18' 24' X 30'	7.25						1			X													SEE SHEET 20 FOR SIGN PLACEMENT DIMENSIONS	21		
MM 22.21 LT		18' X 18'	2.25	R3-1A					1		X														SEE SHEET 20 FOR SIGN PLACEMENT DIMENSIONS		E-150	
MM 22.61 RT		18' X 18'	2.25	R3-1A					1		X														SEE SHEET 20 FOR SIGN PLACEMENT DIMENSIONS		E-150	
MM 22.63 LT		18' X 18' 24' X 30'	7.25						1			X													SEE SHEET 20 FOR SIGN PLACEMENT DIMENSIONS	21		
MM 22.64 RT		18' X 18'	2.25	R1-1					1		X														SEE SHEET 20 FOR SIGN PLACEMENT DIMENSIONS		E-143	
MM 22.64 RT		36' X 36' 24' X 18' 24' X 12'	14	W1-7					1			X													SEE SHEET 20 FOR SIGN PLACEMENT DIMENSIONS	21	E-152	
MM 22.64 RT		24' X 24' 12' X 18'	5.5	R5-3 R9-6					1			X													SEE SHEET 20 FOR SIGN PLACEMENT DIMENSIONS	21		
MM 22.64 LT		24' X 24' 12' X 18'	5.5	R5-3 R9-6					1			X													SEE SHEET 20 FOR SIGN PLACEMENT DIMENSIONS	21		
MM 22.64 LT		36' X 36' 24' X 18' 24' X 12'	14	W1-7					1			X													SEE SHEET 20 FOR SIGN PLACEMENT DIMENSIONS	21	E-152	
MM 22.64 LT		18' X 18'	2.25	R1-1					1		X														SEE SHEET 20 FOR SIGN PLACEMENT DIMENSIONS		E-143	
MM 22.65 RT		18' X 18' 24' X 30'	7.25						1			X													SEE SHEET 20 FOR SIGN PLACEMENT DIMENSIONS	21		
MM 22.67 LT		18' X 18'	2.25	R3-1A					1		X														SEE SHEET 20 FOR SIGN PLACEMENT DIMENSIONS		E-150	
MM 22.69 RT		18' X 18'	2.25	R3-1A					1		X														SEE SHEET 20 FOR SIGN PLACEMENT DIMENSIONS		E-150	
MM 22.71 LT		18' X 18' 24' X 30'	7.25						1			X													SEE SHEET 20 FOR SIGN PLACEMENT DIMENSIONS	21		
MM 22.72 RT		18' X 18'	2.25	R1-1					1		X														SEE SHEET 20 FOR SIGN PLACEMENT DIMENSIONS		E-143	
FINAL POST LENGTHS ARE TO BE DETERMINED IN THE FIELD. POST SIZES ARE COMPUTED BASED ON INFORMATION FURNISHED ON THE STANDARD SHEETS AND THE TRAFFIC & SAFETY DIVISION'S "SIGN POST DESIGN GUIDELINE".			SF.	EA.	SF.	EA.	EA.				LBS.	LBS.	LBS.	LBS.	LBS.	EA.	LBS.	LBS.	LBS.	LBS.		LBS.	EA.	EA.				
TOTALS			105.5								196.8	307.2	98.0															
											504.0		98.0															

TRAFFIC SIGN SUMMARY SHEET #12

PREPARED BY: SMR DATE: 11/8/96  
 CHECKED BY: \_\_\_\_\_ DATE: \_\_\_\_\_  
 DESIGN SUPERVISOR: \_\_\_\_\_  
 PROJ.: SHELDON-HIGHWAY TRANSPORTATION PATH  
 STP BKE (17) S  
 PROJ. NO.: \_\_\_\_\_  
 SIGN SUMMARY SHEET NO.: 12 OF 22  
 SHEET 33 OF 43 SHEETS

© SHAW-WALKER ASSOCIATES, Inc. All rights reserved. 11/8/96. CAD FILE: F116.000.dwg

TRAFFIC SIGN SUMMARY SHEET

MILEMARKER, STATION, OR SIGN NUMBER	SIGN LEGEND	SIGN DIMENSIONS	NEW AND SALVAGED SIGNS		EXIST. POSTS		NEW SIGN POSTS																REMARKS	SIGN DETAIL				
			AREA	M.U.T.C.D. NO.	SALV. SIGN	SALV. T.I.S.	RET.	SALV.	NO. OF POSTS	FLANGED CHANNEL LB./FT.			TUBULAR ALUMINUM		TUBULAR STEEL					W-SHAPE STEEL				FTG. SIZE 24" 30"	SIGN FRAME	DETAIL ON SHEET NUMBER	STD. SHEET NUMBER	
										1.12	2.0	3.0	3.0"φ	4.0"φ	3"φ	3.5"φ	4.0"φ	5.0"φ	POST SIZE	WEIGHT	POST SIZE	WEIGHT						POST SIZE
MM 22.72 RT		36' X 36' 24' X 18' 24' X 12'	14									X													SEE SHEET 20 FOR SIGN PLACEMENT DIMENSIONS	21	E-152	
MM 22.72 RT		24' X 24' 12' X 18'	5.5									X													SEE SHEET 20 FOR SIGN PLACEMENT DIMENSIONS	21		
MM 22.72 LT		24' X 24' 12' X 18'	5.5									X													SEE SHEET 20 FOR SIGN PLACEMENT DIMENSIONS	21		
MM 22.72 LT		36' X 36' 24' X 18' 24' X 12'	14									X													SEE SHEET 20 FOR SIGN PLACEMENT DIMENSIONS	21	E-152	
MM 22.72 LT		18' X 18'	2.25									X													SEE SHEET 20 FOR SIGN PLACEMENT DIMENSIONS		E-143	
MM 22.73 RT		18' X 18' 24' X 30'	7.25										X												SEE SHEET 20 FOR SIGN PLACEMENT DIMENSIONS	21		
MM 22.75 LT		18' X 18'	2.25										X												SEE SHEET 20 FOR SIGN PLACEMENT DIMENSIONS		E-150	
MM 22.92 RT		18' X 18'	2.25										X												SEE SHEET 20 FOR SIGN PLACEMENT DIMENSIONS		E-150	
MM 22.94 LT		18' X 18' 24' X 30'	7.25										X												SEE SHEET 20 FOR SIGN PLACEMENT DIMENSIONS	21		
MM 22.95 RT		18' X 18'	2.25										X												SEE SHEET 20 FOR SIGN PLACEMENT DIMENSIONS		E-143	
MM 22.95 RT		36' X 36' 24' X 18' 24' X 12'	14									X													SEE SHEET 20 FOR SIGN PLACEMENT DIMENSIONS	21	E-152	
MM 22.95 RT		24' X 24' 12' X 18'	5.5										X												SEE SHEET 20 FOR SIGN PLACEMENT DIMENSIONS	21		
MM 22.95 LT		24' X 24' 12' X 18'	5.5										X												SEE SHEET 20 FOR SIGN PLACEMENT DIMENSIONS	21		
MM 22.95 LT		36' X 36' 24' X 18' 24' X 12'	14										X												SEE SHEET 20 FOR SIGN PLACEMENT DIMENSIONS	21	E-152	
MM 22.95 LT		18' X 18'	2.25										X												SEE SHEET 20 FOR SIGN PLACEMENT DIMENSIONS		E-143	
MM 22.96 RT		18' X 18' 24' X 30'	7.25											X											SEE SHEET 20 FOR SIGN PLACEMENT DIMENSIONS	21		
MM 22.98 LT		18' X 18'	2.25											X											SEE SHEET 20 FOR SIGN PLACEMENT DIMENSIONS		E-150	
MM 23.03 RT		18' X 18'	2.25											X											SEE SHEET 20 FOR SIGN PLACEMENT DIMENSIONS		E-150	
FINAL POST LENGTHS ARE TO BE DETERMINED IN THE FIELD. POST SIZES ARE COMPUTED BASED ON INFORMATION FURNISHED ON THE STANDARD SHEETS AND THE TRAFFIC & SAFETY DIVISION'S "SIGN POST DESIGN GUIDELINE".			SF.		EA.	SF.	EA.	EA.			LBS.	LBS.	LBS.	LBS.	LBS.	EA.	LBS.	LBS.	LBS.	LBS.		LBS.	EA.	EA.		<p style="text-align: center;"><b>TRAFFIC SIGN SUMMARY SHEET #13</b></p>		
TOTALS			115.5								476.7	303.9	130.7															PREPARED BY: _____ DATE: <u>7/8/96</u> CHECKED BY: _____ DATE: _____ DESIGN SUPERVISOR: _____ PROJ.: SHELDON-RICHMOND TRANSPORTATION PATH STP BKE (17) S PROJ. NO. _____ SIGN SUMMARY SHEET NO. <u>13</u> OF <u>22</u> SHEET 34 OF 43 SHEETS

TRAFFIC SIGN SUMMARY SHEET

MILEMARKER, STATION, OR SIGN NUMBER	SIGN LEGEND	SIGN DIMENSIONS	NEW AND SALVAGED SIGNS				EXIST. POSTS		NEW SIGN POSTS														REMARKS	SIGN DETAIL			
			AREA	M.U.T.C.D. NO.	SALV. SIGN	SALV. T.I.S.	RET.	SALV.	NO. OF POSTS	FLANGED CHANNEL LB./FT.			TUBULAR ALUMINUM		TUBULAR STEEL				W-SHAPE STEEL		FIG. SIZE			SIGN FRAME	DETAIL ON SHEET NUMBER	STD. SHEET NUMBER	
										1.12	2.0	3.0	3.0"φ	4.0"φ	FOUND-ALIGN	3"φ	3.5"φ	4.0"φ	5.0"φ	POST SIZE	WEIGHT	24"					30"
MM 23.05 LT		18' X 18' 24' X 30'	7.25						1			X													SEE SHEET 20 FOR SIGN PLACEMENT DIMENSIONS	21	
MM 23.06 RT		18' X 18'	2.25	R1-1					1		X														SEE SHEET 20 FOR SIGN PLACEMENT DIMENSIONS		E-143
.M 23.06 RT		36' X 36' 24' X 18' 24' X 12'	14						1			X													SEE SHEET 20 FOR SIGN PLACEMENT DIMENSIONS	21	E-152
MM 23.06 RT		24' X 24' 12' X 18'	5.5						1			X													SEE SHEET 20 FOR SIGN PLACEMENT DIMENSIONS	21	
MM 23.06 LT		24' X 24' 12' X 18'	5.5						1			X													SEE SHEET 20 FOR SIGN PLACEMENT DIMENSIONS	21	
MM 23.06 LT		36' X 36' 24' X 18' 24' X 12'	14						1			X													SEE SHEET 20 FOR SIGN PLACEMENT DIMENSIONS	21	E-152
MM 23.06 LT		18' X 18'	2.25	R1-1					1		X														SEE SHEET 20 FOR SIGN PLACEMENT DIMENSIONS		E-143
MM 23.07 RT		18' X 18' 24' X 30'	7.25						1			X													SEE SHEET 20 FOR SIGN PLACEMENT DIMENSIONS	21	
MM 23.09 LT		18' X 18'	2.25	R3-1A					1		X														SEE SHEET 20 FOR SIGN PLACEMENT DIMENSIONS		E-150
MM 23.64 RT		18' X 18'	2.25	R3-1A					1		X														SEE SHEET 20 FOR SIGN PLACEMENT DIMENSIONS		E-150
MM 23.66 LT		18' X 18' 24' X 30'	7.25						1			X													SEE SHEET 20 FOR SIGN PLACEMENT DIMENSIONS	21	
MM 23.67 RT		18' X 18'	2.25	R1-1					1		X														SEE SHEET 20 FOR SIGN PLACEMENT DIMENSIONS		E-143
MM 23.67 RT		36' X 36' 24' X 18' 24' X 12'	14						1			X													SEE SHEET 20 FOR SIGN PLACEMENT DIMENSIONS	21	E-152
MM 23.67 RT		24' X 24' 12' X 18'	5.5						1			X													SEE SHEET 20 FOR SIGN PLACEMENT DIMENSIONS	21	
MM 23.67 LT		24' X 24' 12' X 18'	5.5						1			X													SEE SHEET 20 FOR SIGN PLACEMENT DIMENSIONS	21	
MM 23.67 LT		36' X 36' 24' X 18' 24' X 12'	14						1			X													SEE SHEET 20 FOR SIGN PLACEMENT DIMENSIONS	21	E-152
MM 23.67 LT		18' X 18'	2.25	R1-1					1		X														SEE SHEET 20 FOR SIGN PLACEMENT DIMENSIONS		E-143
MM 23.68 RT		18' X 18' 24' X 30'	7.25						1			X													SEE SHEET 20 FOR SIGN PLACEMENT DIMENSIONS	21	
FINAL POST LENGTHS ARE TO BE DETERMINED IN THE FIELD. POST SIZES ARE COMPUTED BASED ON INFORMATION FURNISHED ON THE STANDARD SHEETS AND THE TRAFFIC & SAFETY DIVISION'S " SIGN POST DESIGN GUIDELINE ".			SF.	EA.	SF.	EA.	EA.				LBS.	LBS.	LBS.	LBS.	LBS.	EA.	LBS.	LBS.	LBS.	LBS.		LBS.	EA.	EA.			
TOTALS			120.5								146.4	349.2	130.7														
											495.6		130.7														

**TRAFFIC SIGN SUMMARY SHEET #14**  
 PREPARED BY: SMR DATE: 7/8/96  
 CHECKED BY: \_\_\_\_\_ DATE: \_\_\_\_\_  
 DESIGN SUPERVISOR (PWGL): \_\_\_\_\_  
 PROJ. NO.: \_\_\_\_\_ SHELTON-RICHFORD TRANSPORTATION PATH  
 SIGN SUMMARY SHEET NO. 14 OF 22 STP BKE (17) S  
 SHEET 35 OF 43 SHEETS

TRAFFIC SIGN SUMMARY SHEET

MILEMARKER, STATION, OR SIGN NUMBER	SIGN LEGEND	SIGN DIMENSIONS	NEW AND SALVAGED SIGNS				EXIST. POSTS		NEW SIGN POSTS														REMARKS	SIGN DETAIL				
			AREA	M.U.I.C.D. NO.	SALV. SIGN	SALV. T.I.S.	RET.	SALV.	NO OF POSTS	FLANGED CHANNELL LB./FT.			TUBULAR ALUMINUM		TUBULAR STEEL					W-SHAPE STEEL		FTG. SIZE		SIGN FRAME	DETAIL ON SHEET NUMBER	STD. SHEET NUMBER		
										1/2	2.0	3.0	3.0"φ	4.0"φ	FOUND ABOVE	3"φ	3.5"φ	4.0"φ	5.0"φ	POST SIZE	WEIGHT						24"	30"
MM 23.70 LT		18' X 18'	2.25	R3-1A								X														SEE SHEET 20 FOR SIGN PLACEMENT DIMENSIONS		E-150
MM 24.18 RT		18' X 18'	2.25	R3-1A								X														SEE SHEET 20 FOR SIGN PLACEMENT DIMENSIONS		E-150
MM 24.20 LT		18' X 18' 24' X 30'	7.25																							SEE SHEET 20 FOR SIGN PLACEMENT DIMENSIONS	21	
MM 24.21 RT		18' X 18'	2.25	R1-1								X														SEE SHEET 20 FOR SIGN PLACEMENT DIMENSIONS		E-143
MM 24.21 RT		36' X 36' 24' X 18' 24' X 12'	14	W1-7									X													SEE SHEET 20 FOR SIGN PLACEMENT DIMENSIONS	21	E-152
MM 24.21 RT		24' X 24'	5.5	R5-3										X												SEE SHEET 20 FOR SIGN PLACEMENT DIMENSIONS	21	
MM 24.21 RT		12' X 18'	5.5	R9-6											X											SEE SHEET 20 FOR SIGN PLACEMENT DIMENSIONS	21	
MM 24.21 LT		24' X 24'	5.5	R5-3											X											SEE SHEET 20 FOR SIGN PLACEMENT DIMENSIONS	21	
MM 24.21 LT		12' X 18'	5.5	R9-6											X											SEE SHEET 20 FOR SIGN PLACEMENT DIMENSIONS	21	
MM 24.21 LT		36' X 36' 24' X 18' 24' X 12'	14	W1-7									X													SEE SHEET 20 FOR SIGN PLACEMENT DIMENSIONS	21	E-152
MM 24.21 LT		18' X 18'	2.25	R1-1									X													SEE SHEET 20 FOR SIGN PLACEMENT DIMENSIONS		E-143
MM 24.22 RT		18' X 18' 24' X 30'	7.25													X										SEE SHEET 20 FOR SIGN PLACEMENT DIMENSIONS	21	
MM 24.24 LT		18' X 18'	2.25	R3-1A									X													SEE SHEET 20 FOR SIGN PLACEMENT DIMENSIONS		E-150
MM 24.30 RT		24' X 30' 12' X 36'	8.00	R12-1												X										SEE SHEET 20 FOR SIGN PLACEMENT DIMENSIONS	21	
MM 24.30 LT		12' X 36'	3.00	DM-3L											X											SEE SHEET 20 FOR SIGN PLACEMENT DIMENSIONS	21	
MM 24.32 RT		12' X 36'	3.00	DM-3R											X											SEE SHEET 20 FOR SIGN PLACEMENT DIMENSIONS	21	
MM 24.32 LT		24' X 30' 12' X 36'	8.00	R12-1												X										SEE SHEET 20 FOR SIGN PLACEMENT DIMENSIONS	21	
MM 24.33 RT		18' X 18'	2.25	R3-1A												X										SEE SHEET 20 FOR SIGN PLACEMENT DIMENSIONS		E-150
MM 24.35 LT		18' X 18' 24' X 30'	7.25														X									SEE SHEET 20 FOR SIGN PLACEMENT DIMENSIONS	21	
MM 24.36 RT		18' X 18'	2.25	R1-1													X									SEE SHEET 20 FOR SIGN PLACEMENT DIMENSIONS		E-143
FINAL POST LENGTHS ARE TO BE DETERMINED IN THE FIELD. POST SIZES ARE COMPUTED BASED ON INFORMATION FURNISHED ON THE STANDARD SHEETS AND THE TRAFFIC & SAFETY DIVISION'S "SIGN POST DESIGN GUIDELINE".			SF.	EA.	SF.	EA.	EA.				LBS.	LBS.	LBS.	LBS.	LBS.	EA.	LBS.	LBS.	LBS.	LBS.		LBS.	EA.	EA.				
TOTALS			98.5									542.7	315.9	65.4	65.4													

**TRAFFIC SIGN SUMMARY SHEET #15**  
 PREPARED BY: SMR DATE: 7/8/96  
 CHECKED BY: \_\_\_\_\_ DATE: \_\_\_\_\_  
 DESIGN SUPERVISOR: \_\_\_\_\_  
 PROJ. NO.: SHELTON-RICHFORD TRANSPORTATION PATH  
 SIGN SUMMARY SHEET NO. 15 OF 22  
 SHEET 36 OF 43 SHEETS



TRAFFIC SIGN SUMMARY SHEET

MILEMARKER, STATION, OR SIGN NUMBER	SIGN LEGEND	SIGN DIMENSIONS	NEW AND SALVAGED SIGNS				EXIST. POSTS		NEW SIGN POSTS														REMARKS	SIGN DETAIL					
			AREA	M.U.T.C.D. NO.	SALV. SIGN	SALV. T.I.S.	RET.	SALV.	NO. OF POSTS	FLANGED CHANNEL LB./FT.			TUBULAR ALUMINUM		TUBULAR STEEL				W-SHAPE STEEL		TUB. SIZE			SIGN FRAME	DETAIL ON SHEET NUMBER	STD. SHEET NUMBER			
										1.12	2.0	3.0	3.0"φ	4.0"φ	FOUNDATION	3"φ	3.5"φ	4.0"φ	5.0"φ	POST SIZE	WEIGHT	24"					30"		
MM 24.97 LT		12' X 36'	3.00	DM-3L																						SEE SHEET 20 FOR SIGN PLACEMENT DIMENSIONS	21		
MM 24.98 RT		12' X 36'	3.00	DM-3R																						SEE SHEET 20 FOR SIGN PLACEMENT DIMENSIONS	21		
MM 24.98 LT		12' X 36'	3.00	DM-3L																						SEE SHEET 20 FOR SIGN PLACEMENT DIMENSIONS	21		
MM 26.49 RT		24' X 30' 12' X 36'	8.00	R12-1 DM-3R																						SEE SHEET 20 FOR SIGN PLACEMENT DIMENSIONS	21		
MM 26.49 LT		12' X 36'	3.00	DM-3L																						SEE SHEET 20 FOR SIGN PLACEMENT DIMENSIONS	21		
MM 26.51 RT		12' X 36'	3.00	DM-3R																						SEE SHEET 20 FOR SIGN PLACEMENT DIMENSIONS	21		
MM 26.51 LT		24' X 30' 12' X 36'	8.00	R12-1 DM-3L																						SEE SHEET 20 FOR SIGN PLACEMENT DIMENSIONS	21		
MM 26.58 RT		18' X 18'	2.25	R3-1A																						SEE SHEET 20 FOR SIGN PLACEMENT DIMENSIONS		E-150	
MM 26.60 LT		18' X 18' 24' X 30'	7.25																							SEE SHEET 20 FOR SIGN PLACEMENT DIMENSIONS	21		
MM 26.61 RT		18' X 18'	2.25	R1-1																						SEE SHEET 20 FOR SIGN PLACEMENT DIMENSIONS		E-143	
MM 26.61 RT		36' X 36' 24' X 18' 24' X 12'	14																							SEE SHEET 20 FOR SIGN PLACEMENT DIMENSIONS	21	E-152	
MM 26.61 RT		24' X 24' 12' X 18'	5.5	R5-3 R9-6																						SEE SHEET 20 FOR SIGN PLACEMENT DIMENSIONS	21		
MM 26.61 LT		24' X 24' 12' X 18'	5.5	R5-3 R9-6																						SEE SHEET 20 FOR SIGN PLACEMENT DIMENSIONS	21		
MM 26.61 LT		36' X 36' 24' X 18' 24' X 12'	14																							SEE SHEET 20 FOR SIGN PLACEMENT DIMENSIONS	21	E-152	
MM 26.61 LT		18' X 18'	2.25	R1-1																						SEE SHEET 20 FOR SIGN PLACEMENT DIMENSIONS		E-143	
MM 26.62 RT		18' X 18' 24' X 30'	7.25																							SEE SHEET 20 FOR SIGN PLACEMENT DIMENSIONS	21		
MM 26.64 LT		18' X 18'	2.25	R3-1A																						SEE SHEET 20 FOR SIGN PLACEMENT DIMENSIONS		E-150	
MM 26.66 RT		24' X 30' 12' X 36'	8.00	R12-1 DM-3R																						SEE SHEET 20 FOR SIGN PLACEMENT DIMENSIONS	21		
FINAL POST LENGTHS ARE TO BE DETERMINED IN THE FIELD. POST SIZES ARE COMPUTED BASED ON INFORMATION FURNISHED ON THE STANDARD SHEETS AND THE TRAFFIC & SAFETY DIVISION'S "SIGN POST DESIGN GUIDELINE".			SF.	EA.	SF.	EA.	EA.				LBS.	LBS.	LBS.	LBS.	LBS.	EA.	LBS.	LBS.	LBS.	LBS.		LBS.	EA.	EA.					
TOTALS			101.5								233.4	318.6	65.4	65.4															
											552.0		65.4																

TRAFFIC SIGN SUMMARY SHEET #17

PREPARED BY \_\_\_\_\_ DATE 11/8/96  
 CHECKED BY \_\_\_\_\_ DATE \_\_\_\_\_  
 DESIGN SUPERVISOR (PROJ.) \_\_\_\_\_  
 SHELTON-RICHFORD TRANSPORTATION PATH  
 STP BIKE (17) S  
 PROJ. NO. \_\_\_\_\_  
 SIGN SUMMARY SHEET NO. 17 OF 22  
 SHEET 38 OF 43 SHEETS



TRAFFIC SIGN SUMMARY SHEET

MILE MARKER, STATION, OR SIGN NUMBER	SIGN LEGEND	SIGN DIMENSIONS	NEW AND SALVAGED SIGNS		EXIST. POSTS		NEW SIGN POSTS														REMARKS	SIGN DETAIL								
			AREA	M.U.T.C.D. NO.	SALV. SIGN	SALV. T.I.S.	RET.	SALV.	NO. OF POSTS	FLANGED CHANNEL LB./FT.			TUBULAR ALUMINUM		TUBULAR STEEL					W-SHAPE STEEL		FIG. SIZE	SIGN FRAME	DETAIL ON SHEET NUMBER	STD. SHEET NUMBER					
										1.12	2.0	3.0	3.0"φ	4.0"φ	FOUNDA-TION	3"φ	3.5"φ	4.0"φ	5.0"φ	POST SIZE						WEIGHT	24"	30"		
MM 16.91 LT		36' X 36'	9.00							1			X													SEE SHEET 20 FOR SIGN PLACEMENT DIMENSIONS	21			
MM 14.96 RT		36' X 36'	9.00							1			X													SEE SHEET 20 FOR SIGN PLACEMENT DIMENSIONS	21			
MM 17.56 LT		36' X 36'	9.00							1			X													SEE SHEET 20 FOR SIGN PLACEMENT DIMENSIONS	21			
MM 17.56 RT		36' X 36'	9.00							1			X													SEE SHEET 20 FOR SIGN PLACEMENT DIMENSIONS	21			
MM 19.94 LT		36' X 36'	9.00							1			X													SEE SHEET 20 FOR SIGN PLACEMENT DIMENSIONS	21			
MM 19.94 RT		36' X 36'	9.00							1			X													SEE SHEET 20 FOR SIGN PLACEMENT DIMENSIONS	21			
MM 20.42 LT		36' X 36'	9.00							1			X													SEE SHEET 20 FOR SIGN PLACEMENT DIMENSIONS	21			
MM 20.42 RT		36' X 36'	9.00							1			X													SEE SHEET 20 FOR SIGN PLACEMENT DIMENSIONS	21			
MM 11.66 RT		12' X 36' (2)	6.00	DM-3R						2		X														SEE SHEET 19 FOR SIGN PLACEMENT DIMENSIONS	21			
MM 11.66 LT		12' X 36' (2)	6.00	DM-3L						2		X														SEE SHEET 19 FOR SIGN PLACEMENT DIMENSIONS	21			
FINAL POST LENGTHS ARE TO BE DETERMINED IN THE FIELD. POST SIZES ARE COMPUTED BASED ON INFORMATION FURNISHED ON THE STANDARD SHEETS AND THE TRAFFIC & SAFETY DIVISION'S " SIGN POST DESIGN GUIDELINE ".			SF.		EA.	SF.	EA.	EA.			LBS.	LBS.	LBS.	LBS.	LBS.	EA.	LBS.	LBS.	LBS.	LBS.		LBS.	EA.	EA.		TRAFFIC SIGN SUMMARY SHEET #19		PREPARED BY: SMR	DATE: 7/8/96	
			156								816																	PROJ. NO. SHELTON-RICHFORD TRANSPORTATION PATH STP BKKE (17) S	DATE: _____	
			TOTALS																										SIGN SUMMARY SHEET NO. 19 OF 22	SHEET 40 OF 43 SHEETS

0. DATA FROM 12-88853-1308-14-9. THE DATE IS 17-54-12-1996. CADD FILED FROM BKM CORP.

TRAFFIC SIGN SUMMARY SHEET

MILEMARKER, STATION, OR SIGN NUMBER	SIGN LEGEND	SIGN DIMENSIONS	NEW AND SALVAGED SIGNS					EXIST. POSTS		NEW SIGN POSTS															REMARKS	SIGN DETAIL		
			AREA	M.U.T.C.D. NO.	SALV. SIGN	SALV. T.I.S.	RET.	SALV.	NO. OF POSTS	FLANGED CHANNEL LB./FT.			TUBULAR ALUMINUM		TUBULAR STEEL					W-SHAPE STEEL		FTG. SIZE		SIGN FRAME				
										1.1/2	2.0	3.0	3.0"Ø	4.0"Ø	3"Ø	3.5"Ø	4.0"Ø	5.0"Ø	POST SIZE	WEIGHT	24"	30"						
MM 11.91 RT		12' X 36' (2)	6.00	DM-3R					2		X															SEE SHEET 19 FOR SIGN PLACEMENT DIMENSIONS	21	
MM 11.91 LT		12' X 36' (2)	6.00	DM-3L					2		X															SEE SHEET 19 FOR SIGN PLACEMENT DIMENSIONS	21	
MM 12.05 RT		12' X 36' (2)	6.00	DM-3R					2		X															SEE SHEET 19 FOR SIGN PLACEMENT DIMENSIONS	21	
MM 12.05 LT		12' X 36' (2)	6.00	DM-3L					2		X															SEE SHEET 19 FOR SIGN PLACEMENT DIMENSIONS	21	
MM 12.28 RT		12' X 36' (2)	6.00	DM-3R					2		X															SEE SHEET 19 FOR SIGN PLACEMENT DIMENSIONS	21	
MM 12.28 LT		12' X 36' (2)	6.00	DM-3L					2		X															SEE SHEET 19 FOR SIGN PLACEMENT DIMENSIONS	21	
MM 12.35 RT		12' X 36' (2)	6.00	DM-3R					2		X															SEE SHEET 19 FOR SIGN PLACEMENT DIMENSIONS	21	
MM 12.35 LT		12' X 36' (2)	6.00	DM-3L					2		X															SEE SHEET 19 FOR SIGN PLACEMENT DIMENSIONS	21	
MM 12.54 RT		12' X 36' (2)	6.00	DM-3R					2		X															SEE SHEET 19 FOR SIGN PLACEMENT DIMENSIONS	21	
MM 12.54 LT		12' X 36' (2)	6.00	DM-3L					2		X															SEE SHEET 19 FOR SIGN PLACEMENT DIMENSIONS	21	
MM 13.75 RT		12' X 36' (2)	6.00	DM-3R					2		X															SEE SHEET 19 FOR SIGN PLACEMENT DIMENSIONS	21	
MM 13.75 LT		12' X 36' (2)	6.00	DM-3L					2		X															SEE SHEET 19 FOR SIGN PLACEMENT DIMENSIONS	21	
MM 13.84 RT		12' X 36' (2)	6.00	DM-3R					2		X															SEE SHEET 19 FOR SIGN PLACEMENT DIMENSIONS	21	
MM 13.84 LT		12' X 36' (2)	6.00	DM-3L					2		X															SEE SHEET 19 FOR SIGN PLACEMENT DIMENSIONS	21	
MM 13.91 RT		12' X 36' (2)	6.00	DM-3R					2		X															SEE SHEET 19 FOR SIGN PLACEMENT DIMENSIONS	21	
MM 13.91 LT		12' X 36' (2)	6.00	DM-3L					2		X															SEE SHEET 19 FOR SIGN PLACEMENT DIMENSIONS	21	
MM 14.23 RT		12' X 36' (2)	6.00	DM-3R					2		X															SEE SHEET 19 FOR SIGN PLACEMENT DIMENSIONS	21	
MM 14.23 LT		12' X 36' (2)	6.00	DM-3L					2		X															SEE SHEET 19 FOR SIGN PLACEMENT DIMENSIONS	21	
FINAL POST LENGTHS ARE TO BE DETERMINED IN THE FIELD. POST SIZES ARE COMPUTED BASED ON INFORMATION FURNISHED ON THE STANDARD SHEETS AND THE TRAFFIC & SAFETY DIVISION'S "SIGN POST DESIGN GUIDELINE".			SF.	EA.	SF.	EA.	EA.			LBS.	LBS.	LBS.	LBS.	LBS.	EA.	LBS.	LBS.	LBS.	LBS.		LBS.	EA.	EA.		TRAFFIC SIGN SUMMARY SHEET #20		PREPARED BY _____ DATE 7/8/96 CHECKED BY _____ DESIGN SUPERVISOR _____ PROJ. _____ SHELTON-RICHMOND TRANSPORTATION PATH STP BKE (1) S SIGN SUMMARY SHEET NO. 20 OF 22 SHEET 41 OF 43 SHEETS	
TOTALS											486																	

D:\DATA\VENUES\REFS\SIGN\20 The Aug 15 12:25:19 1995 CAD 201 Print SM Done

TRAFFIC SIGN SUMMARY SHEET

MILEMARKER, STATION, OR SIGN NUMBER	SIGN LEGEND	SIGN DIMENSIONS	NEW AND SALVAGED SIGNS					EXIST. POSTS		NEW SIGN POSTS														REMARKS	SIGN DETAIL				
			AREA	M.U.T.C.D. NO.	SALV. SIGN	SALV. T.I.S.	RET.	SALV.	NO. OF POSTS	FLANGED CHANNEL LB./FT.			TUBULAR ALUMINUM		TUBULAR STEEL				W-SHAPE STEEL		FIG. SIZE		SIGN FRAME		DETAIL ON SHEET NUMBER	STD. SHEET NUMBER			
										1.12	2.0	3.0	3.0"φ	4.0"φ	FOUN-DATION	3"φ	3.5"φ	4.0"φ	5.0"φ	POST SIZE	WEIGHT	24"					30"		
MM 14.52 RT		12' X 36' (2)	6.00	DM-3R						2		X														SEE SHEET 19 FOR SIGN PLACEMENT DIMENSIONS	21		
MM 14.52 LT		12' X 36' (2)	6.00	DM-3L						2		X														SEE SHEET 19 FOR SIGN PLACEMENT DIMENSIONS	21		
MM 16.32 RT		12' X 36' (2)	6.00	DM-3R						2		X														SEE SHEET 19 FOR SIGN PLACEMENT DIMENSIONS	21		
MM 16.32 LT		12' X 36' (2)	6.00	DM-3L						2		X														SEE SHEET 19 FOR SIGN PLACEMENT DIMENSIONS	21		
MM 19.48 RT		12' X 36' (2)	6.00	DM-3R						2		X														SEE SHEET 19 FOR SIGN PLACEMENT DIMENSIONS	21		
MM 19.48 LT		12' X 36' (2)	6.00	DM-3L						2		X														SEE SHEET 19 FOR SIGN PLACEMENT DIMENSIONS	21		
MM 19.98 RT		12' X 36' (2)	6.00	DM-3R						2		X														SEE SHEET 19 FOR SIGN PLACEMENT DIMENSIONS	21		
MM 19.98 LT		12' X 36' (2)	6.00	DM-3L						2		X														SEE SHEET 19 FOR SIGN PLACEMENT DIMENSIONS	21		
MM 20.61 RT		12' X 36' (2)	6.00	DM-3R						2		X														SEE SHEET 19 FOR SIGN PLACEMENT DIMENSIONS	21		
MM 20.61 LT		12' X 36' (2)	6.00	DM-3L						2		X														SEE SHEET 19 FOR SIGN PLACEMENT DIMENSIONS	21		
MM 21.38 RT		12' X 36' (2)	6.00	DM-3R						2		X														SEE SHEET 19 FOR SIGN PLACEMENT DIMENSIONS	21		
MM 21.38 LT		12' X 36' (2)	6.00	DM-3L						2		X														SEE SHEET 19 FOR SIGN PLACEMENT DIMENSIONS	21		
MM 22.22 RT		12' X 36' (2)	6.00	DM-3R						2		X														SEE SHEET 19 FOR SIGN PLACEMENT DIMENSIONS	21		
MM 22.22 LT		12' X 36' (2)	6.00	DM-3L						2		X														SEE SHEET 19 FOR SIGN PLACEMENT DIMENSIONS	21		
MM 23.43 RT		12' X 36' (2)	6.00	DM-3R						2		X														SEE SHEET 19 FOR SIGN PLACEMENT DIMENSIONS	21		
MM 23.43 LT		12' X 36' (2)	6.00	DM-3L						2		X														SEE SHEET 19 FOR SIGN PLACEMENT DIMENSIONS	21		
MM 24.96 RT		12' X 36' (2)	6.00	DM-3R						2		X														SEE SHEET 19 FOR SIGN PLACEMENT DIMENSIONS	21		
MM 24.96 LT		12' X 36' (2)	6.00	DM-3L						2		X														SEE SHEET 19 FOR SIGN PLACEMENT DIMENSIONS	21		
FINAL POST LENGTHS ARE TO BE DETERMINED IN THE FIELD. POST SIZES ARE COMPUTED BASED ON INFORMATION FURNISHED ON THE STANDARD SHEETS AND THE TRAFFIC & SAFETY DIVISION'S "SIGN POST DESIGN GUIDELINE".			SF.	EA.	SF.	EA.	EA.				LBS.	LBS.	LBS.	LBS.	LBS.	EA.	LBS.	LBS.	LBS.	LBS.		LBS.	EA.	EA.					
TOTALS			108									486																	
<p style="text-align: center;"><b>TRAFFIC SIGN SUMMARY SHEET #21</b></p> <p>PREPARED BY: SMR DATE: 7/8/96                      CHECKED BY: _____ DATE: _____                      DESIGN SUPERVISOR: _____                      PROJ. NO.: SHELTON-RICHMOND TRANSPORTATION PATH STP BKE (17) S                      SIGN SUMMARY SHEET NO. 21 OF 22                      SHEET 42 OF 43 SHEETS</p>																													

D:\DATA\PROJECTS\ASSTON\K21\_ The Aug 15 17:56:12 1996 1000 Post From SHI.Dwg

TRAFFIC SIGN SUMMARY SHEET

MILEMARKER, STATION, OR SIGN NUMBER	SIGN LEGEND	SIGN DIMENSIONS	NEW AND SALVAGED SIGNS		EXIST. POSTS		NEW SIGN POSTS														REMARKS	SIGN DETAIL						
			AREA	M.U.T.C.D. NO.	SALV. SIGN	SALV. T.I.S.	RET.	SALV.	NO. OF POSTS	FLANGED CHANNEL LB./FT.			TUBULAR ALUMINUM		TUBULAR STEEL				W-SHAPE STEEL			FTG. SIZE		SIGN FRAME	DETAIL ON SHEET NUMBER	STD. SHEET NUMBER		
										1.12	2.0	3.0	3.0"Ø	4.0"Ø	FOUND-ATION	3"Ø	3.5"Ø	4.0"Ø	5.0"Ø	POST SIZE		WEIGHT	24"				30"	
MM 3.15 RT		12' X 36' (2)	6.00	DM-3R																					SEE SHEET 19 FOR SIGN PLACEMENT DIMENSIONS	21		
MM 3.15 LT		12' X 36' (2)	6.00	DM-3L																						SEE SHEET 19 FOR SIGN PLACEMENT DIMENSIONS	21	
MM 3.27 RT		12' X 36' (2)	6.00	DM-3R																						SEE SHEET 19 FOR SIGN PLACEMENT DIMENSIONS	21	
MM 3.27 LT		12' X 36' (2)	6.00	DM-3L																						SEE SHEET 19 FOR SIGN PLACEMENT DIMENSIONS	21	
MM 3.55 RT		12' X 36' (2)	6.00	DM-3R																						SEE SHEET 19 FOR SIGN PLACEMENT DIMENSIONS	21	
MM 3.55 LT		12' X 36' (2)	6.00	DM-3L																						SEE SHEET 19 FOR SIGN PLACEMENT DIMENSIONS	21	
MM 4.31 RT		12' X 36' (2)	6.00	DM-3R																						SEE SHEET 19 FOR SIGN PLACEMENT DIMENSIONS	21	
MM 4.31 LT		12' X 36' (2)	6.00	DM-3L																						SEE SHEET 19 FOR SIGN PLACEMENT DIMENSIONS	21	
MM 6.36 RT		12' X 36' (2)	6.00	DM-3R																						SEE SHEET 19 FOR SIGN PLACEMENT DIMENSIONS	21	
MM 6.36 LT		12' X 36' (2)	6.00	DM-3L																						SEE SHEET 19 FOR SIGN PLACEMENT DIMENSIONS	21	
MM 7.45 RT		12' X 36' (2)	6.00	DM-3R																						SEE SHEET 19 FOR SIGN PLACEMENT DIMENSIONS	21	
MM 7.45 LT		12' X 36' (2)	6.00	DM-3L																						SEE SHEET 19 FOR SIGN PLACEMENT DIMENSIONS	21	
MM 9.40 RT		12' X 36' (2)	6.00	DM-3R																						SEE SHEET 19 FOR SIGN PLACEMENT DIMENSIONS	21	
MM 9.40 LT		12' X 36' (2)	6.00	DM-3L																						SEE SHEET 19 FOR SIGN PLACEMENT DIMENSIONS	21	
SEE NOTE 4 ON SHEET 20 FOR RR MM		18' X 24' (52)	156	R2-1																						SEE SHEET 20 FOR SIGN PLACEMENT DIMENSIONS		E-142
FINAL POST LENGTHS ARE TO BE DETERMINED IN THE FIELD. POST SIZES ARE COMPUTED BASED ON INFORMATION FURNISHED ON THE STANDARD SHEETS AND THE TRAFFIC & SAFETY DIVISION'S "SIGN POST DESIGN GUIDELINE".			SF.	EA.	SF.	EA.	EA.		LBS.	LBS.	LBS.	LBS.	LBS.	EA.	LBS.	LBS.	LBS.	LBS.		LBS.	EA.	EA.	SUMMARY SHEET #22		PREPARED BY: SMR CHECKED BY: _____ DESIGN SUPERVISOR: _____ PROJ. NO.: _____ SHEET SUMMARY SHEET NO. 22 OF 22 SHEET 43 OF 43 SHEETS	DATE: 7/8/96		
TOTALS			240						1678																			

© WALKER PARKER ENGINEERS The Aug 15 11:57:06 1996 CAD Plot From SMR Comp