

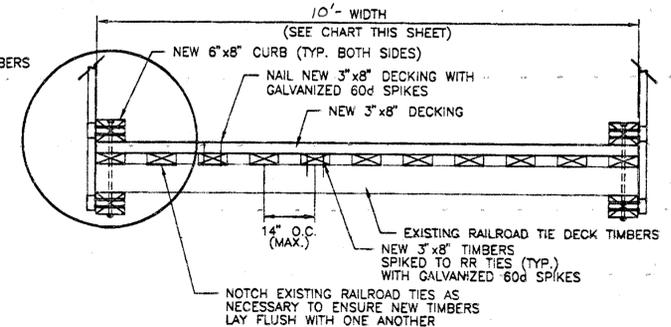


ELEVATION @ BRIDGE ABUTMENT
NOT TO SCALE

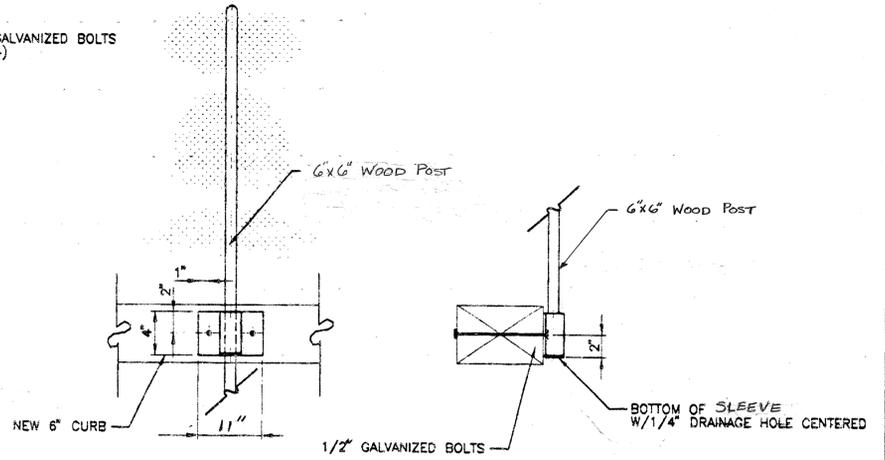

NOTE:
ALL EXISTING CURB TIMBERS TO BE REMOVED

SECTION THROUGH BRIDGE
NOT TO SCALE

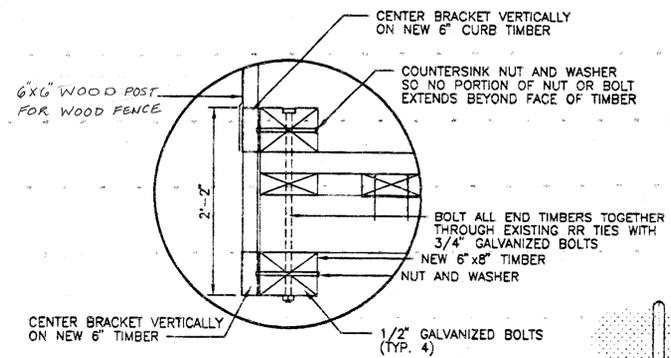


TOP BRACKET

BOTTOM BRACKET

FENCE DETAILS NOT TO SCALE

DECK

DECK TYPE B

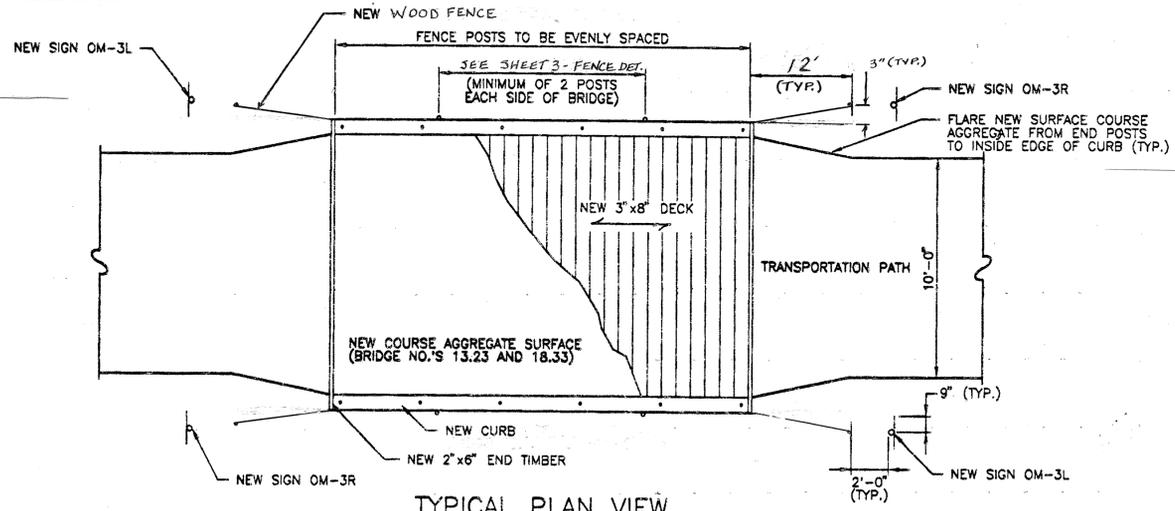

TYPICAL PLAN VIEW
NOT TO SCALE

DATUM	
VERTICAL	N/A
HORIZONTAL	N/A

BRIDGE DETAIL SHEET	SURVEYED BY	N/A	DATE	N/A
	DRAWN BY	ROSS	DATE	8/7
	SQUAD LEADER	N/A		
	DESIGN FILE NO.	SCAN BRIDGE.1		
	IPARM FILE	N/A	DATE PLOTTED	
	PROJ. NAME	BEEBE SPUR TRANSPORTATION PATH		
	PROJ. NO.	STP BIKE (19) S		
	SHEET	4	OF	20 SHEETS