



EACH SIGN PLACED ON 1 POST
1 SIGN EACH SIDE OF ROAD



BEGIN PROJECT
BEEBE SPUR
STP BIKE (19)S
RR MM 38.861

225'
225'

PROUTY DRIVE

SCI HOLDING, INC.

ORLEANS AND
NORTHERN
ESSEX HOME
HEALTH AGENCY
INC

NORTHEASTERN VERMONT
DEVELOPMENT ASSOCIATION

38.80

38.70

38.60

38.50

38.40

M. PRUE

M. FOURNIER

R&B RAMSDELL

R&G CHAFFEE

D&S KELLEY

A&M HILLIKER

R&B RHYE

K&M LACOSS

R&D GOSSELIN

D&P CHENETTE

M & P MCKINNEY

ORLEANS COUNTY
DEVELOPMENT ASSOC.

L. HAYES

LAKEMONT ROAD



EACH SIGN PLACED ON 1 POST
1 SIGN EACH SIDE OF ROAD



NOTES:


1. ALL WORK IS WITHIN EXISTING STATE OF VERMONT RIGHT-OF-WAY AND SHALL BE DONE WITHIN THE EXISTING RAILROAD BED UNLESS OTHERWISE NOTED ON PLANS OR AS DIRECTED BY THE ENGINEER
2. WIDTH OF EXISTING RIGHT-OF-WAY IS 33' EACH SIDE OF CENTERLINE
3. PROPERTY LINES ARE APPROXIMATE AND PROPERTY OWNERS MAY NOT BE ACCURATE

GUIDE POST (MOD.-BOLLARDS)
RR MM 38.860 @ (3 EA.)
(SEE DETAIL SHEET 15)

POWER GRADER RENTAL
RR MM 38.861 - RR MM 38.344
(GRADING OF EXISTING BALLAST)

GEOTEXTILE FOR ROADBED SUBGRADE SEPARATOR
RR MM 38.861 - RR MM 38.344
(PLACE UNDER AGGREGATE SURFACE COURSE - 10' WIDTH)

AGGREGATE SURFACE COURSE
RR MM 38.861 - RR MM 38.344

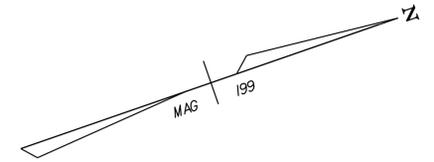

DATUM	
VERTICAL	N/A
HORIZONTAL	N/A

**ARCHIVED
IN DPR**

PLAN NOT TO SCALE

PROJECT: BEEBE SPUR	PROJECT NO. : STP BIKE(19)S
DESIGN FILE NAME: ISRVOI/LTF/BEEBE/BEEBE.DGN	PLOT DATE: 29-NOV-2004 15:
IPARM FILE NAME: LAY01	SURVEY DATE:
SURVEYED BY:	DRAWN BY: MAGNAN
SQUAD LEADER: LEWIS	SHEET: 6 OF 20