


POWER GRADER RENTAL  
RR MM 38.344 - RR MM 37.775  
(GRADING OF EXISTING BALLAST)

GEOTEXTILE FOR ROADBED SUBGRADE SEPARATOR  
RR MM 38.344 - RR MM 37.775  
(PLACE UNDER AGGREGATE SURFACE COURSE - 10' WIDTH)

AGGREGATE SURFACE COURSE  
RR MM 38.344 - RR MM 37.775

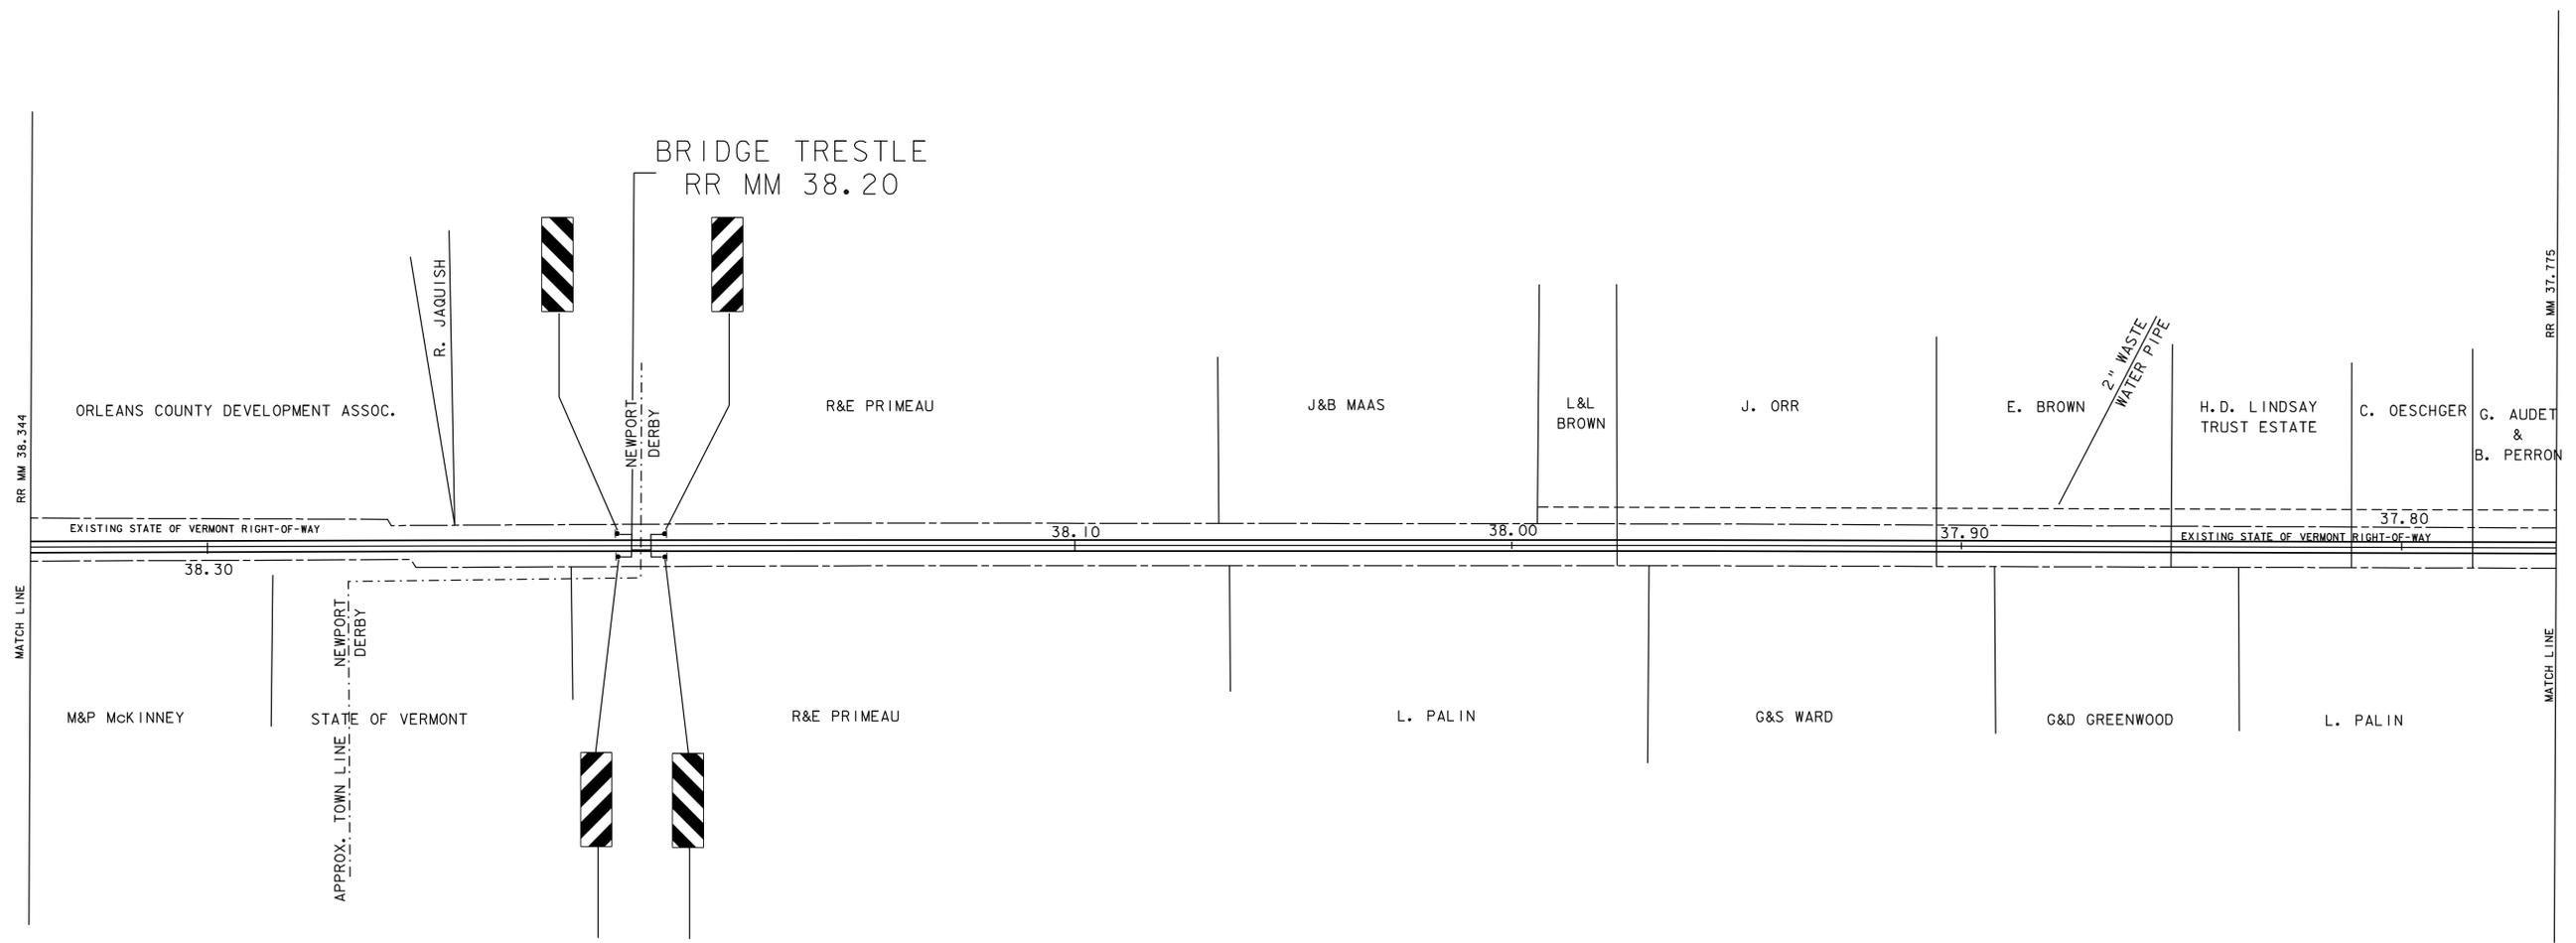

- NOTES:
1. ALL WORK IS WITHIN EXISTING STATE OF VERMONT RIGHT-OF-WAY AND SHALL BE DONE WITHIN THE EXISTING RAILROAD BED UNLESS OTHERWISE NOTED ON PLANS OR AS DIRECTED BY THE ENGINEER
  2. WIDTH OF EXISTING RIGHT-OF-WAY IS 33' EACH SIDE OF CENTERLINE
  3. PROPERTY LINES ARE APPROXIMATE AND PROPERTY OWNERS MAY NOT BE ACCURATE

PLAN NOT TO SCALE

DATUM	
VERTICAL	N/A
HORIZONTAL	N/A

**ARCHIVED  
IN DPR**

PROJECT: BEEBE SPUR	PROJECT NO. : STP BIKE(19)S
DESIGN FILE NAME: ISRVOI/LTF/BEEBE/BEEBE.DGN	PLOT DATE: 29-NOV-2004 15
IPARM FILE NAME: LAY02.I	SURVEY DATE:
SURVEYED BY:	DRAWN BY: MAGNAN
SQUAD LEADER: LEWIS	SHEET: 7 OF 20