


GUIDE POST (MOD.-BOLLARDS)  
 RR MM 37.740 @ (3 EA.)  
 RR MM 37.750 @ (3 EA.)  
 (SEE DETAIL SHEET 15)

POWER GRADER RENTAL  
 RR MM 37.775 - RR MM 37.207  
 (GRADING OF EXISTING BALLAST)

GEOTEXTILE FOR ROADBED SUBGRADE SEPARATOR  
 RR MM 37.775 - RR MM 37.207  
 (PLACE UNDER AGGREGATE SURFACE COURSE - 10' WIDTH)

AGGREGATE SURFACE COURSE  
 RR MM 37.775 - RR MM 37.207

# LAKE MEMPHREMAGOG

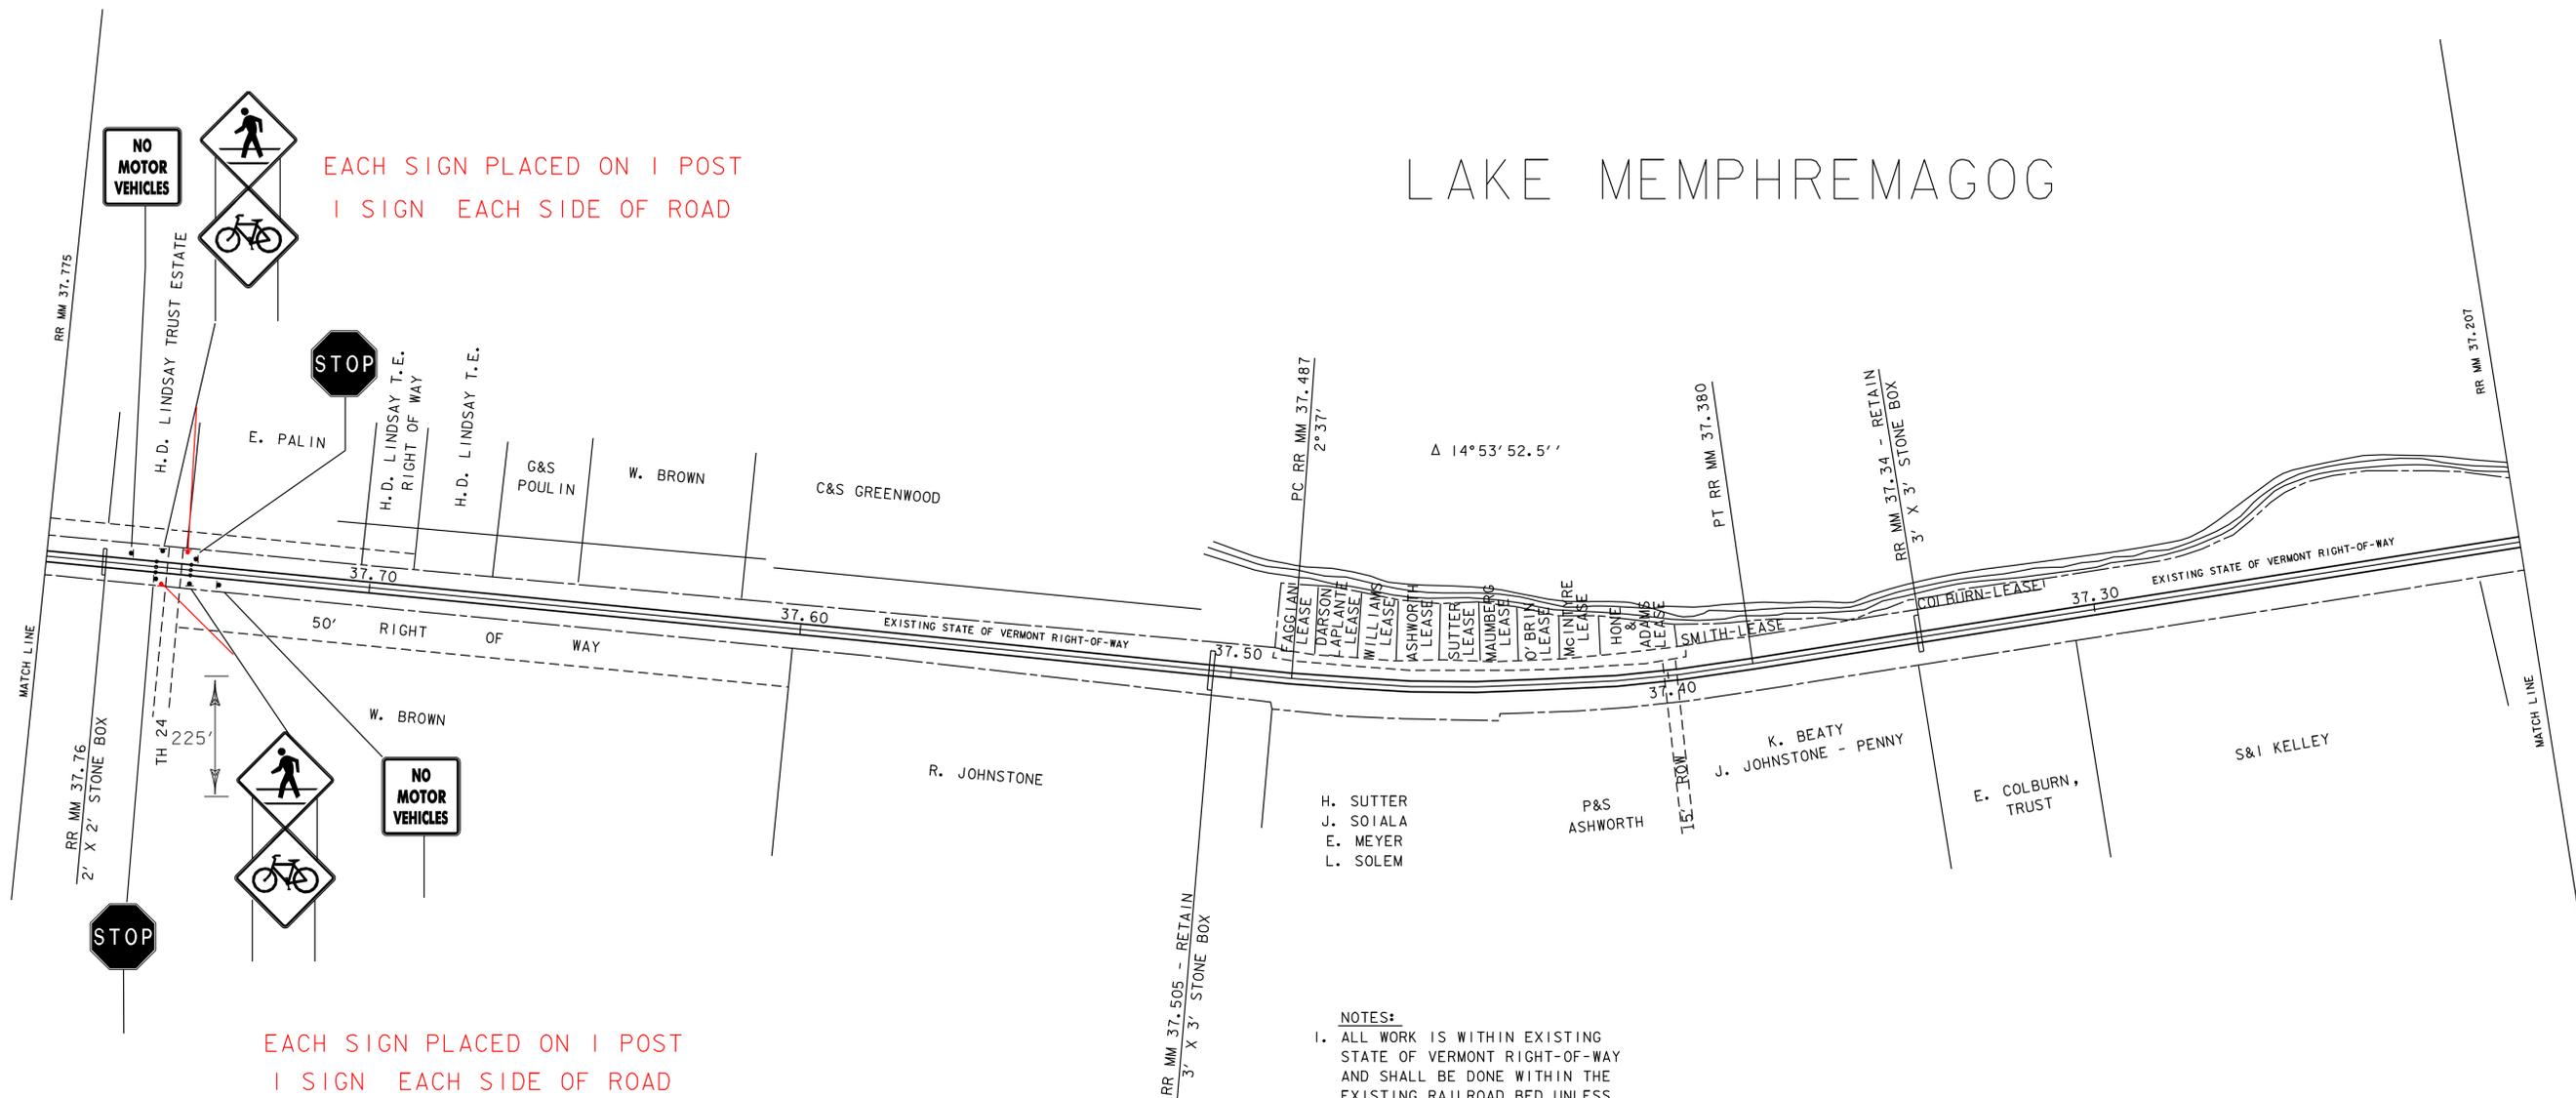

- NOTES:
1. ALL WORK IS WITHIN EXISTING STATE OF VERMONT RIGHT-OF-WAY AND SHALL BE DONE WITHIN THE EXISTING RAILROAD BED UNLESS OTHERWISE NOTED ON PLANS OR AS DIRECTED BY THE ENGINEER
  2. WIDTH OF EXISTING RIGHT-OF-WAY IS 33' EACH SIDE OF CENTERLINE
  3. PROPERTY LINES ARE APPROXIMATE AND PROPERTY OWNERS MAY NOT BE ACCURATE

**ARCHIVED  
IN DPR**

PLAN NOT TO SCALE

DATUM	
VERTICAL	N/A
HORIZONTAL	N/A

PROJECT: BEEBE SPUR	PROJECT NO. : STP BIKE(19)S
DESIGN FILE NAME: ISRVOI/LTF/BEEBE/BEEBE.DGN	PLOT DATE: 29-NOV-2004 15:
IPARM FILE NAME: LAY03.I	SURVEY DATE:
SURVEYED BY:	DRAWN BY: MAGNAN
SQUAD LEADER: LEWIS	SHEET: 8 OF 20