


LAKE

MEMPHAMAGOG

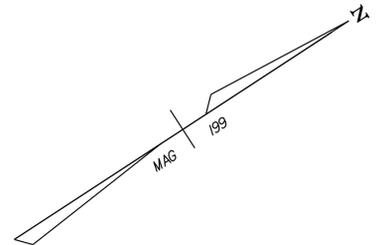

GUIDE POST (MOD.-BOLLARDS)

RR MM 35.710 @ (3 EA.)
RR MM 35.690 @ (3 EA.)
(SEE DETAIL SHEET 15)

POWER GRADER RENTAL

RR MM 36.071 - RR MM 35.502
(GRADING OF EXISTING BALLAST)


GEOTEXTILE FOR ROADBED SUBGRADE SEPARATOR

RR MM 36.071 - RR MM 35.502
(PLACE UNDER AGGREGATE SURFACE COURSE - 10' WIDTH)

AGGREGATE SURFACE COURSE

RR MM 36.071 - RR MM 35.502

EACH SIGN PLACED ON 1 POST

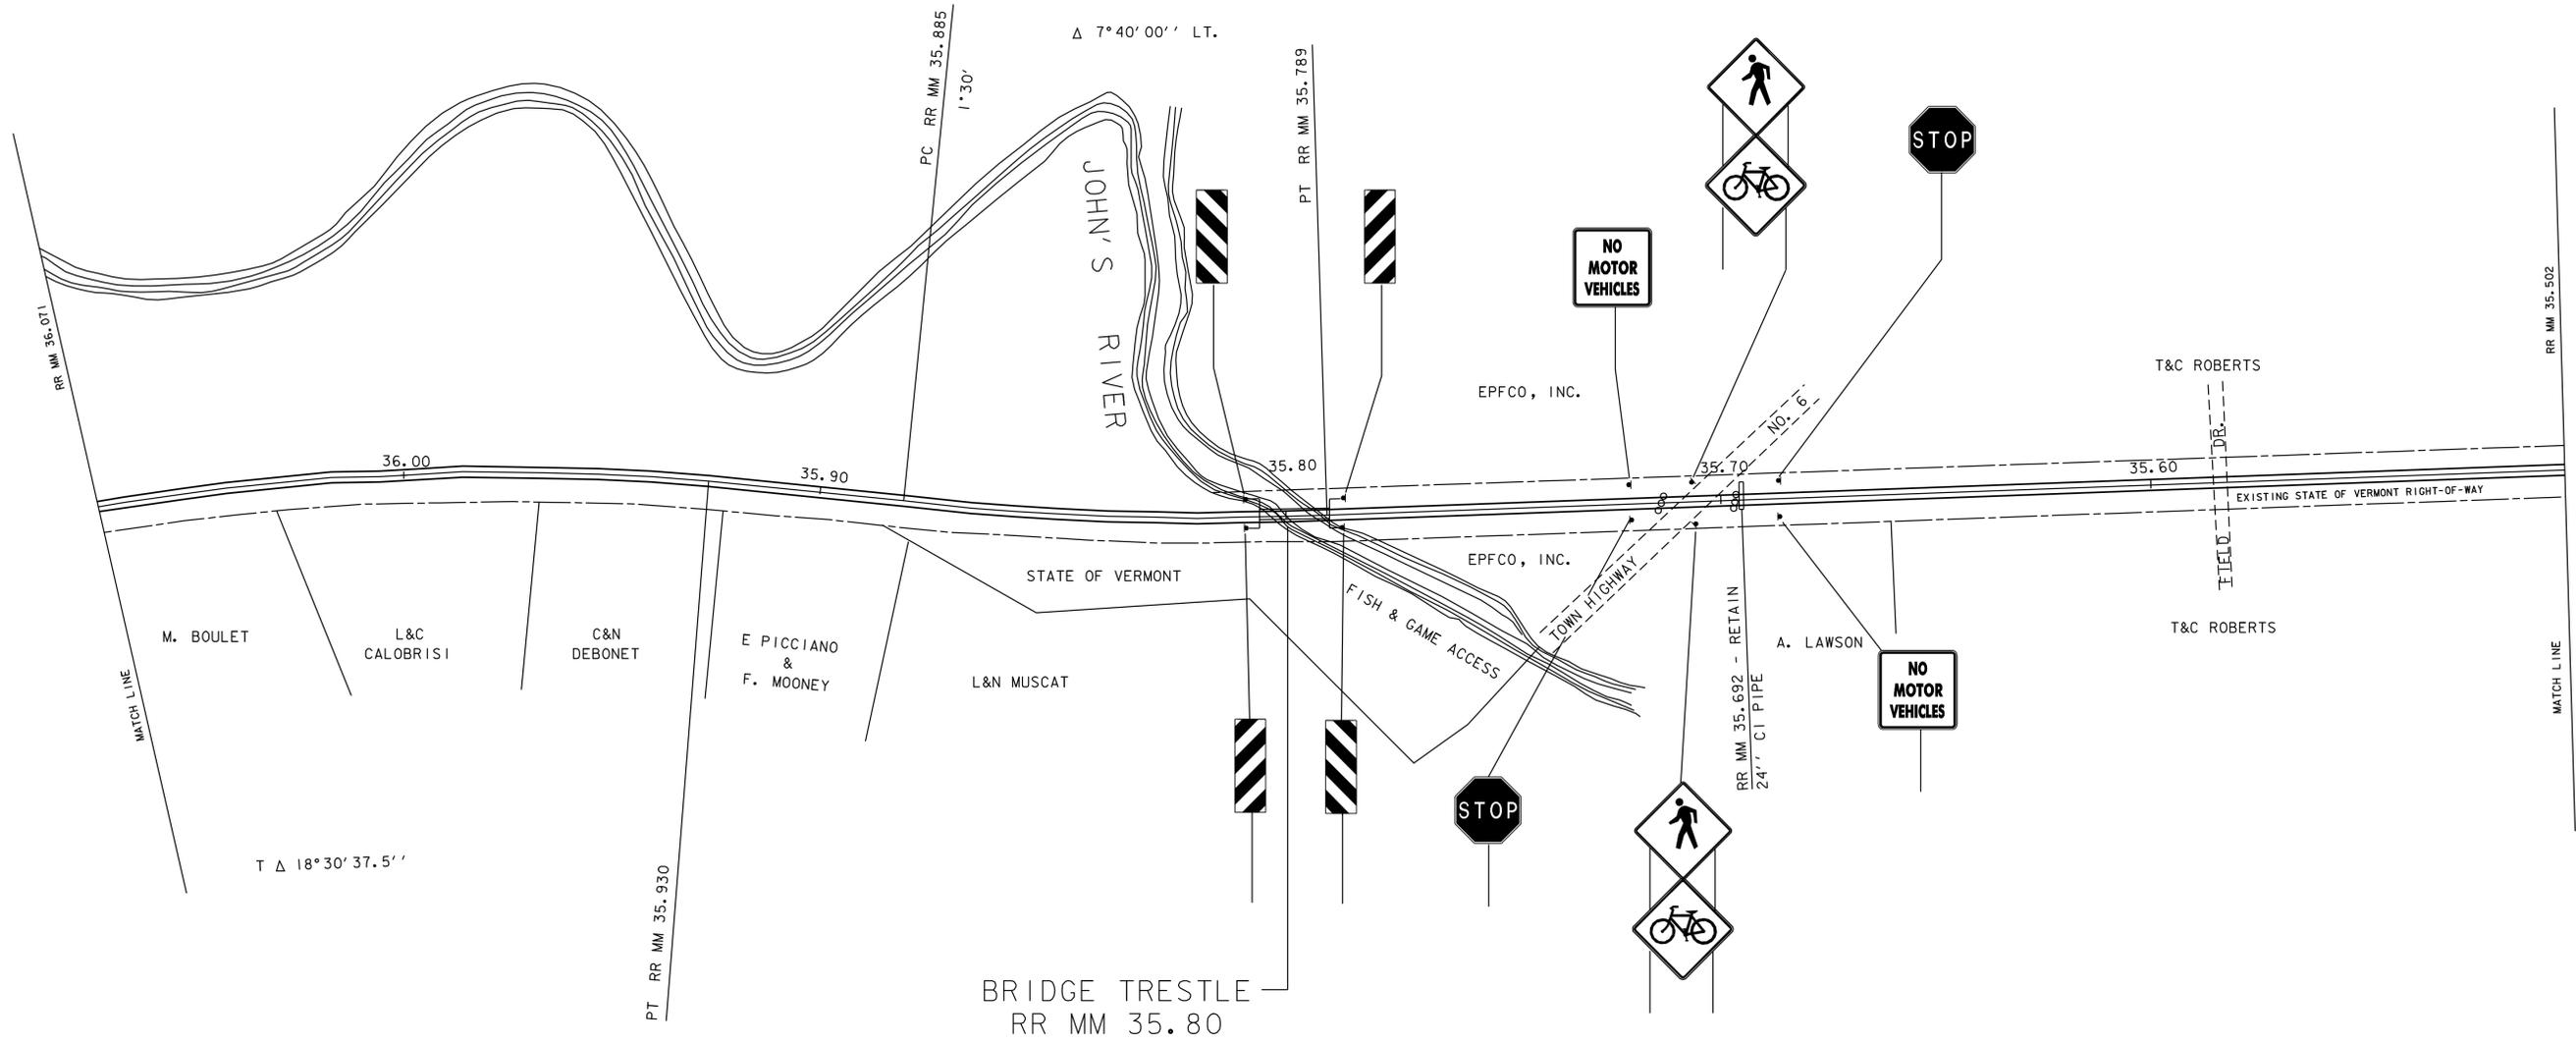

EACH SIGN PLACED ON 1 POST

1 SIGN EACH SIDE OF ROAD

NOTES:

1. ALL WORK IS WITHIN EXISTING STATE OF VERMONT RIGHT-OF-WAY AND SHALL BE DONE WITHIN THE EXISTING RAILROAD BED UNLESS OTHERWISE NOTED ON PLANS OR AS DIRECTED BY THE ENGINEER
2. WIDTH OF EXISTING RIGHT-OF-WAY IS 33' EACH SIDE OF CENTERLINE
3. PROPERTY LINES ARE APPROXIMATE AND PROPERTY OWNERS MAY NOT BE ACCURATE

DATUM	
VERTICAL	N/A
HORIZONTAL	N/A

**ARCHIVED
IN DPR**

PLAN NOT TO SCALE

PROJECT: BEEBE_SPUR	PROJECT NO. : SIP_BIKE(19)S_
DESIGN FILE NAME: ISRV04\LAIE\BEEBE\BEEBE.DGN	PLOT DATE: 29-NOV-2004 15
IPARM FILE NAME: LAY06.I	SURVEY DATE:
SQUAD LEADER: LEWIS	DRAWN BY: MAGNAN
	SHEET: 11 OF 20