


NOTE:

1. CONSTRUCTION APPROACH SIGNING SHALL BE IN ACCORDANCE WITH THE PLAN AND DETAIL, STANDARD SHEET E-100 AND CHAPTER 6 OF THE M. U. T. C. D.
2. THIS DETAIL APPLIES TO CROSSINGS AT THE FOLLOWING LOCATIONS
 - RR MM 38.861 (PROUTY DRIVE)
 - RR MM 37.750 (LINDSAY ROAD)
 - RR MM 35.704 (TH-6)
 - RR MM 35.029 (TH-6)

TYPICAL APPROACH SIGNING DETAIL

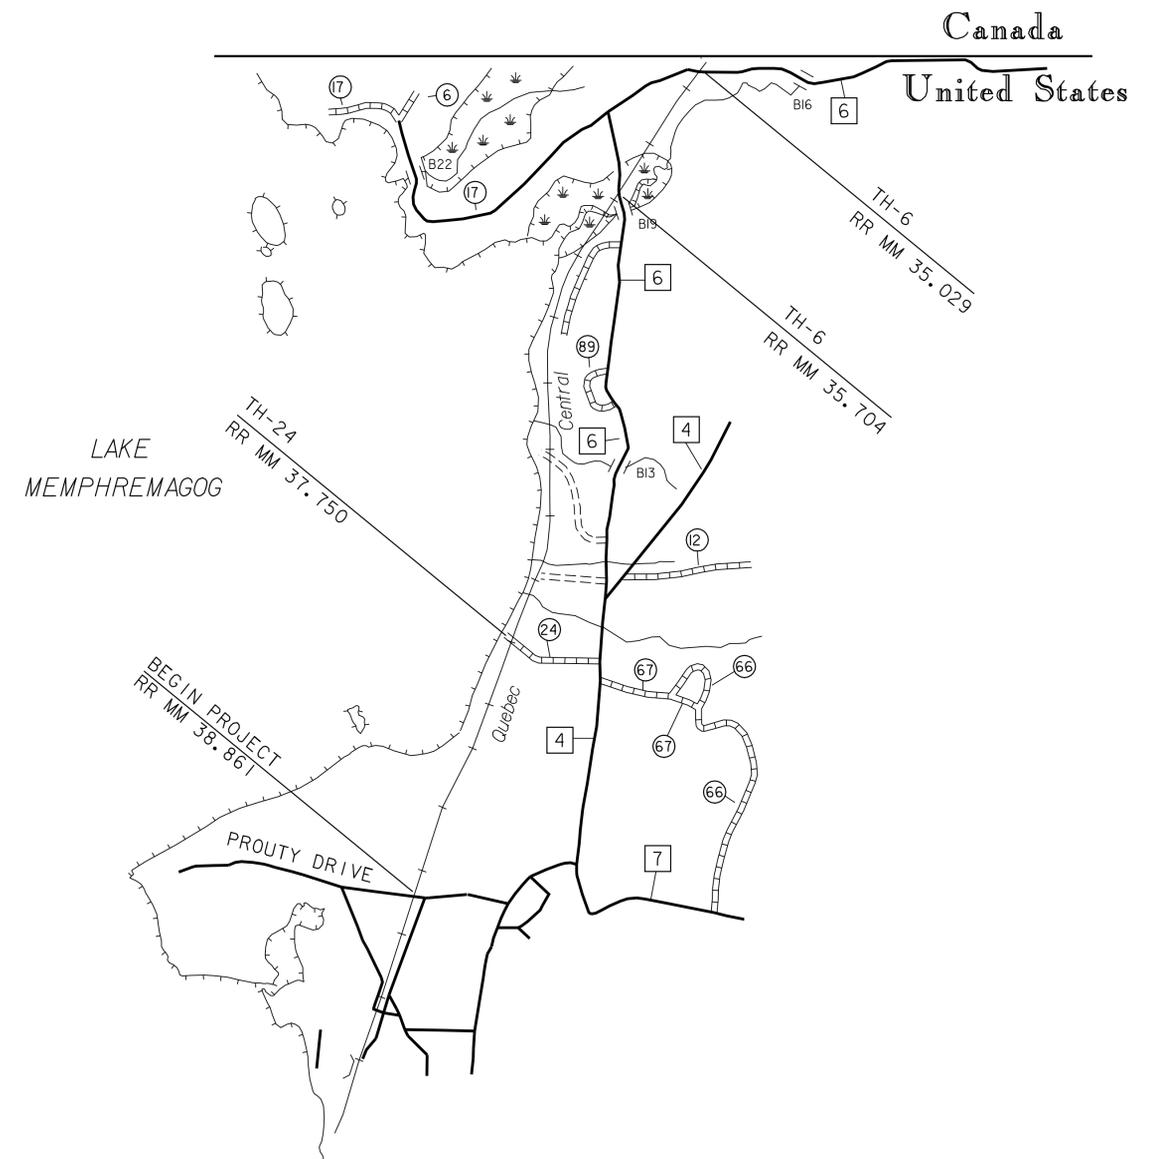

APPROACH SIGNING PLAN

NOT TO SCALE

DATUM	
VERTICAL	_____
HORIZONTAL	_____

**ARCHIVED
IN DPR**

PROJECT: BEEBE SPUR	PROJECT NO. : STP BIKE (19)S
DESIGN FILE NAME: ISRV01/LTF/BEEBE/BEEBE.DGN	PLOT DATE: 29-NOV-2004 15
IPARM FILE NAME: csign.l	SURVEY DATE:
SURVEYED BY:	DRAWN BY: ROSS
SQUAD LEADER: LEWIS	SHEET: 16 OF 20