


**BEGIN BRIDGE**  
**STA. 1+031.400**  
**F.G. = 78.052**


**END BRIDGE**  
**STA. 1+058.832**  
**F.G. = 78.549**

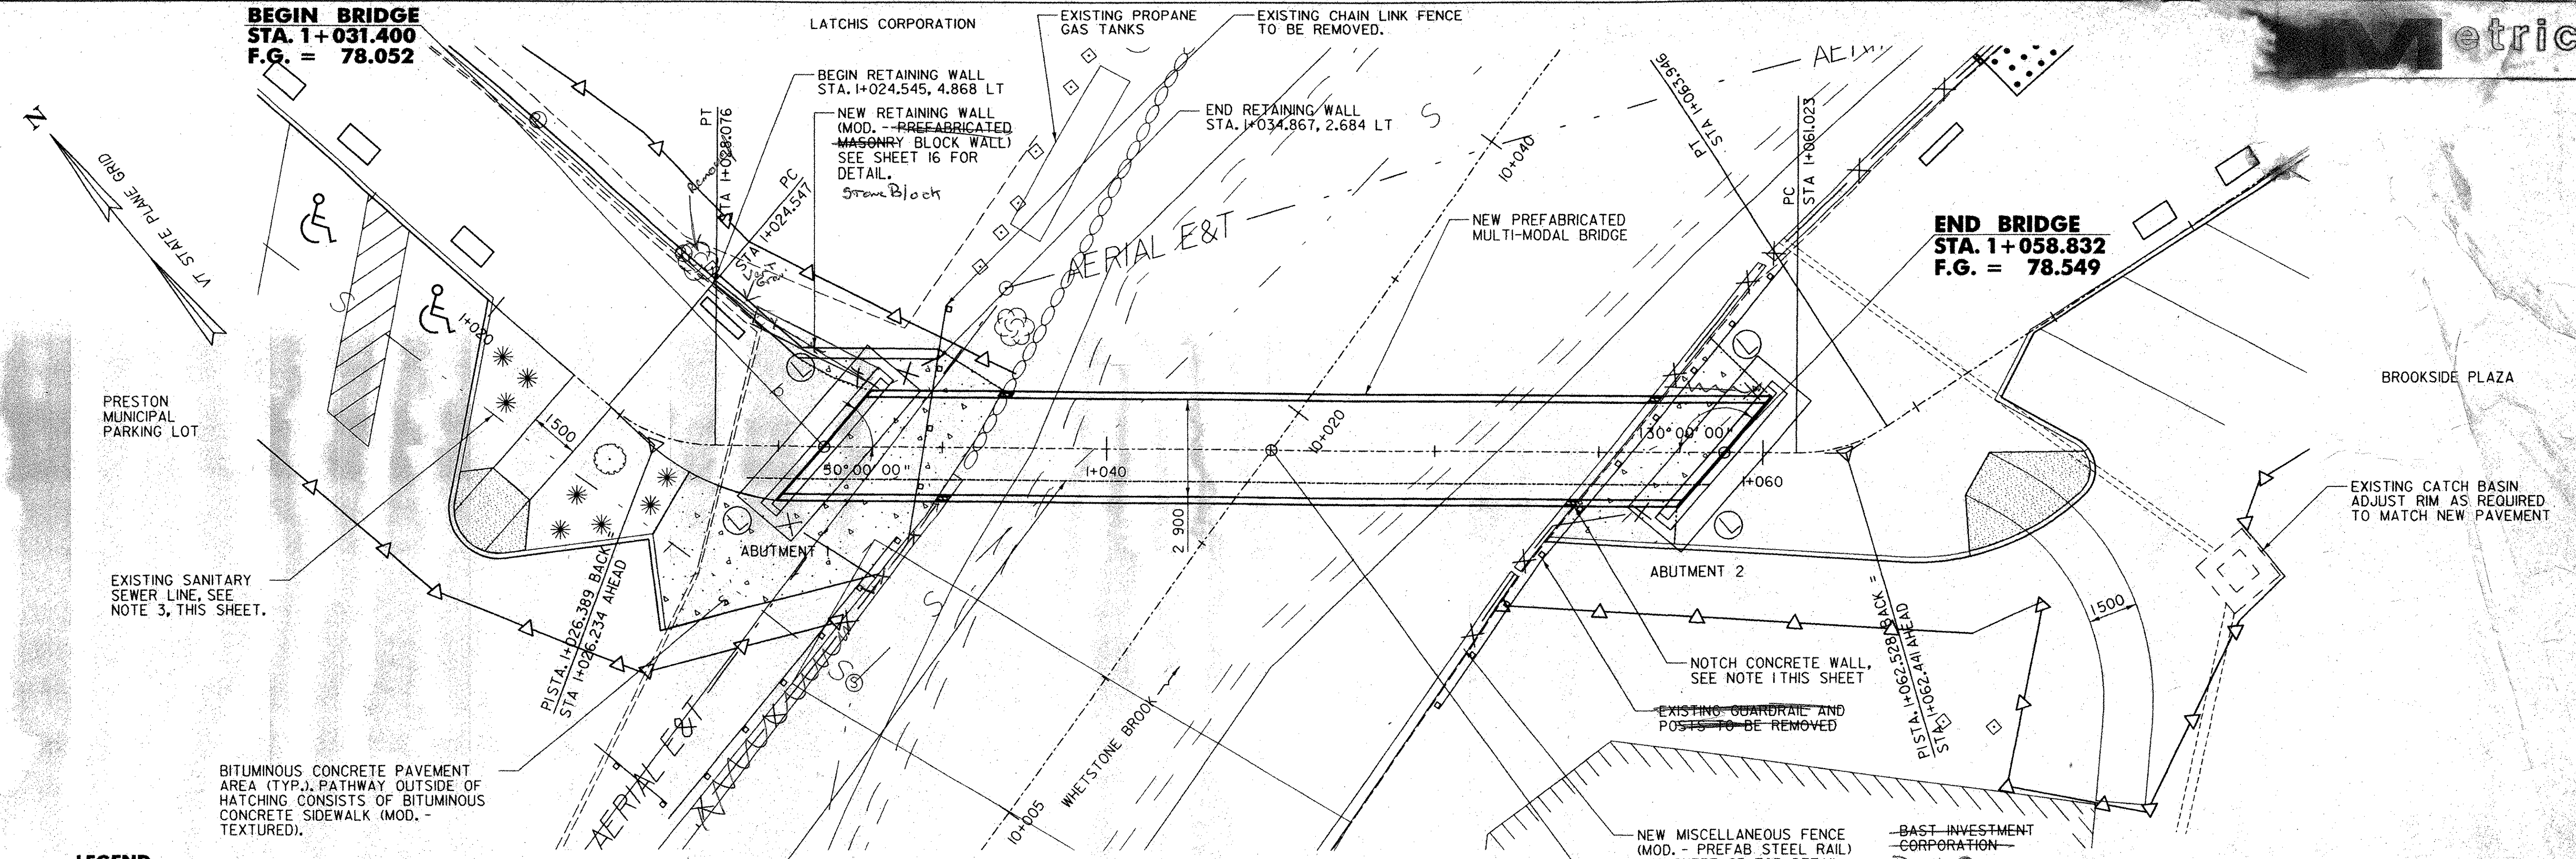

**LEGEND**



- EXISTING**
- EDGE OF PAVEMENT
  - EDGE OF RIVER
  - /// BUILDING
  - TREE
  - △ TIE POINT
  - ⊕ UTILITY POLE
  - ⊙ SEWER MANHOLE
  - STREET LIGHT
  - ⊖ SIGN
  - CULVERT
  - ⊠ CATCH BASIN
  - ⊗ STONE WALL
  - S - SEWER LINE
  - AERIAL E&T AERIAL E+T
- PROPOSED**
- ⊖ SIGN
  - VERTICAL GRANITE CURB
  - △ LIMITS OF CONSTRUCTION
  - WIRE CONDUIT UNDER BRIDGE
  - × NEW STEEL FENCE
  - ⊙ PATHWAY LIGHT
  - GRANITE BLOCKS
  - BITUMINOUS CONCRETE SIDEWALK (MOD. - TEXTURED) / BITUMINOUS CONCRETE PAVEMENT BOUNDARY

ELECTRICAL LINE AND CONDUIT TO BE INSTALLED UNDER BRIDGE TO SUPPLY ELECTRICAL POWER FOR NEW PATHWAY LIGHTS IN PRESTON PARKING LOT. SEE UTILITY SHEET FOR MORE DETAIL ON ELECTRIC CONDUIT FOR NEW LIGHT POLES. PAYMENT FOR LINE, CONDUIT, MOUNTING BRACKETS, EXPANSION JOINTS AND OTHER COMPONENTS NECESSARY TO INSTALL THE CONDUIT SHALL BE PAID INCIDENTAL TO ITEM 545.20, "PREFABRICATED MULTI-MODAL BRIDGE".

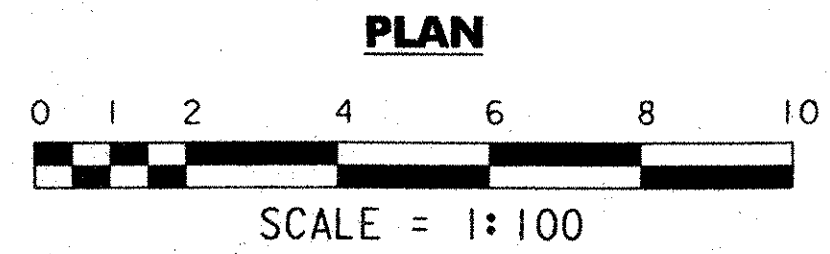


**NOTE:**

1. THE CONTRACTOR SHALL SAW CUT AND USE LIGHTWEIGHT HAMMERS TO REMOVE TOP OF CONCRETE WALL TO PROVIDE FOR ADEQUATE DRAINAGE. A MINIMUM OF 125 mm VERTICAL CLEARANCE FROM BOTTOM OF BEAM TO TOP OF CONCRETE WALL. SEE SHEET 2 FOR GRADING BETWEEN THE BEGIN/END OF BRIDGE AND CONCRETE WALL.
2. THE COLOR OF THE BRIDGE STEEL BEAMS AND THE BRIDGE RAIL SHALL BE BLACK, PAINT CHIP NO. 37038.
3. LOCATION SHOWN OF EXISTING SANITARY SEWER LINE SHOWN NEAR ABUTMENT #1 IS APPROXIMATE. SEWER SHALL NOT BE DISTURBED DURING CONSTRUCTION.
4. STATIONS ARE GIVEN IN KILOMETERS, ELEVATIONS ARE GIVEN IN METERS AND DIMENSIONS ARE GIVEN IN MILLIMETERS.

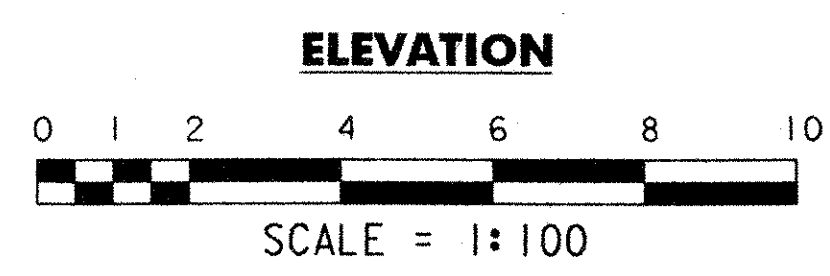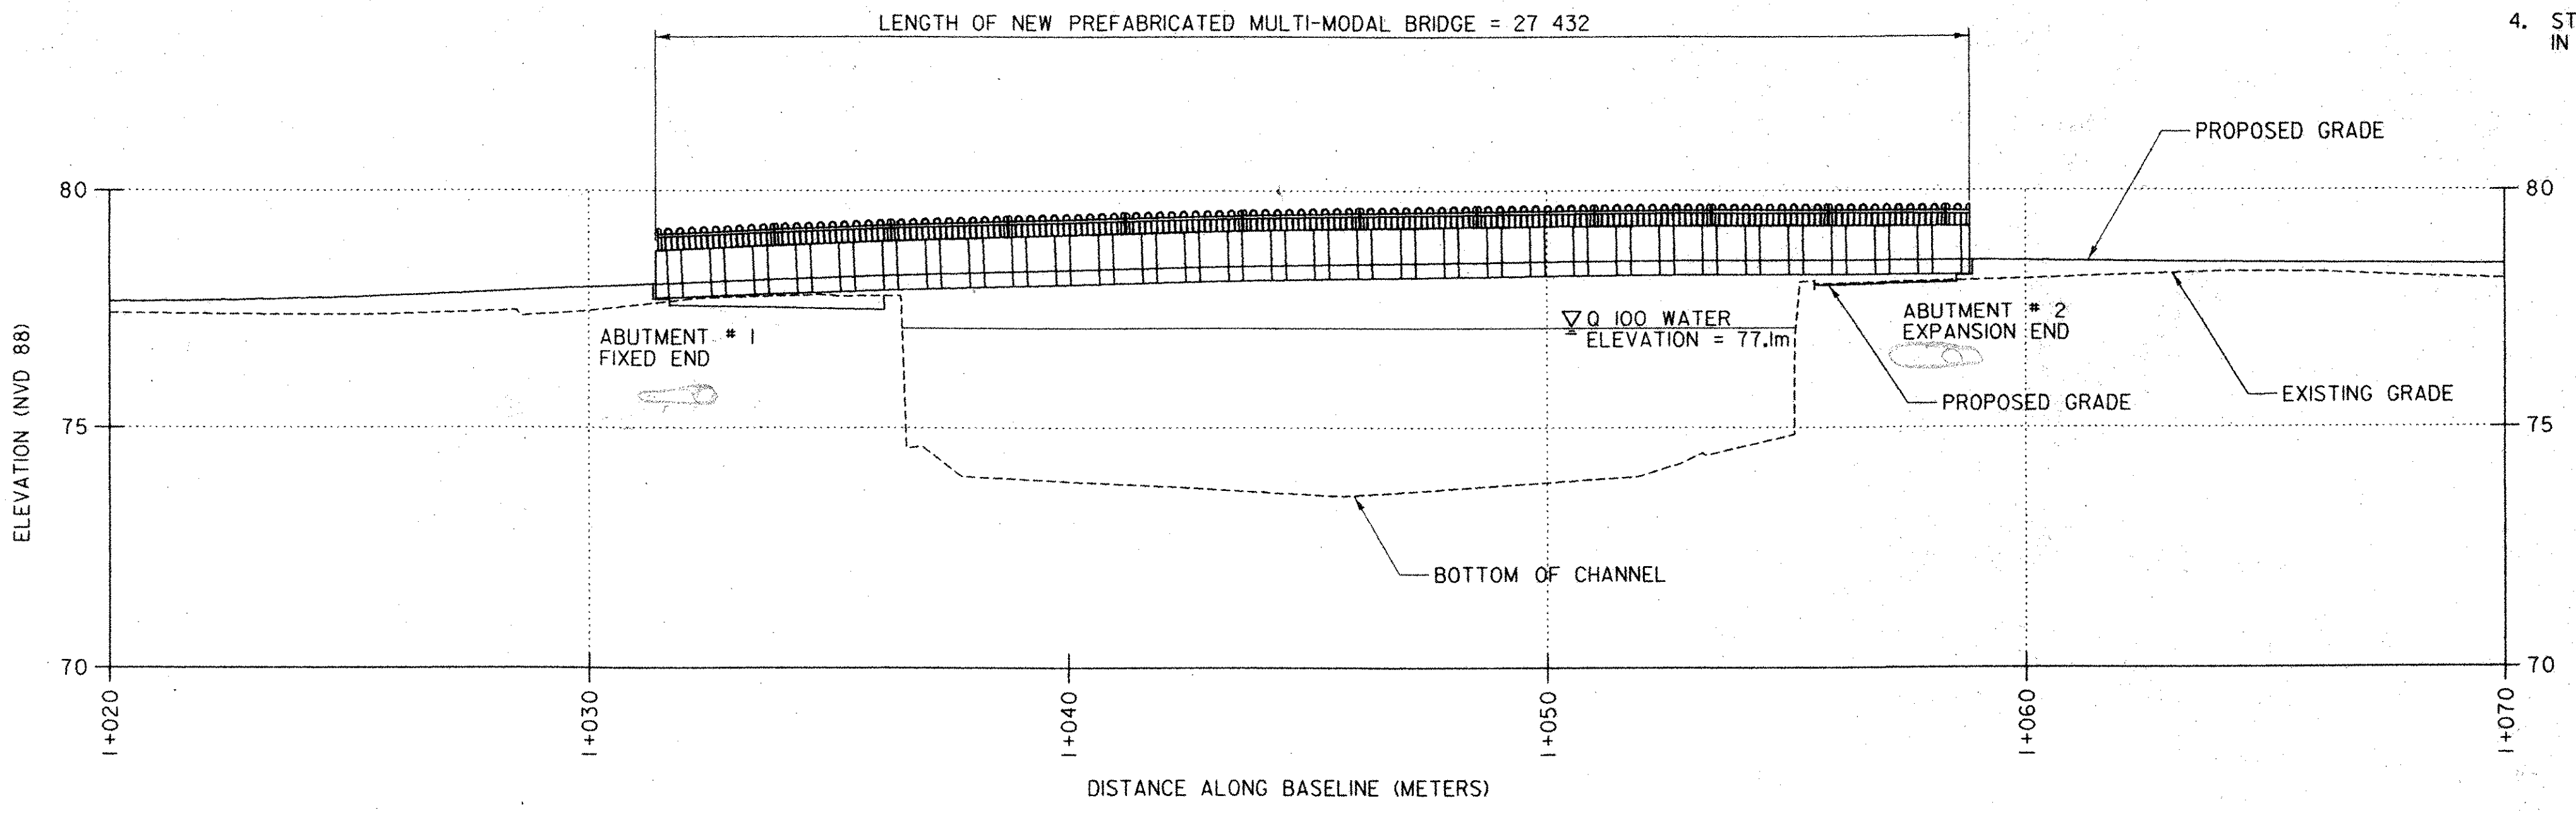

DATUM

VERTICAL	NVD 88
HORIZONTAL	NAD 83

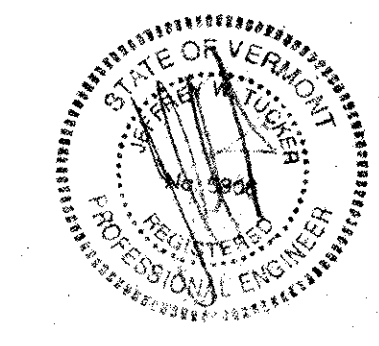

**DuBois & King**  
 engineering planning management development

TOWN OF BRATTLEBORO  
 BRATTLEBORO, VERMONT  
 WHETSTONE BROOK PATHWAY PROJECT  
 STP BIKE (27) S  
 PLAN AND ELEVATION SHEET

DRAWN BY	SJB	DATE	FEB. 2004
CHECKED BY	JDA	PROJ. NO.	114
PROJ. ENG.	JDA	DRAW. NO.	114
SHEET	11	OF	12

PLOTTED: 03/11/2004