
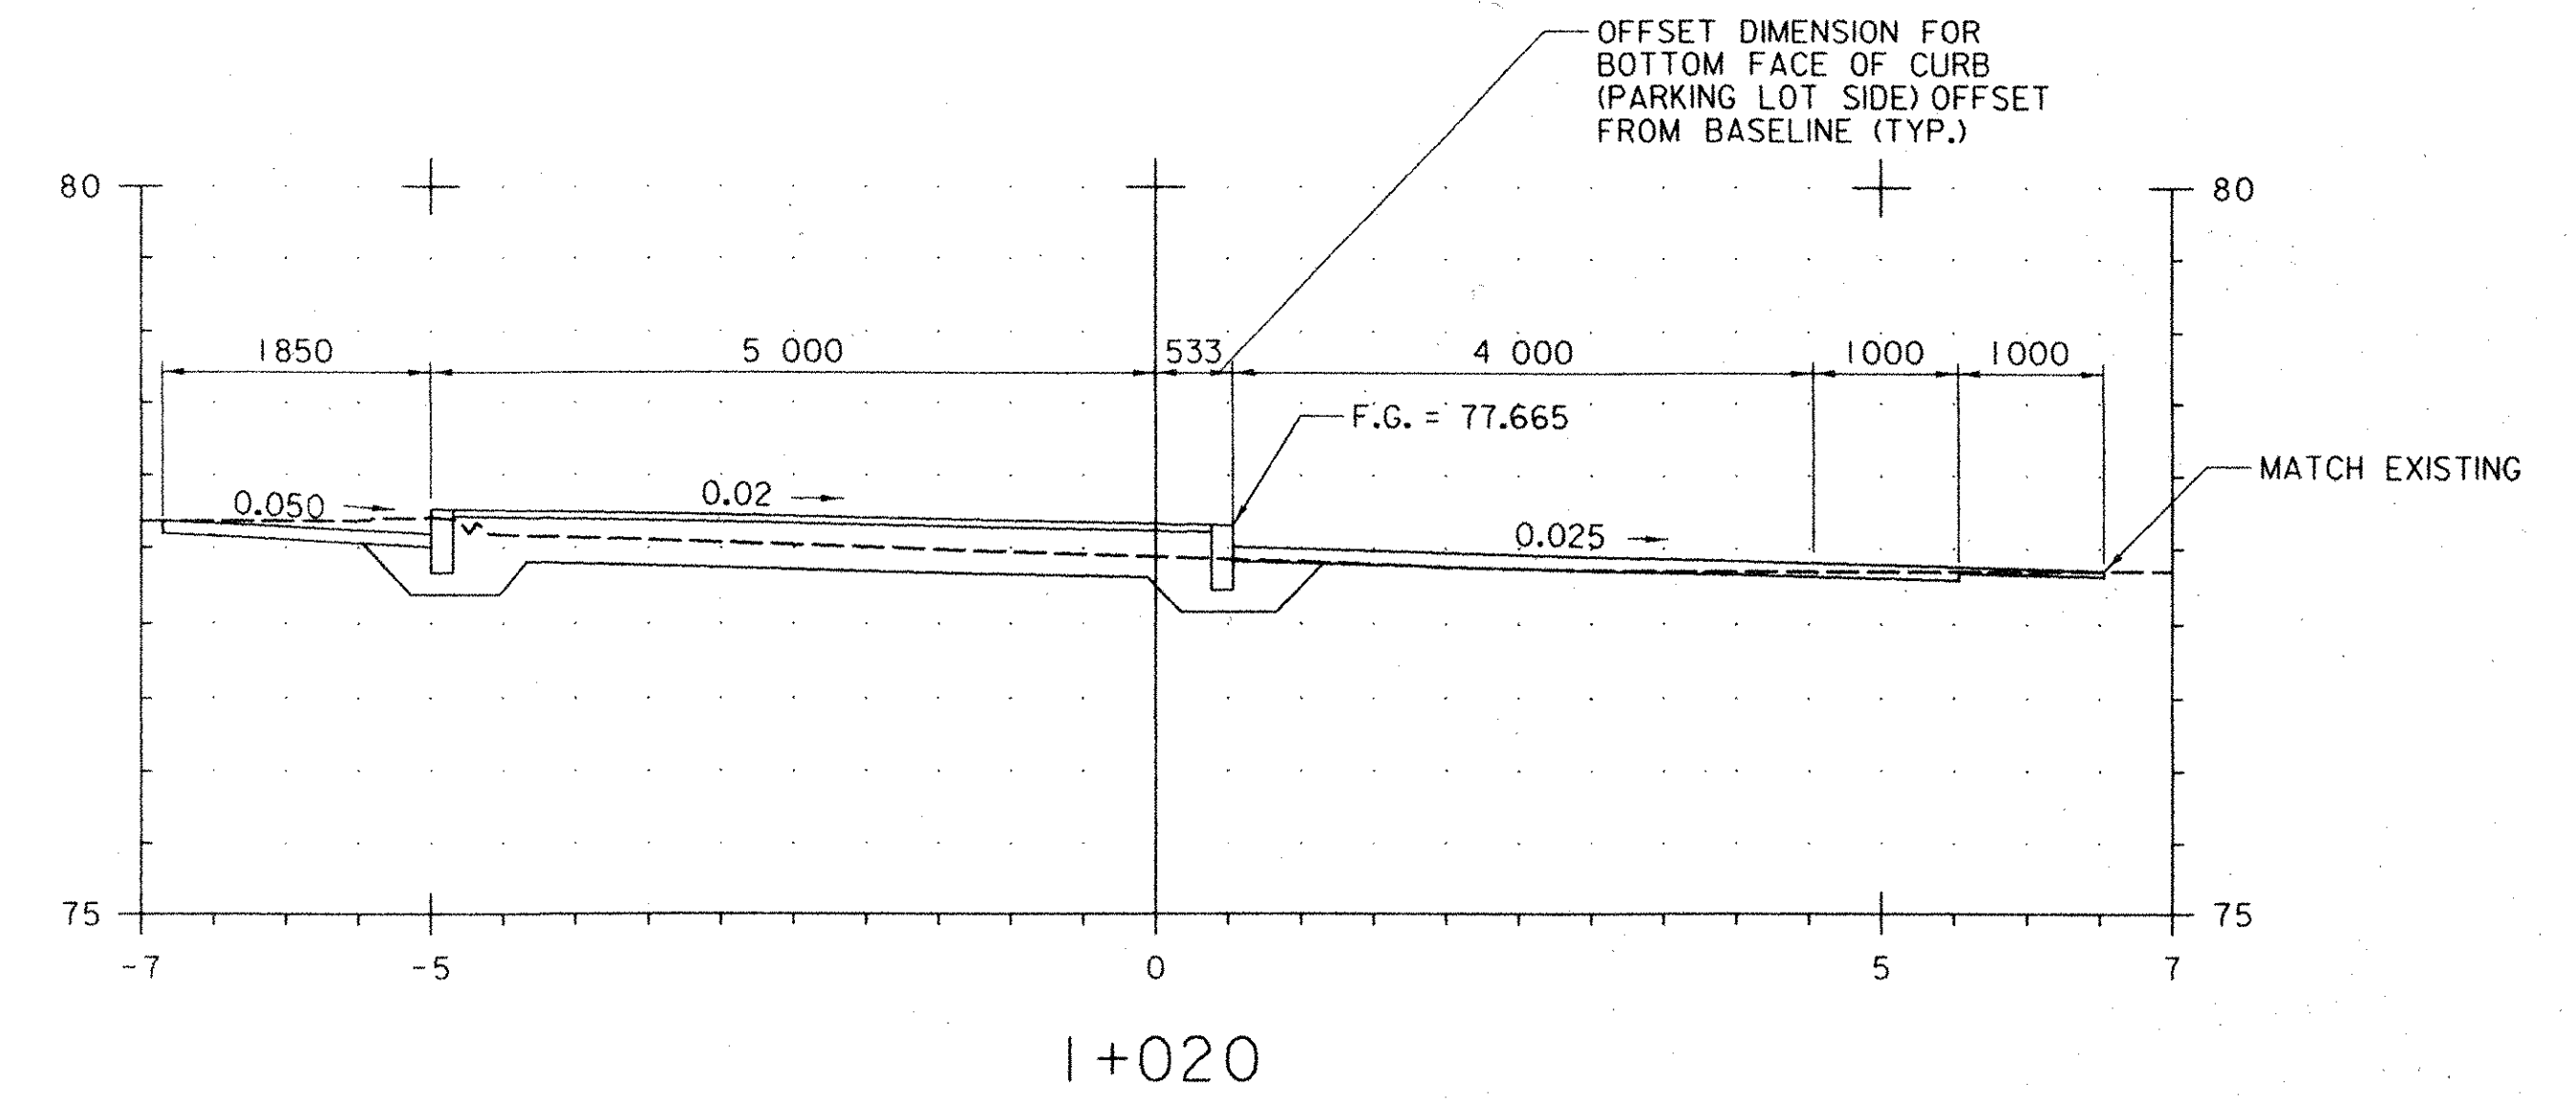
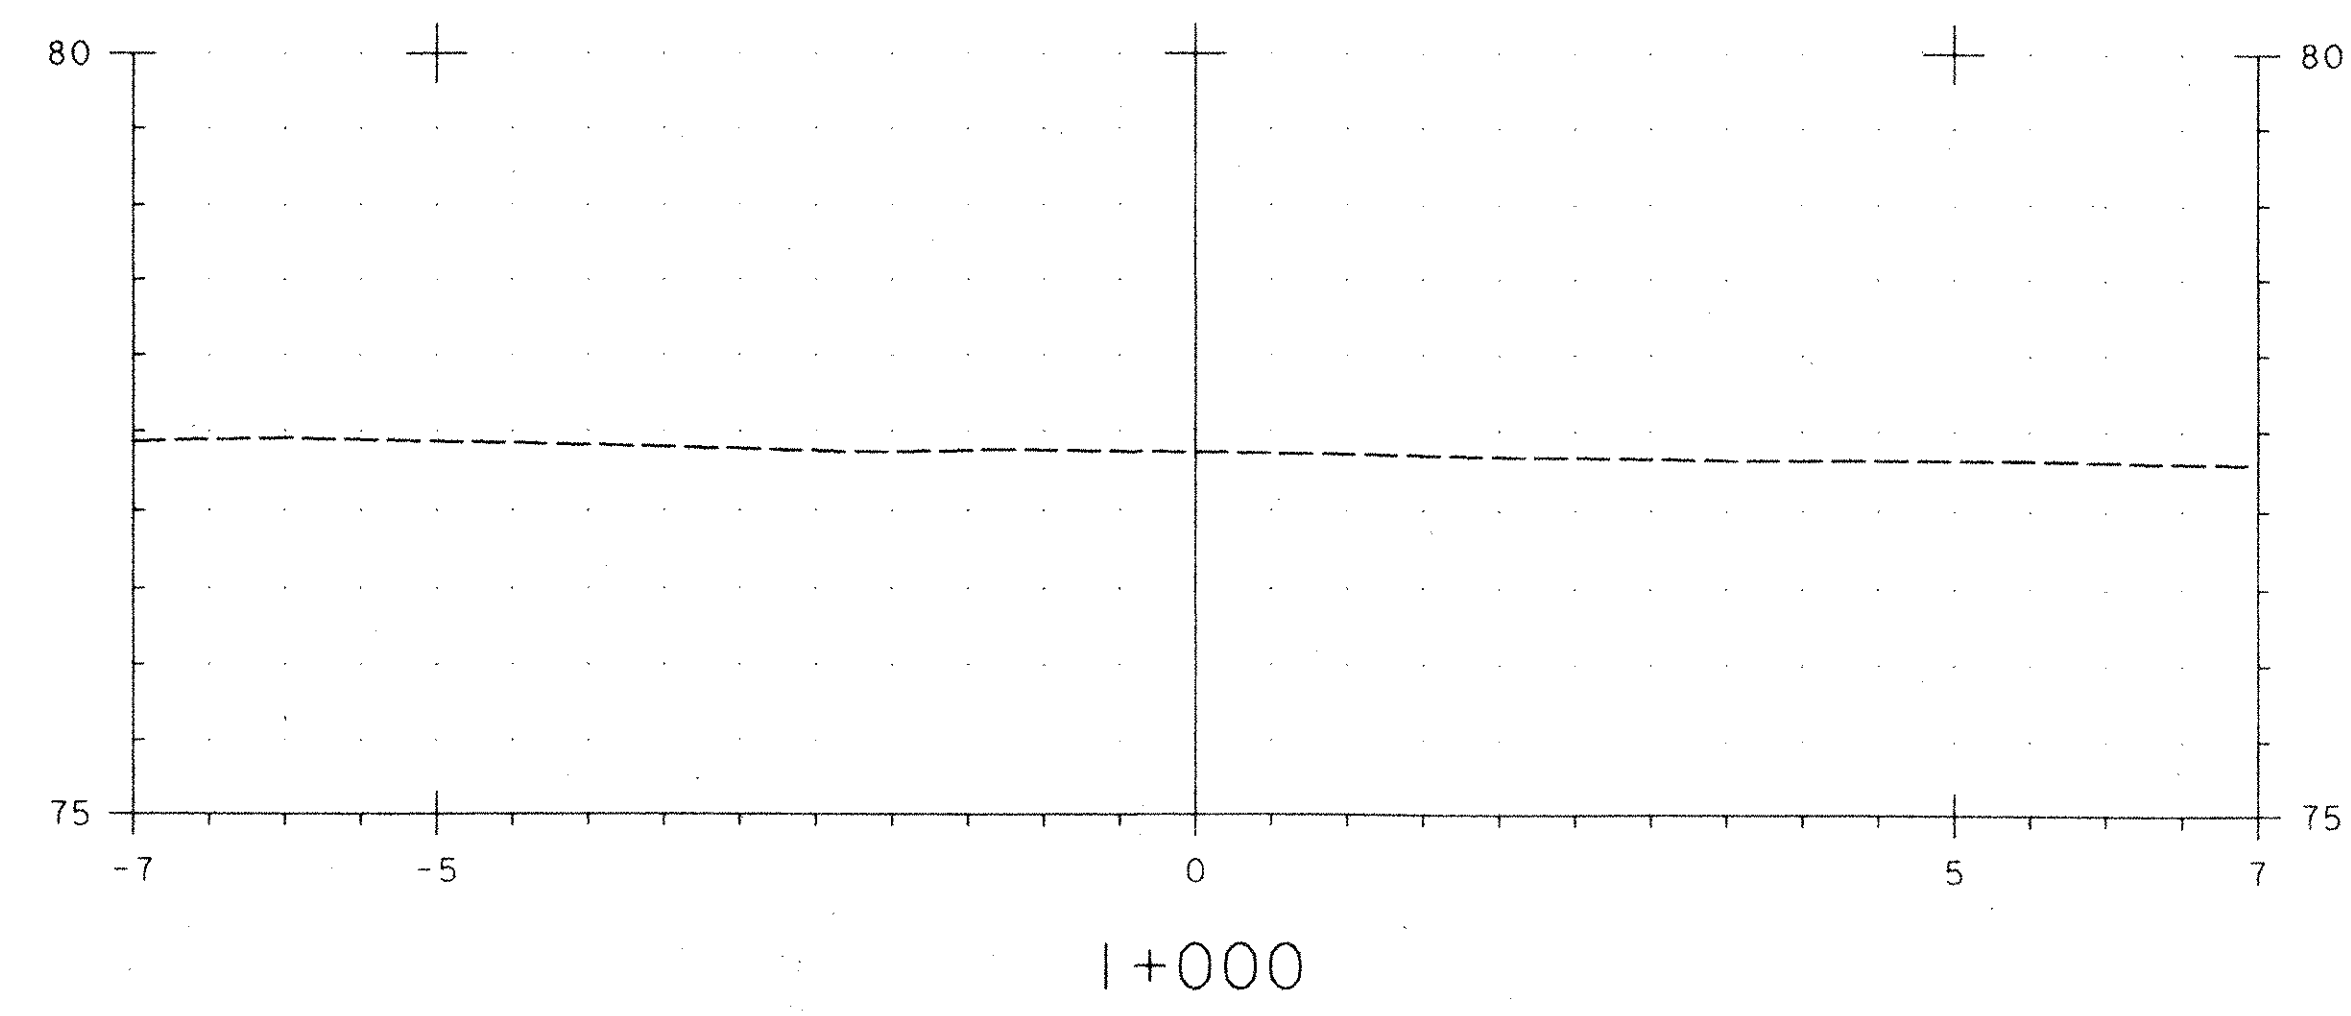
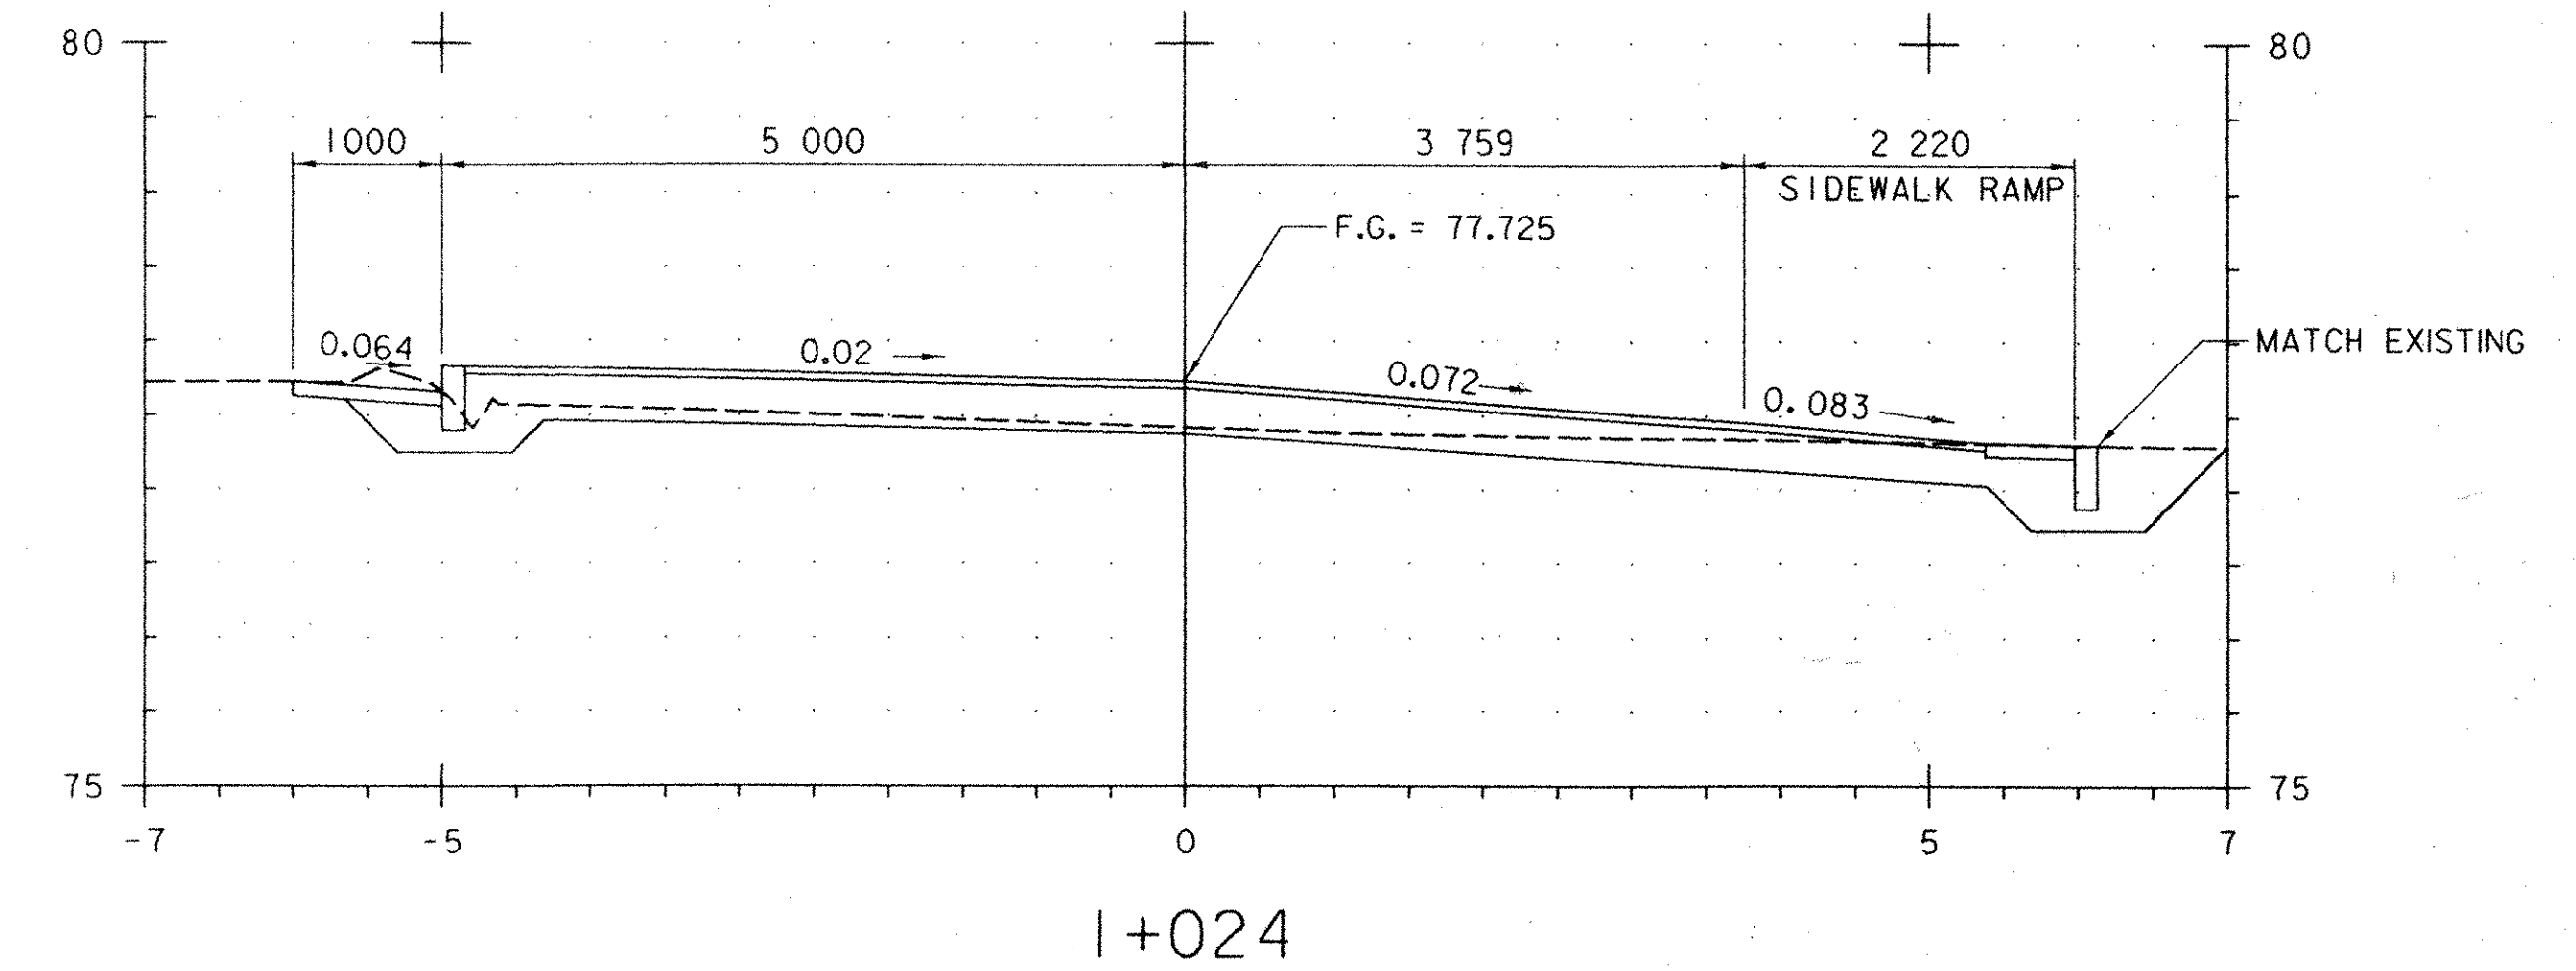
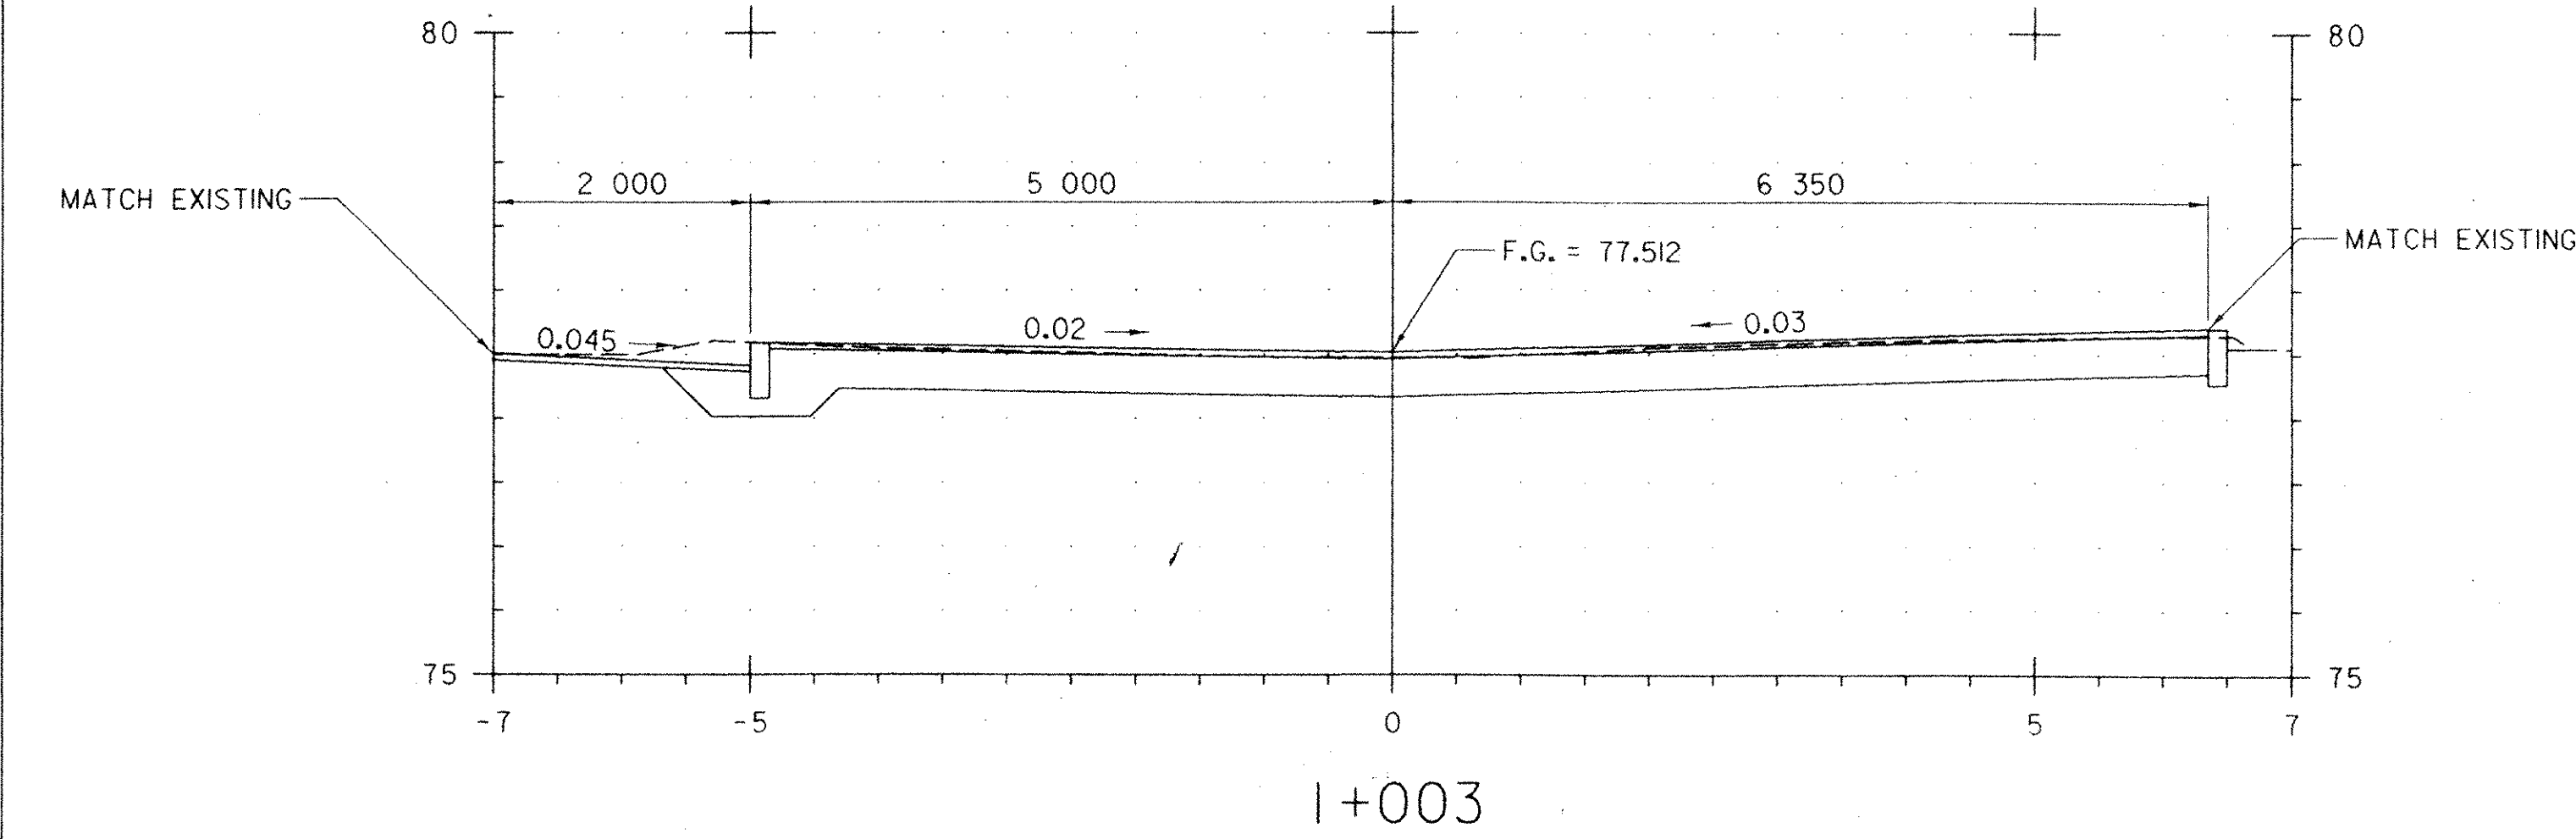




**TABLE 1:  
BOTTOM FACE OF CURB (PARKING  
LOT SIDE) OFFSET FROM BASELINE**

STATION	OFFSET	STATION	OFFSET
STA. I+005.000	0.557 RT	STA. I+090.000	0.354 RT
STA. I+010.000	0.000 RT	STA. I+095.000	0.420 RT
STA. I+015.000	0.000 RT	STA. I+100.000	0.483 RT
STA. I+020.000	0.533 RT	STA. I+102.318 (AP*)	0.514 RT
STA. I+024.547 (PC)	6.070 RT	STA. I+105.000	0.444 RT
STA. I+025.000	5.398 RT	STA. I+110.000	0.311 RT
STA. I+055.000	2.878 RT	STA. I+115.000	0.181 RT
STA. I+060.000	3.135 RT	STA. I+120.000	0.049 RT
STA. I+061.023 (PC)	3.190 RT	STA. I+121.586 (AP*)	0.008 RT
STA. I+063.946 (PT)	4.784 RT	STA. I+125.000	0.061 LT
STA. I+065.000	5.076 RT	STA. I+130.000	0.164 LT
STA. I+069.252 (AP*)	0.088 RT	STA. I+130.929 (AP*)	0.182 LT
STA. I+070.000	0.097 RT	STA. I+135.000	0.127 LT
STA. I+075.000	0.162 RT	STA. I+136.490 (AP*)	0.107 LT
STA. I+080.000	0.226 RT	STA. I+140.000	4.763 RT
STA. I+085.000	0.291 RT	STA. I+145.000	1.062 RT

(AP\*): ANGLE POINT ALONG THE CURB

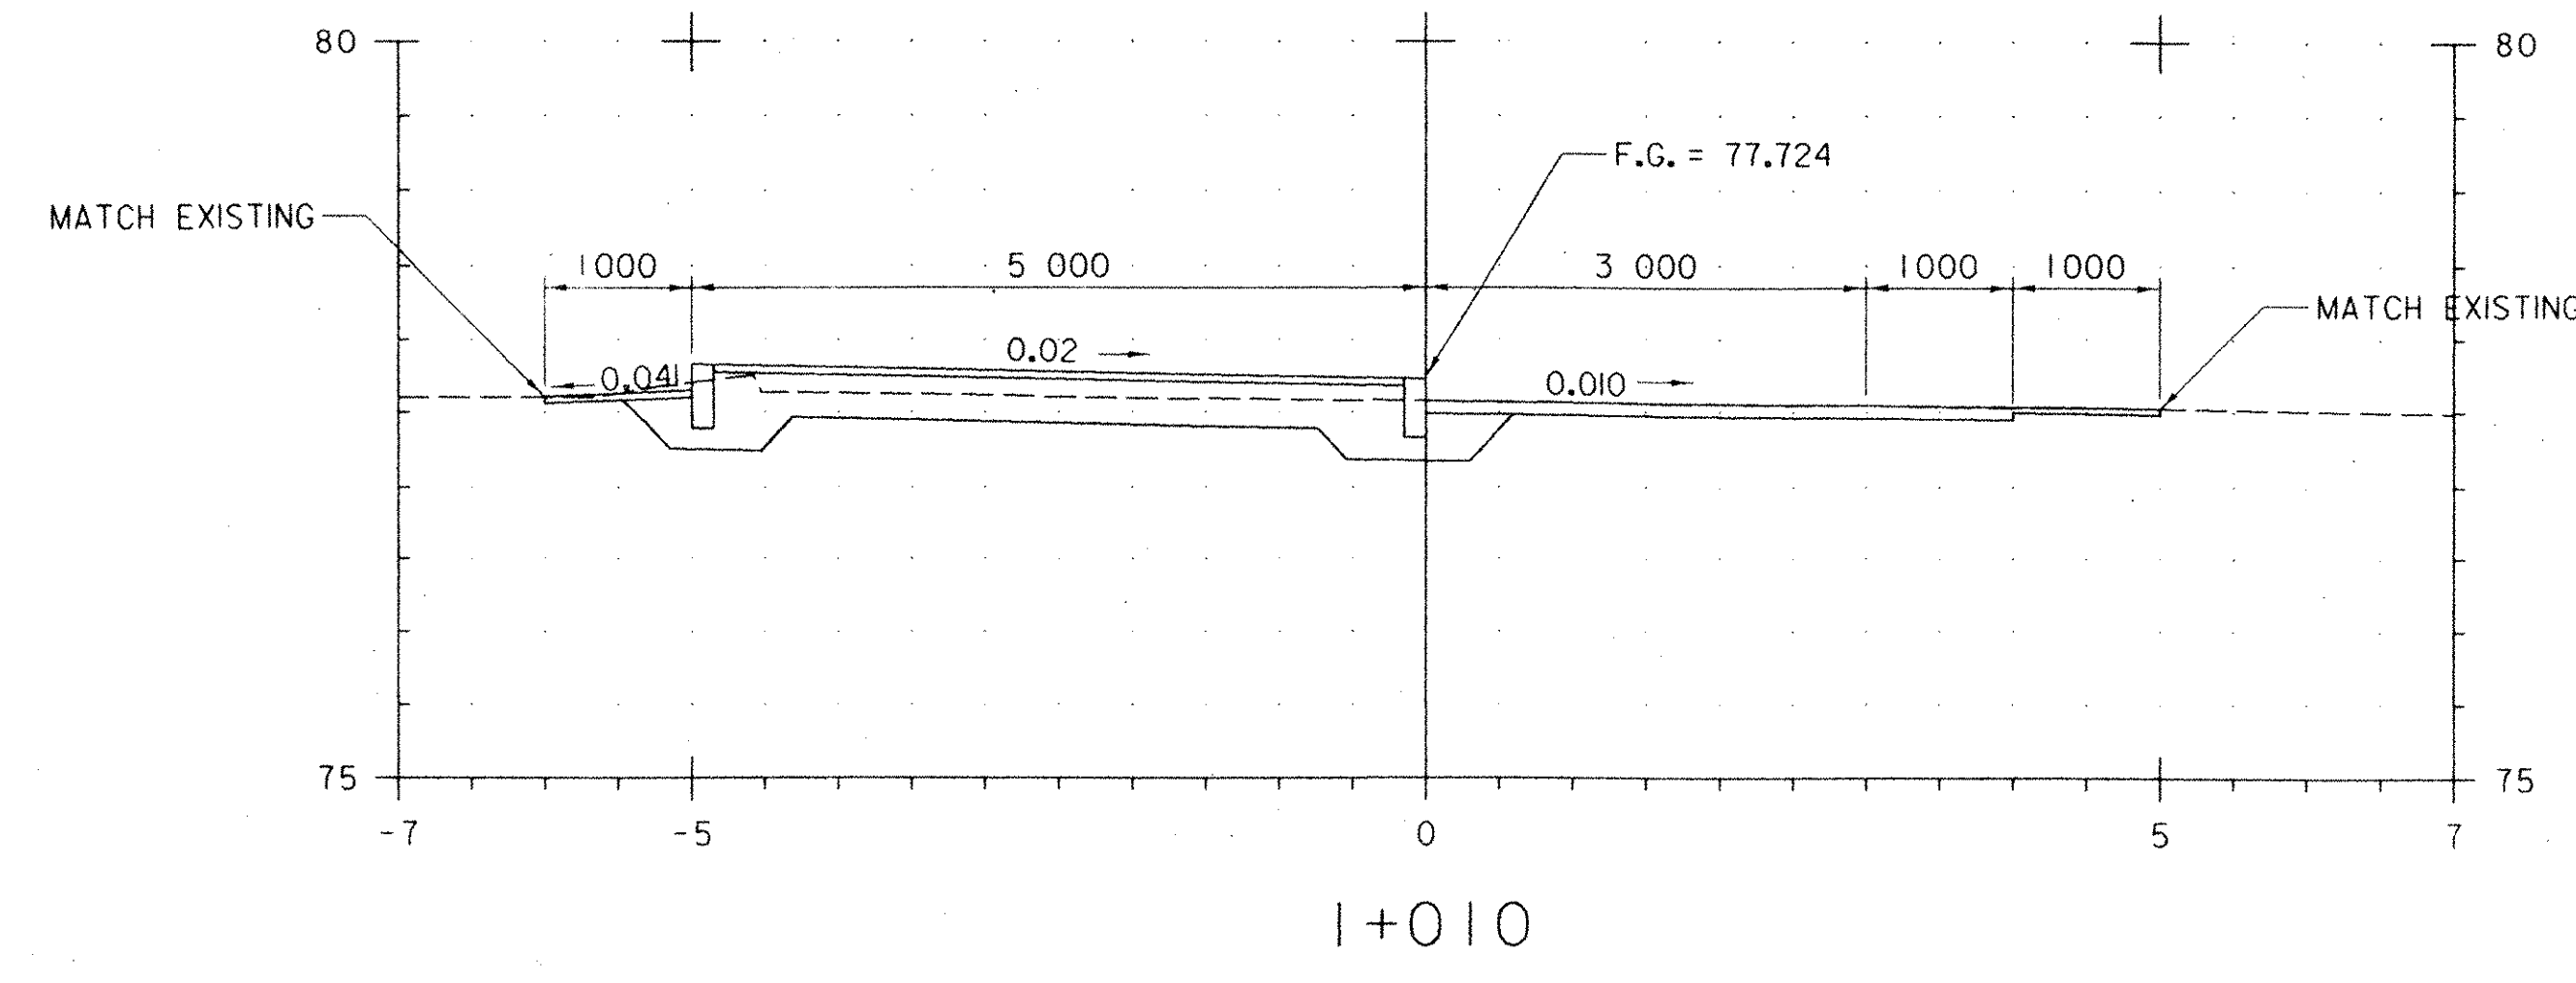

DATUM  
VERTICAL NVD 88  
HORIZONTAL NAD 83

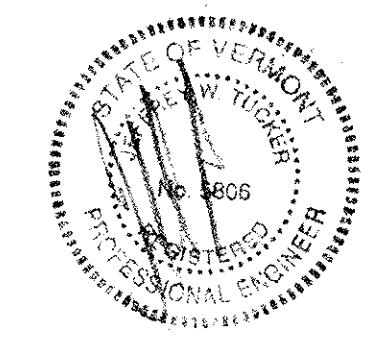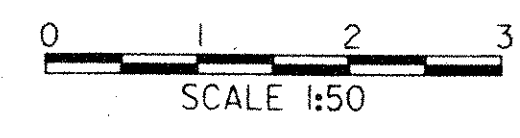

PLOTTED: 03/11/2004

**DuBois & King inc.**  
engineering planning management development

**NOTE:**

STATIONS ARE GIVEN IN KILOMETERS, OFFSETS ARE GIVEN IN METERS AND DIMENSIONS ARE GIVEN IN MILLIMETERS.

TOWN OF BRATTLEBORO  
BRATTLEBORO, VERMONT  
WHETSTONE BROOK PATHWAY PROJECT  
STP BIKE (27) S  
PATHWAY CROSS SECTIONS

DRAWN BY SJB	DATE FEB. 2004
CHECKED BY JMT	PROJ. NO. R16544
PROJ. ENG. JMT	DRAW. NO. 1145a
SHEET 24 OF 30	