
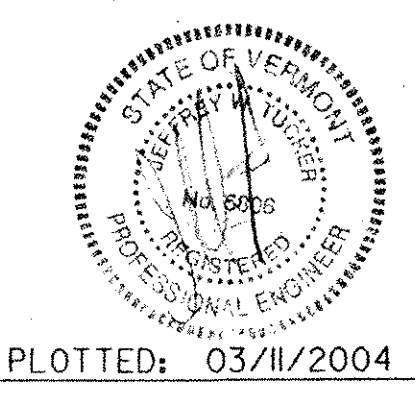


NOTE:
STATIONS ARE GIVEN IN KILOMETERS, OFFSETS ARE GIVEN IN METERS AND DIMENSIONS ARE GIVEN IN MILLIMETERS.

DATUM
VERTICAL NVD 88
HORIZONTAL NAD 83

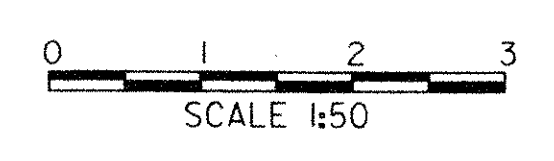

DuBois & King Inc.
engineering planning management development

TOWN OF BRATTLEBORO
BRATTLEBORO, VERMONT
WHESTONE BROOK PATHWAY PROJECT
STP BIKE (27) S
PATHWAY CROSS SECTIONS

DRAWN BY	DATE
SJB	FEB. 2004
CHECKED BY	PROJ. NO.
JTS	R16544
PROJ. ENG.	DRAW. NO.
JDA	11454
SHEET 26 OF 30	

PLOTTED: 03/11/2004