

WHITCOMB CONSTR.
 WHESTONE BROOK PATH
 PEDESTRIAN BRIDGE
 BERTHLEMMEN, VT


REVISIONS
 FOR OWNER APPROVAL
 CUSTOMER CHANGES
 RE-SUBMITTAL
 AS MANUFACTURED

BIG R
 MANUFACTURING, LLC
 PO BOX 1290
 GREELEY, COLORADO
 PH: (970) 356 9600
 FX: (970) 356 9641

DRAWN: TDS
 DATE: 1/1/04
 CHECKED: SFP
 DATE: 1/8/04
 APPROVED: SFP

REV. 5
 PROJECT NO. 24-115E
 SHEET NO. B5

SUBJECT THIS DRAWING IS THE SOLE PROPERTY OF HALLBERG STEEL STRUCTURE INC. IT IS TO BE USED FOR PURPOSES AUTHORIZED AND SHALL NOT BE PRINTED, LOANED, REPRODUCED, COPIED, OR USED WITHOUT PERMISSION AND IS SUBJECT TO IMMEDIATE RETURN ON DEMAND. COPYRIGHT 2002 ALL RIGHTS RESERVED.

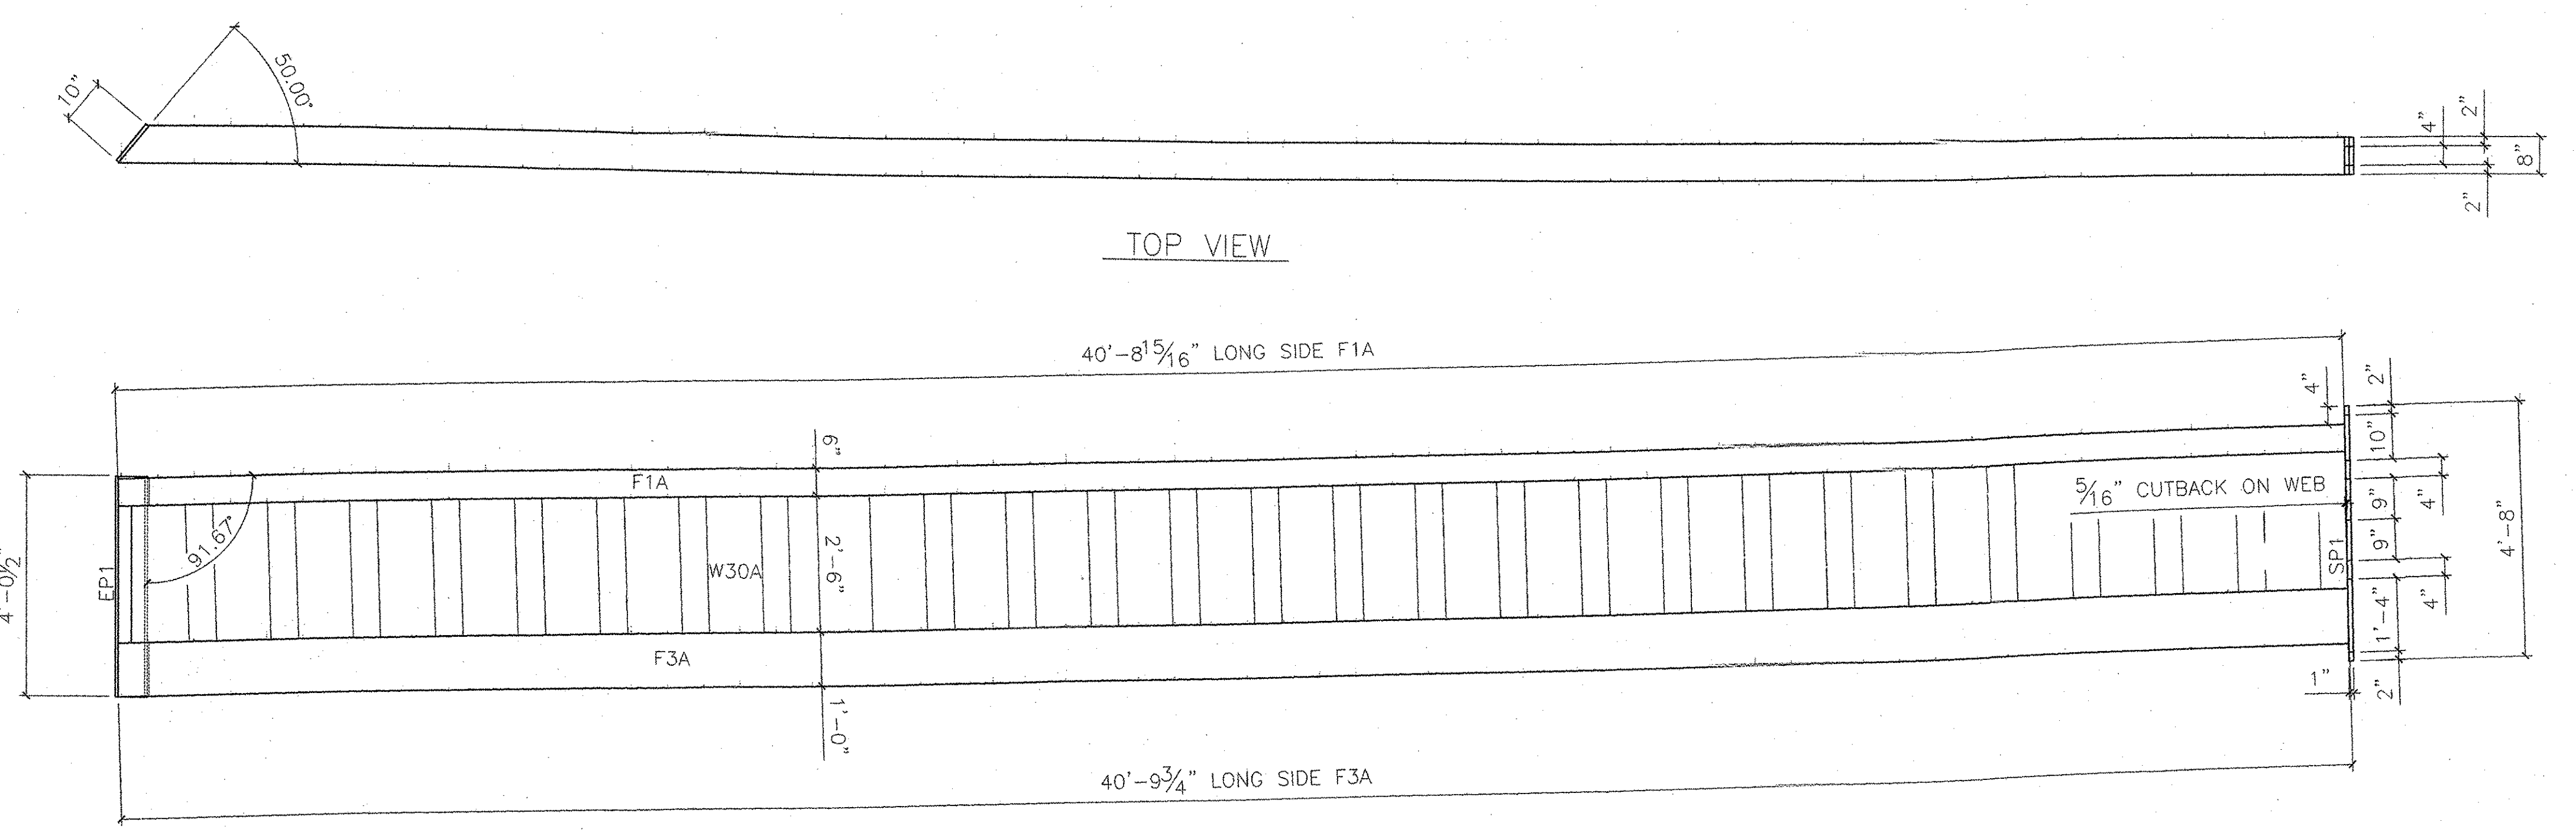


(1) BRIDGE BEAM BM1A

MK	QTY	DESCRIPTION	MK	QTY	DESCRIPTION	MK	QTY	DESCRIPTION	MK	QTY	DESCRIPTION
F1A	1	TS 8 X 6 X 3/8									
F3A	1	TS 12 X 8 X 1/4									
SP1	1	FB 1 X 8									
EP1	1	FB 3/4 X 10									
W30A	1	CORRUGATED WEB 7GA. X 30"									

D1

REV. DATE DESCRIPTION

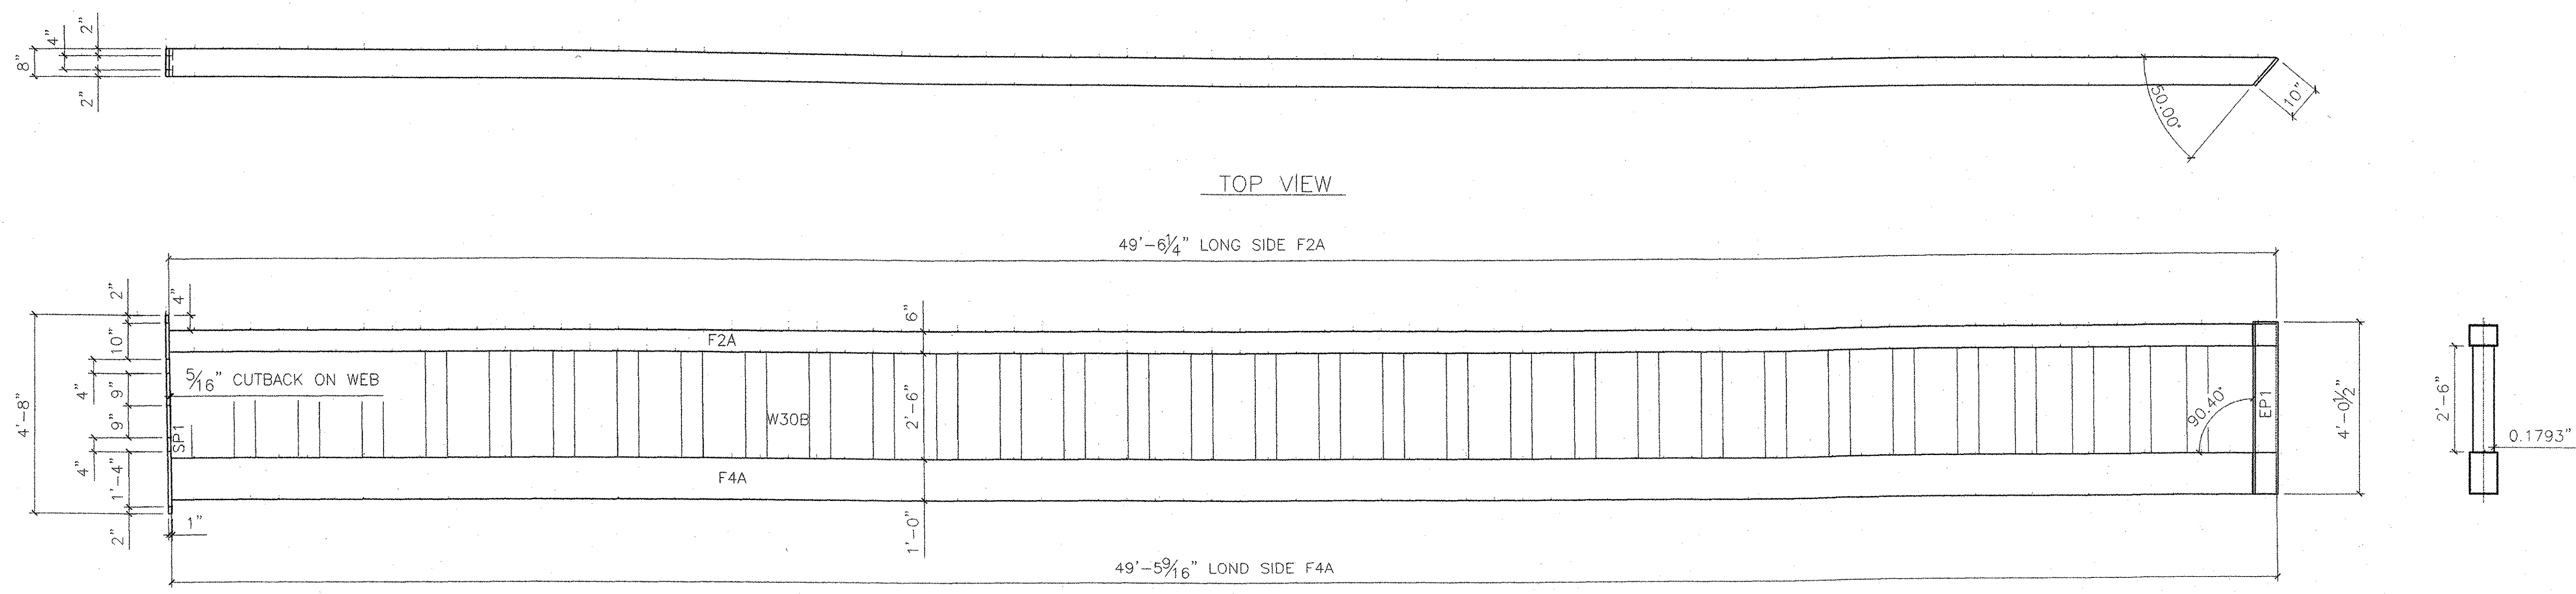

(1) BRIDGE BEAM BM2A

MK	QTY	DESCRIPTION	MK	QTY	DESCRIPTION	MK	QTY	DESCRIPTION	MK	QTY	DESCRIPTION
F2A	1	TS 8 X 6 X 3/8									
F4A	1	TS 12 X 8 X 1/4									
SP1	1	FB 1 X 8									
EP1	1	FB 3/4 X 10									
W30B	1	CORRUGATED WEB 7GA. X 30"									

D2

