
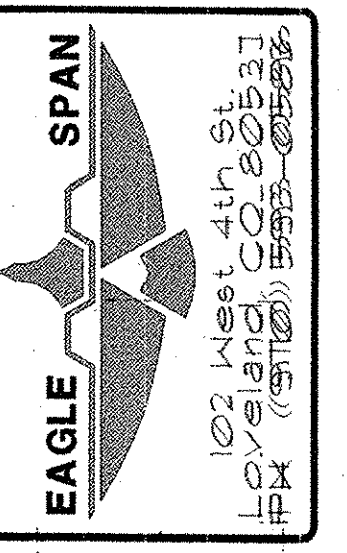


TAKE PRECAUTIONS TO AVOID DAMAGING BRIDGE FINISH WITH LIFTING APPARATUS.

HALF SECTION BRIDGE WEIGHT
18,962 LBS

TYPICAL BRIDGE INSTALLATION PROCEDURE

1. FIELD VERIFY CORRECT ANCHOR BOLT LOCATIONS.
2. ASSEMBLE BRIDGE HALVES PER SPLICE CONNECTION DETAIL AS SHOWN ON BRIDGE DRAWINGS.
3. ATTACH LIFTING STRAPS AROUND BRIDGE BOTTOM CROSS MEMBERS AT LIFT POINTS AS SHOWN IN DIAGRAM. FLOOR PLANKS AT LIFT POINTS WILL BE SHIPPED LOOSE.
4. SECURE AND CHECK THAT ALL LIFTING EQUIPMENT IS IN GOOD WORKING CONDITION AND CAN SAFELY SUPPORT THE TOTAL BRIDGE WEIGHT.
5. LIFT AND MOVE BRIDGE STRUCTURE AND SET BRIDGE BASE PLATES ONTO SLIP PADS AND ANCHOR BOLTS.
6. INSTALL ANCHOR BOLT WASHERS AND NUTS.
7. VISUALLY INSPECT THE BRIDGE FOR ANY DAMAGE TO THE FINISH AND APPLY TOUCH UP PAINT IF REQUIRED.
8. INSTALL FLOOR DECK PLANKS AT LIFT POINT AREAS.
9. SPREADER BAR AND LIFTING APPARATUS IS SHOWN CONCEPTUALLY. CONTRACTOR IS RESPONSIBLE FOR ALL HOISTING REQUIREMENTS.

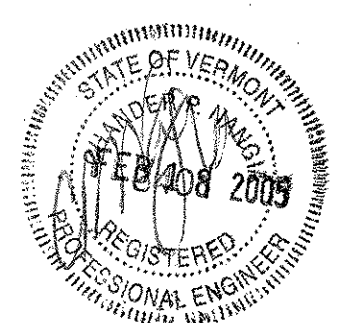

WHITCOMB CONSTR.
WHEATSTONE BROOK PATH
PEDESTRIAN BRIDGE
HEATHEN BOX, VT

DATE	REV.	REVISIONS
2/10/05	0	INSTALLATION INSTRUCTIONS

BIG R
MANUFACTURING, LLC
PO BOX 1290
GREELEY, COLORADO
PH: (970) 356 9600
FAX: (970) 356 9601

DRAWN:	MDS
DATE:	1/14/05
CHECKED:	SFF
DATE:	1/14/05
APPROVED:	SFF

REV.	0
PROJECT NO.	24-775E
SHEET NO.	INST 2