

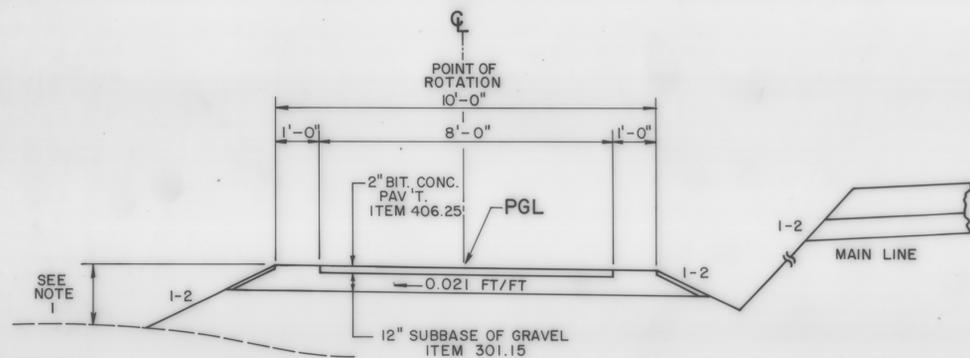
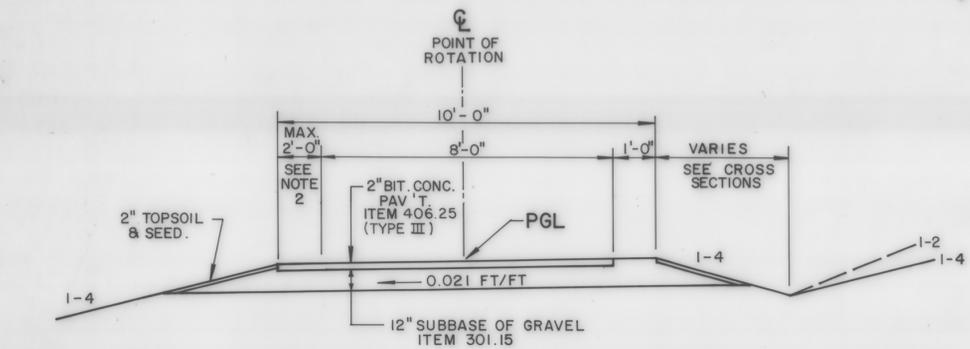



TYPICAL SECTIONS - BIKEWAY

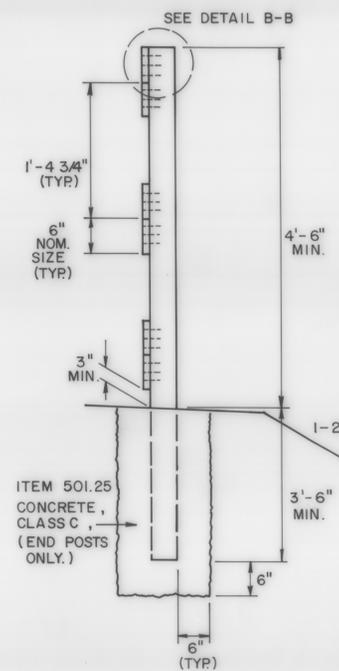


BIKEWAY
N.T.S.

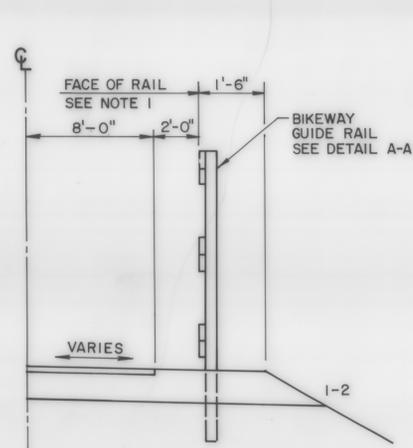


SECTION A-A
N.T.S.

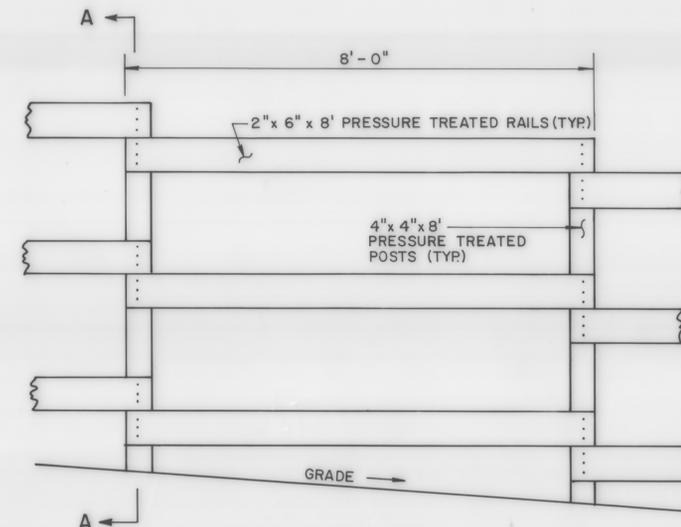


BIKEWAY GUIDE RAIL
N.T.S.

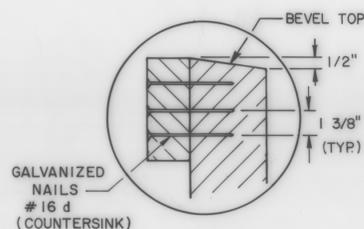


DETAIL B-B
N.T.S.

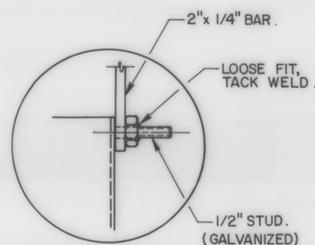


DETAIL D-D
N.T.S.

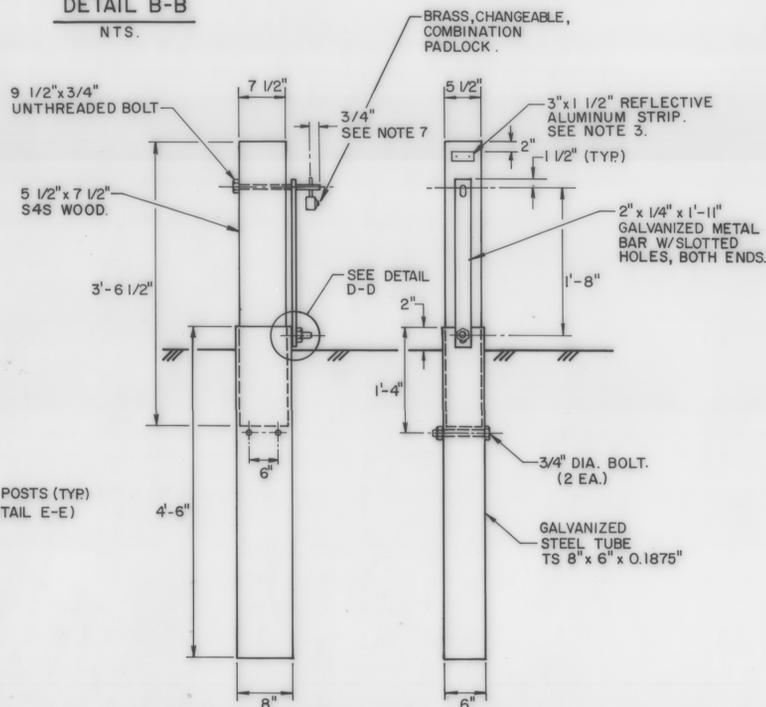


REMOVABLE WOOD POST
DETAIL C-C
N.T.S.

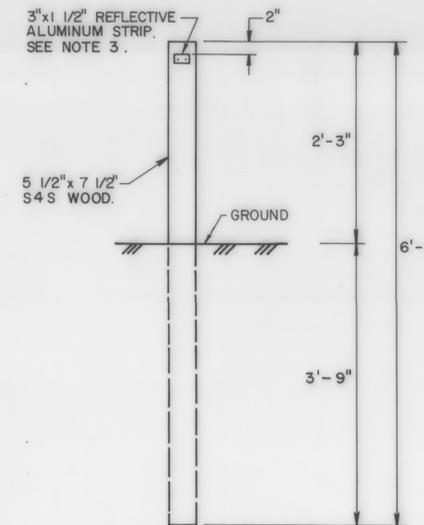

FIXED POST
DETAIL E-E
N.T.S.

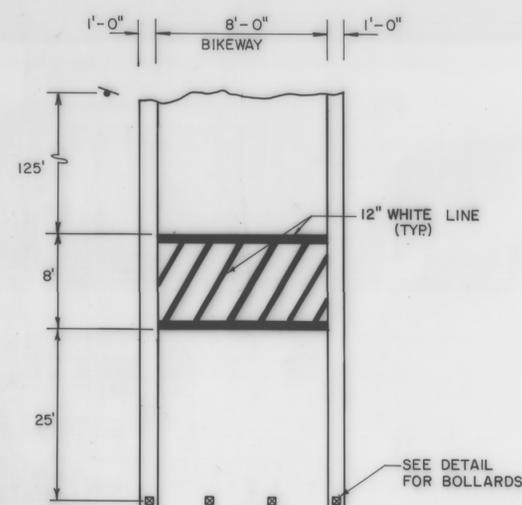

PAVEMENT MARKING
DETAIL FOR BOLLARDS
N.T.S.

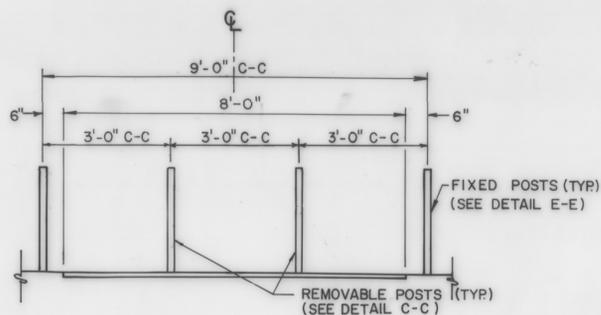

BOLLARD DETAIL
N.T.S.

NOTES:

1. GUIDE RAIL WILL BE REQUIRED IN AREAS WHERE THE TOP OF BIKEWAY IS GREATER THAN 5' FROM EXISTING GROUND AND SLOPES ARE STEEPER THAN 1-4.
2. SHOULDERS ON INSIDE EDGE OF DESIGNATED CURVES WILL BE WIDENED AN ADDITIONAL 2' MAX AND PAVED WITH 2" BIT. CONC. PAV'T.
3. REFLECTIVE STRIP TO BE PLACED BOTH SIDES OF ALL POSTS, CLEARLY VISIBLE TO APPROACHING TRAFFIC. REFLECTIVE MATERIAL SHALL MEET THE REQUIREMENTS OF SUB-SECTION 750.09 AND SHALL BE OF ENCAPSULATED LENS, SILVER OR AMBER.
4. PRESSURE TREATED RAIL SHALL CONFORM TO STANDARD SPECIFICATION 726.01.
5. ALL CONCRETE HARDWARE AND OTHER MATERIALS OR EQUIPMENT NECESSARY FOR CONSTRUCTION OF THE GUIDE RAIL SHALL BE INCLUDED IN THE LUMP SUM COST OF THE GUIDE RAIL.
6. ALL STEEL, HARDWARE AND OTHER MATERIAL OR EQUIPMENT NECESSARY FOR INSTALLATION OF BIKEWAY BOLLARDS SHALL BE INCLUDED IN THE COST OF THE BOLLARDS.
7. DRILL HOLE 3/8" OR TO FIT PADLOCK. GALVANIZE AFTER DRILLING.

R.O.W. PLAN

THIS SHEET TO BE USED FOR R.O.W. INFORMATION ONLY.

SURVEYED BY _____ DATE _____
DRAWN BY BRYANT ASSOC. DATE FEB. 1989
TRACED BY _____ DATE _____
WILLISTON - ESSEX - COLCHESTER
SECTION 4
PROJ. PB NO. 033-1 (1)
SHEET 6 OF 77