

STEEL BEAM GUARD RAIL  
ML STA. 36+00 ~ 39+50 RT.  
BREAKAWAY CABLE TERMINAL  
ML STA. 35+75 ~ 36+00 RT.

SPECIAL R.O.W. FENCE  
STA. 35+75, 77' LT. - STA. 37+32, 71' LT.  
STA. 37+32, 71' LT. - STA. 39+30, 70' LT.

**BEGIN R.O.W. PROJECT NO.  
PB 033-1(I)  
STA. 27+00, C**  
BEGIN PROJECT NO. PB 033-1(I)  
CONTRACT 4  
SURVEY # STA. 27+00.00  
MATCH EXISTING

BEGIN RIGHT TO CONSTRUCT  
HEINEBERG DRIVE  
STA. 10+00 C

CONSTRUCT DRIVES

LT	RT
ML STA. 29+14, 14' W. BIT.	ML STA. 28+96, 14' W. BIT.
HD STA. 13+21, 20' W. BIT.	HD STA. 18+73, APRON, BIT.
HD STA. 14+85, 20' W. BIT.	HD STA. 19+69, APRON, GRAV.
HD STA. 15+50, APRON, BIT.	
HD STA. 17+33, APRON, BIT.	
HD STA. 18+10, 14' W. GRAV.	
HD STA. 19+00, APRON, BIT.	
HD STA. 19+35, APRON (LEORAY DR), BIT.	

WOVEN WIRE FENCE WITH STEEL POSTS

STA. 35+75, 52' LT.	STA. 35+93, 50' LT.
STA. 35+93, 50' LT.	STA. 37+48, 50' LT.
STA. 37+48, 50' LT.	STA. 39+49, 45' LT.
STA. 29+70, 63' RT.	STA. 32+00, 310' RT.
STA. 32+00, 310' RT.	STA. 37+10, 110' RT.
STA. 37+10, 110' RT.	STA. 38+62, 106' RT.

HD CURVE DATA #1  
D = 2° 20' 00"  
Δ = 13° 46' 43" LT.  
R = 2455.53'  
T = 296.69'  
L = 590.51'  
E = 17.86'  
BANK = N/A  
PC STA. 15+93.31  
PT STA. 21+83.82

COREY,  
JOSEPHINE A.

PLUNKETT,  
JOHN &  
KERRY

COATES,  
MINNA A. &  
WILLIAM III

LIEBMAN,  
KENNETH &  
IVY

DRISCOLL,  
ANNE S.


HANDY,  
PAUL L. &  
CATHERINE  
M.

COUTURE,  
PAUL &  
DEANNE

LISCIO,  
JOHN

SCHIRING,  
BERNICE C.

STATE OF VERMONT

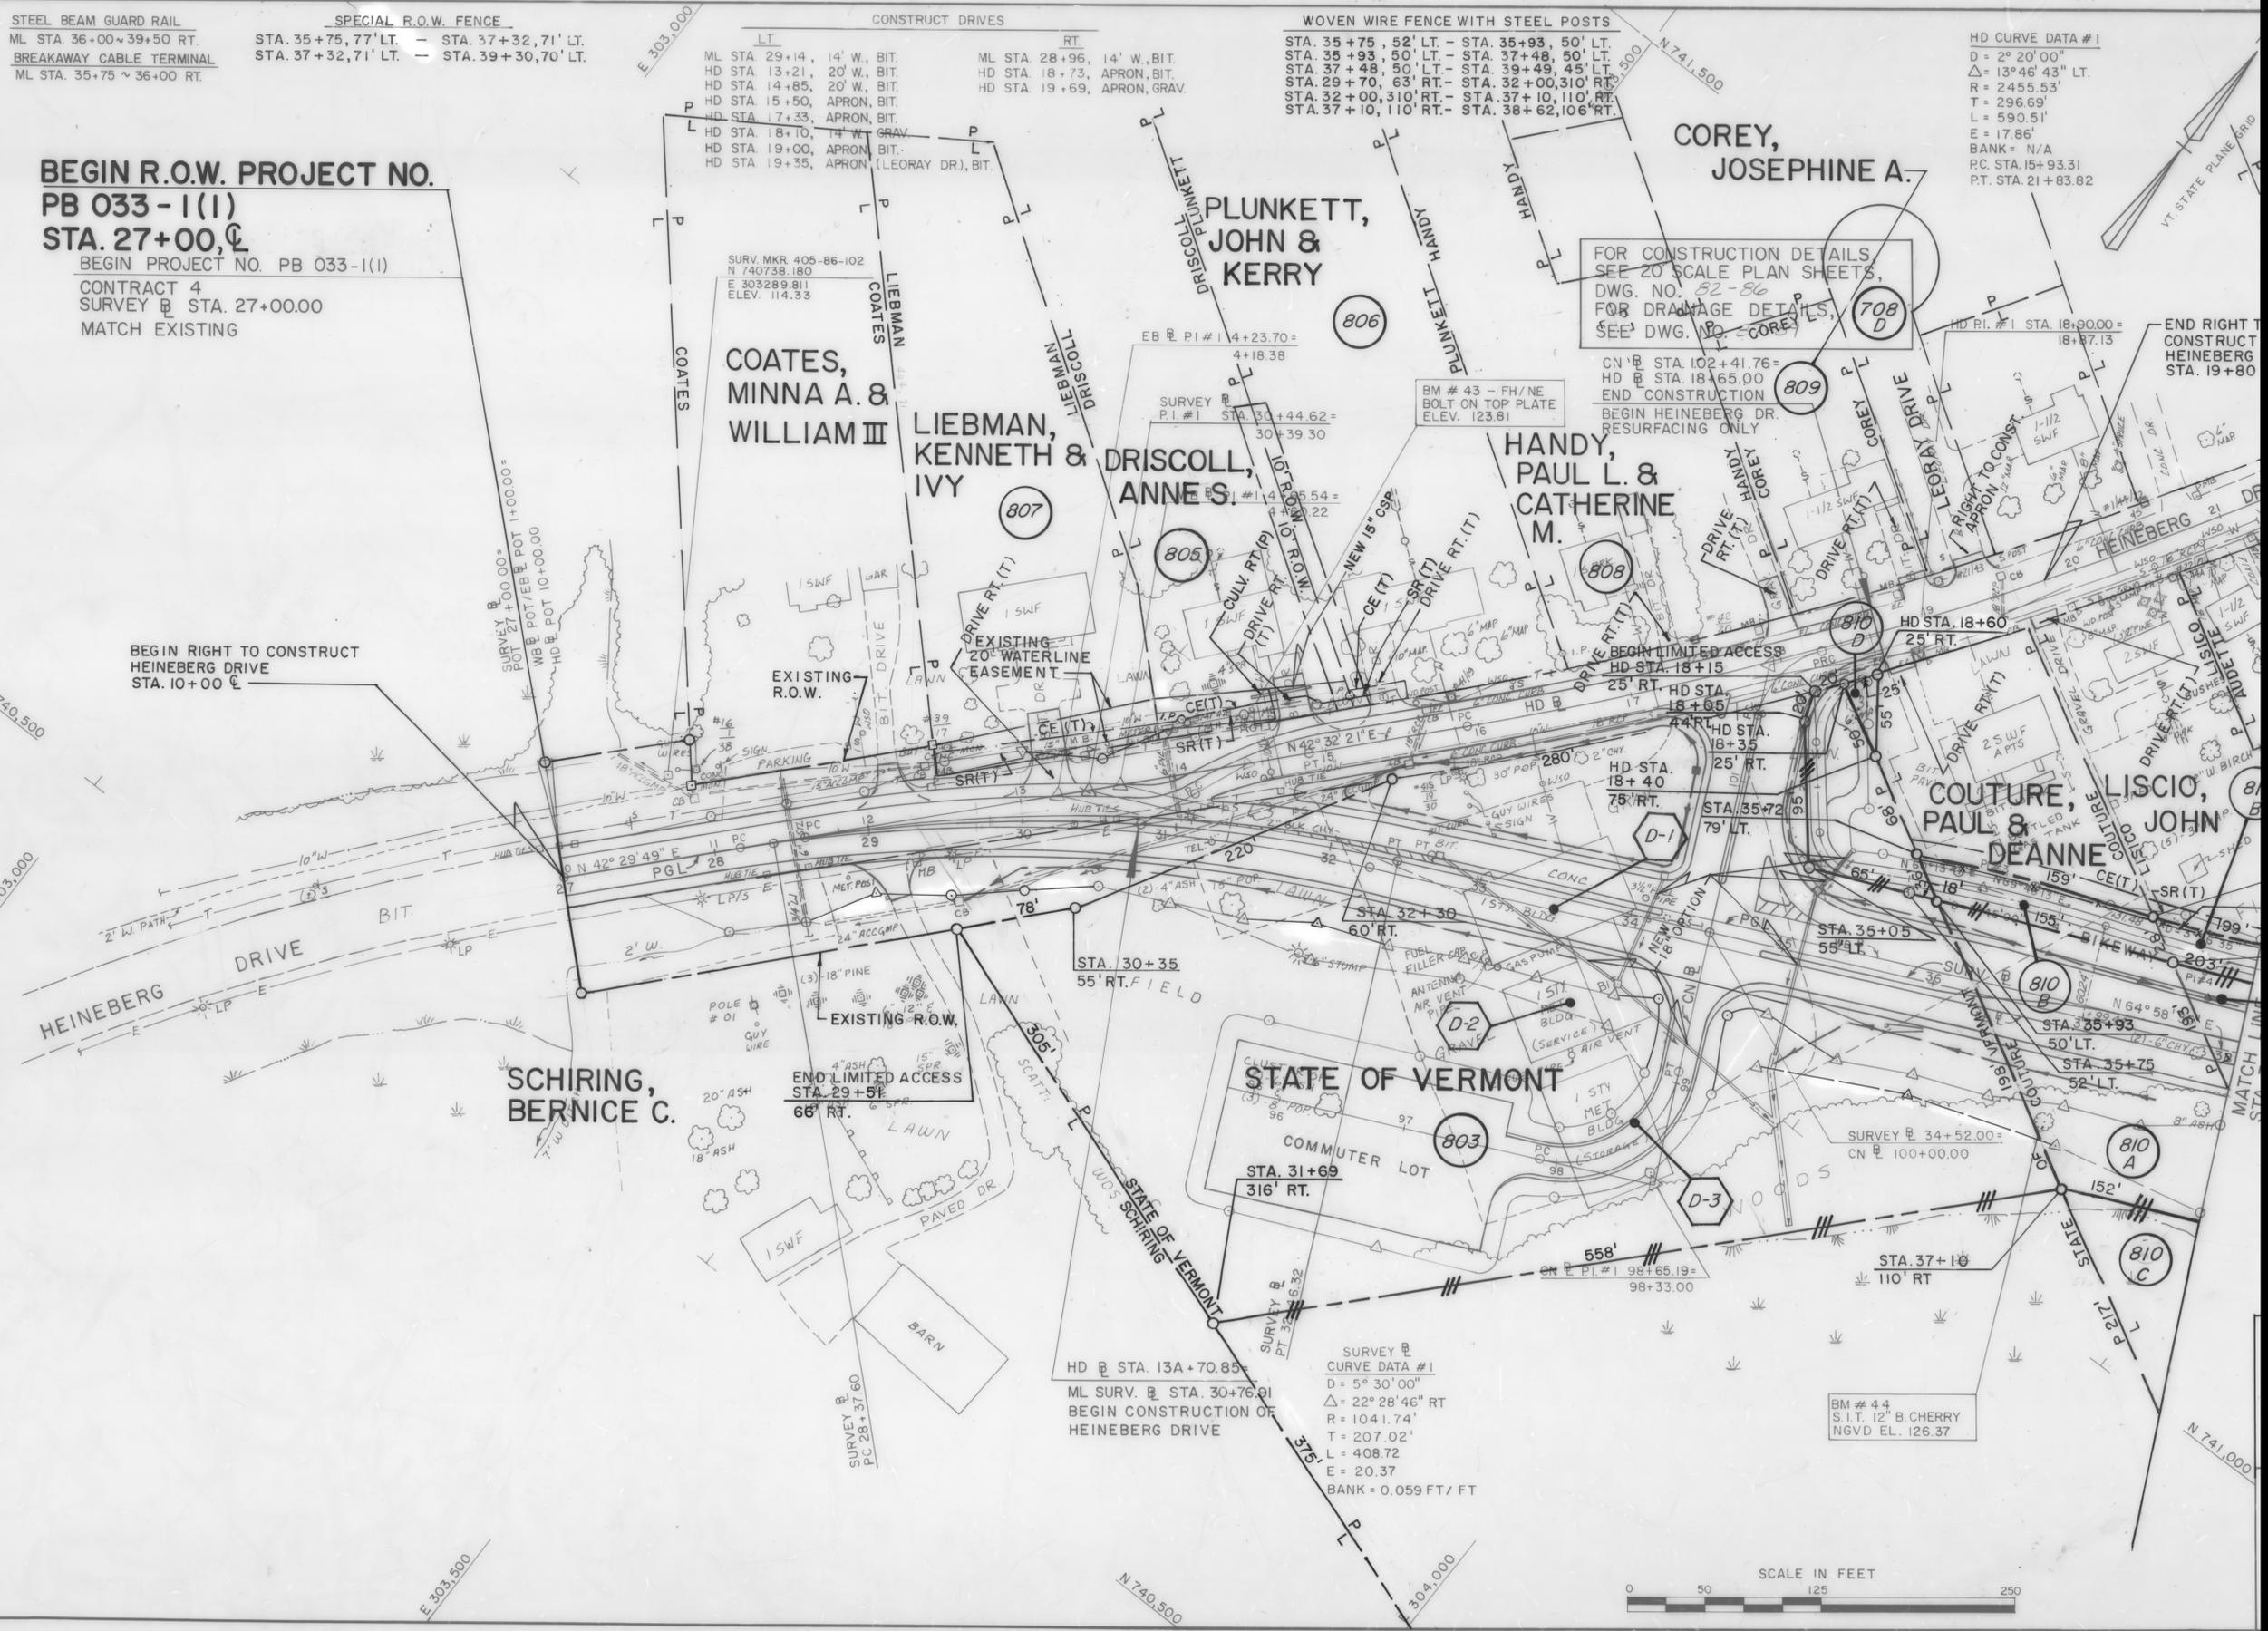

FOR CONSTRUCTION DETAILS,  
SEE 20' SCALE PLAN SHEETS,  
DWG. NO. 82-86  
FOR DRAINAGE DETAILS,  
SEE DWG. NO. 87-89

END CONSTRUCTION  
BEGIN HEINEBERG DR.  
RESURFACING ONLY

BEGIN LIMITED ACCESS  
HD STA. 18+15

END LIMITED ACCESS  
STA. 29+50  
66' RT.

HD STA. 13A+70.85  
ML SURV. # STA. 30+76.91  
BEGIN CONSTRUCTION OF  
HEINEBERG DRIVE

SURVEY #  
CURVE DATA #1  
D = 5° 30' 00"  
Δ = 22° 28' 46" RT  
R = 1041.74'  
T = 207.02'  
L = 408.72'  
E = 20.37'  
BANK = 0.059 FT / FT

BM # 44  
S.I.T. 12" B CHERRY  
NGVD EL. 126.37

