

# HAZELETT STRIP CASTING CORPORATION

CONSTRUCT SCENIC TURNOUT  
AND ACCEL LANE  
STA. 106+00 ~ 118+39 RT.  
SEE DETAILS, SHT. NO.


WOVEN WIRE FENCE WITH STEEL POSTS  
STA. 103+48, 90' LT. - STA. 108+04, 90' LT.  
STA. 108+04, 90' LT. - STA. 122+40, 90' LT.  
STA. 105+67, 570' RT. - STA. 110+00, 120' RT.  
STA. 110+00, 120' RT. - STA. 122+36, 120' RT.

EROSION MATTING

LT.	RT.
STA. 109+50 ~ 118+50	STA. 108+50 ~ 109+00
STA. 110+00 ~ 119+00	STA. 106+00 ~ 106+50
BKWY STA. 82+70 ~ 83+20	
BKWY STA. 84+20 ~ 84+70	



SURVEY  $\square$   
CURVE DATA #5  
D = 3° 30' 00"  
 $\Delta$  = 23° 01' 42" LT.  
R = 1637.02'  
T = 333.48'  
L = 657.95'  
E = 33.62'  
BANK = 0.058 FT/FT

BARTLETT  
HAZELETT STRIP CASTING CORPORATION

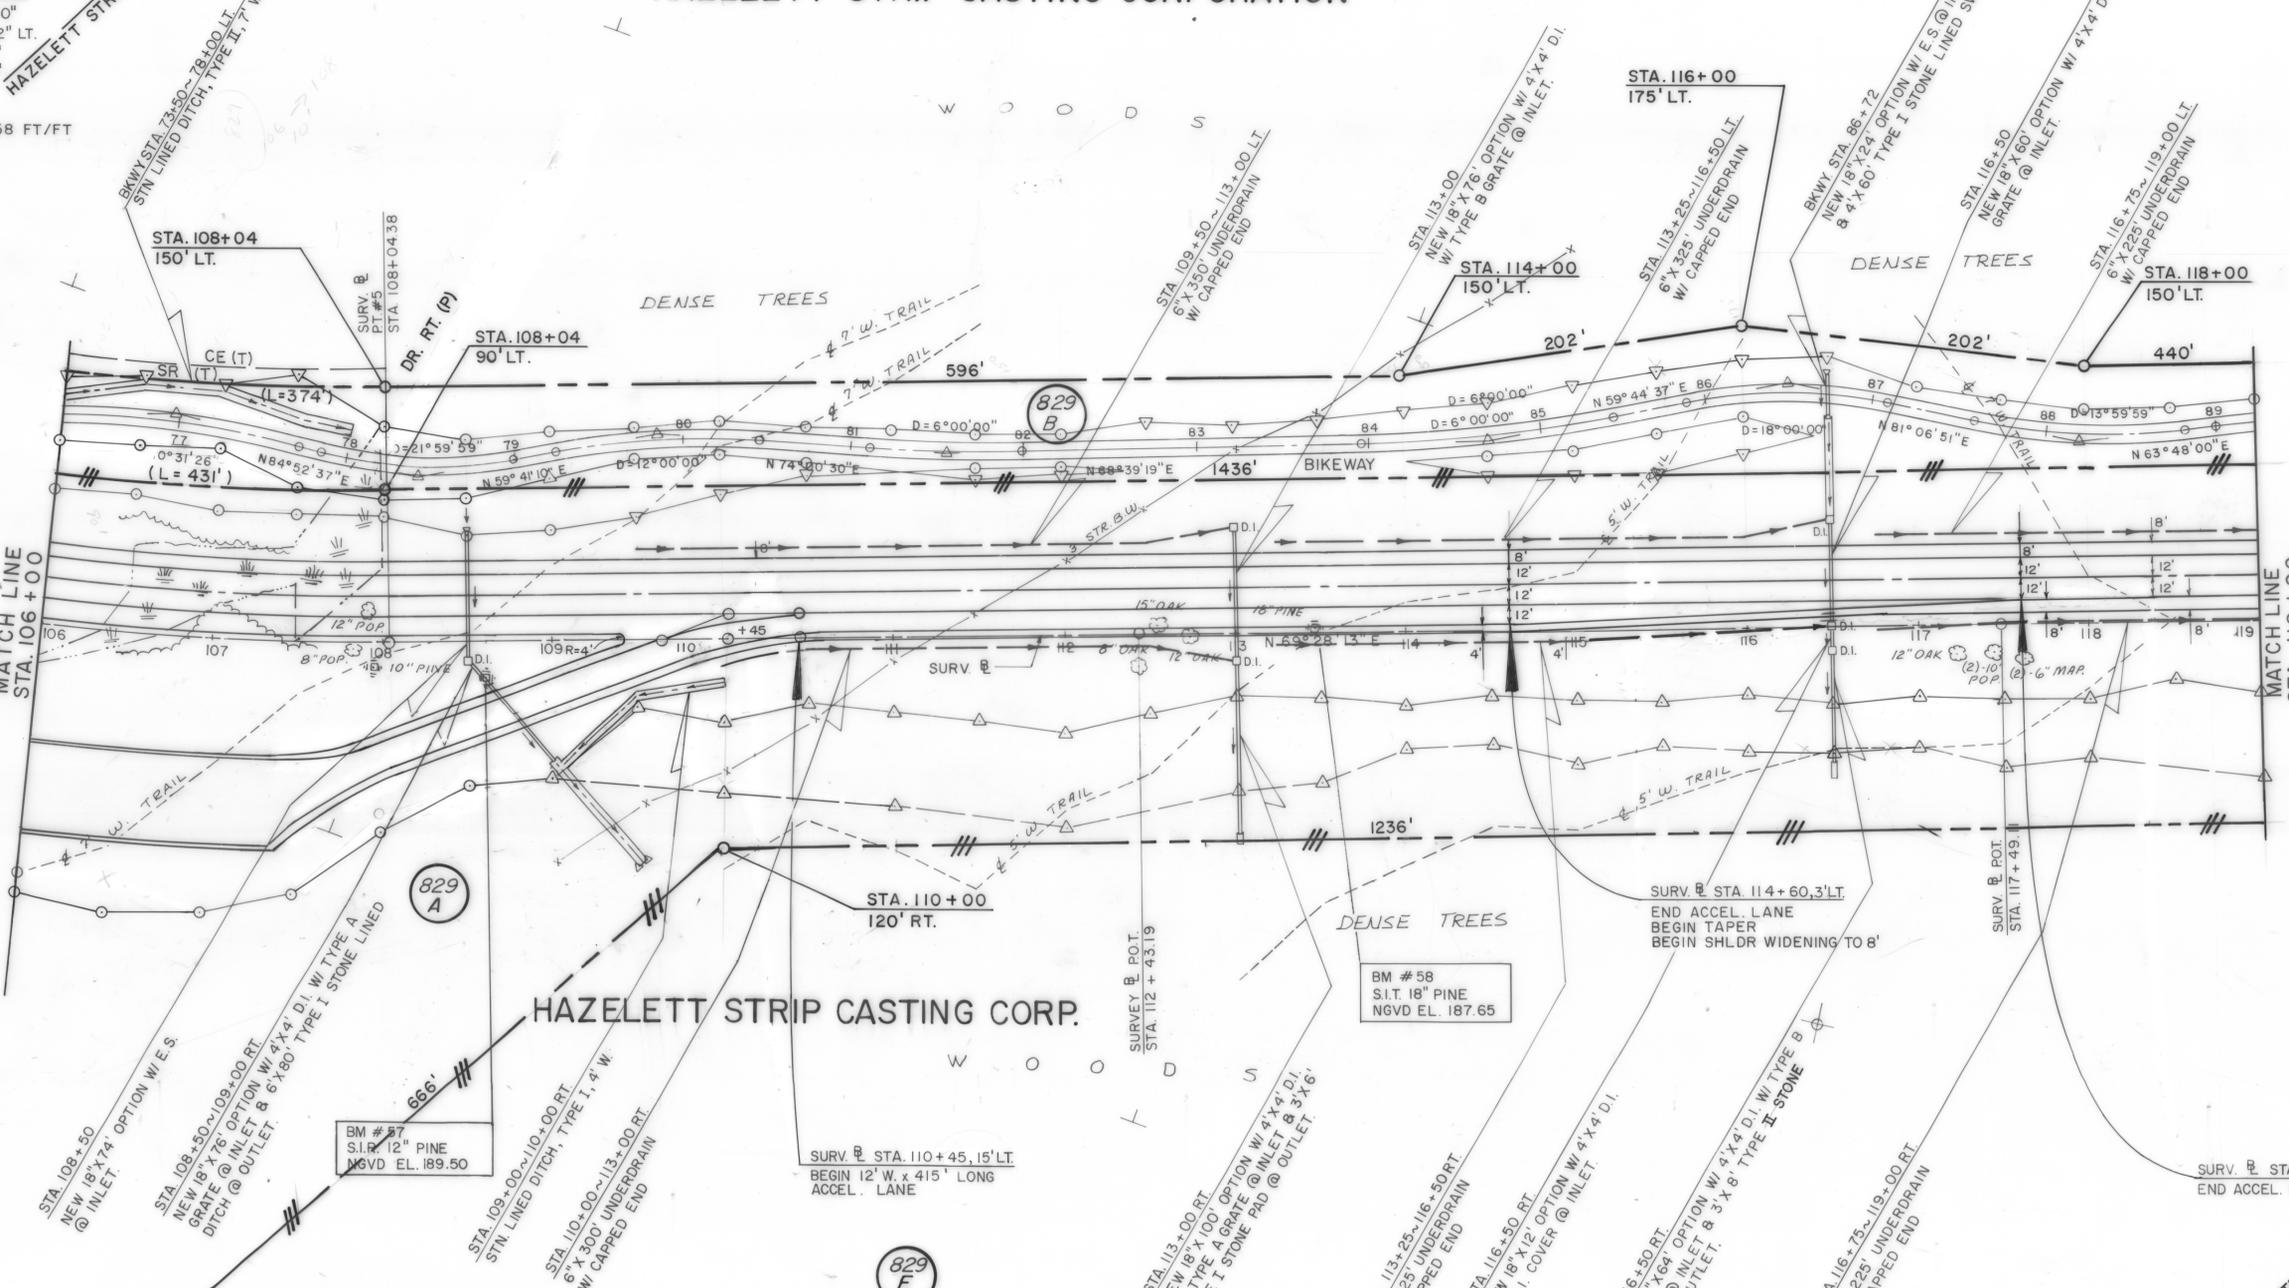

**R.O.W. PLAN**  
THIS SHEET TO BE USED  
FOR R.O.W. INFORMATION  
ONLY.

VT. SURVEY  
CONSULTANTS DATE 2/89  
DRAWN BY BRYANT ASSOC. DATE 3/89  
TRACED BY DATE  
WILLISTON-ESSEX-COLCHESTER  
SECTION 4  
NO. 033-1(1)  
SHEET 46 OF 77

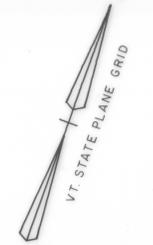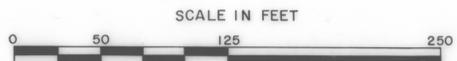

N 743,000

N 743,500

N 743,500

N 744,000

E 310,000

E 310,500

N 744,000

E 311,000

E 310,500

E 311,000

N 743,000

L 1595'

HAZELETT STRIP CASTING CORPORATION  
JAMES BROADCASTING COMPANY, INC.