


WOVEN WIRE FENCE WITH STEEL POSTS

STA. 159+28, 120' LT.	STA. 163+44, 175' LT.
STA. 163+44, 175' LT.	STA. 164+05, 175' LT.
STA. 164+05, 175' LT.	STA. 165+00, 100' LT.
STA. 165+00, 100' LT.	STA. 166+00, 100' LT.
STA. 166+00, 100' LT.	STA. 167+00, 100' LT.
STA. 167+00, 100' LT.	STA. 168+00, 100' LT.
STA. 168+00, 100' LT.	STA. 169+00, 100' LT.
STA. 169+00, 100' LT.	STA. 170+00, 100' LT.
STA. 170+00, 100' LT.	STA. 171+00, 100' LT.
STA. 171+00, 100' LT.	STA. 172+16, 333' RT.
STA. 172+16, 333' RT.	STA. 173+50, 174+00 LT.
STA. 173+50, 174+00 LT.	STA. 174+00, 174+00 LT.

SURVEY #
CURVE DATA #8
D = 3° 30' 00"
Δ = 51° 43' 25" LT.
R = 1637.02'
T = 793.55'
L = 1477.82'
E = 182.20'
BANK = 0.058 FT./FT.

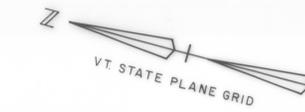

R.O.W. PLAN
THIS SHEET TO BE USED FOR R.O.W. INFORMATION ONLY.

VT. SURVEY
SURVEYED BY CONSULTANTS DATE 2/89
DRAWN BY BRYANT ASSOC. DATE 3/89
TRACED BY _____ DATE _____
WILLISTON-ESSEX-COLCHESTER SECTION 4
PROJ. PB NO. 033-1(1)
SHEET 52 OF 77

