


DATE	
BY	
NO.	
PLAN	
NO.	
DATE	
BY	
NO.	
PROFILE	
NO.	

BEGIN BIKEWAY CONSTRUCTION
 HD @ STA. 18+65, 25' RT. =
 BIKEWAY STA. 1+00.00

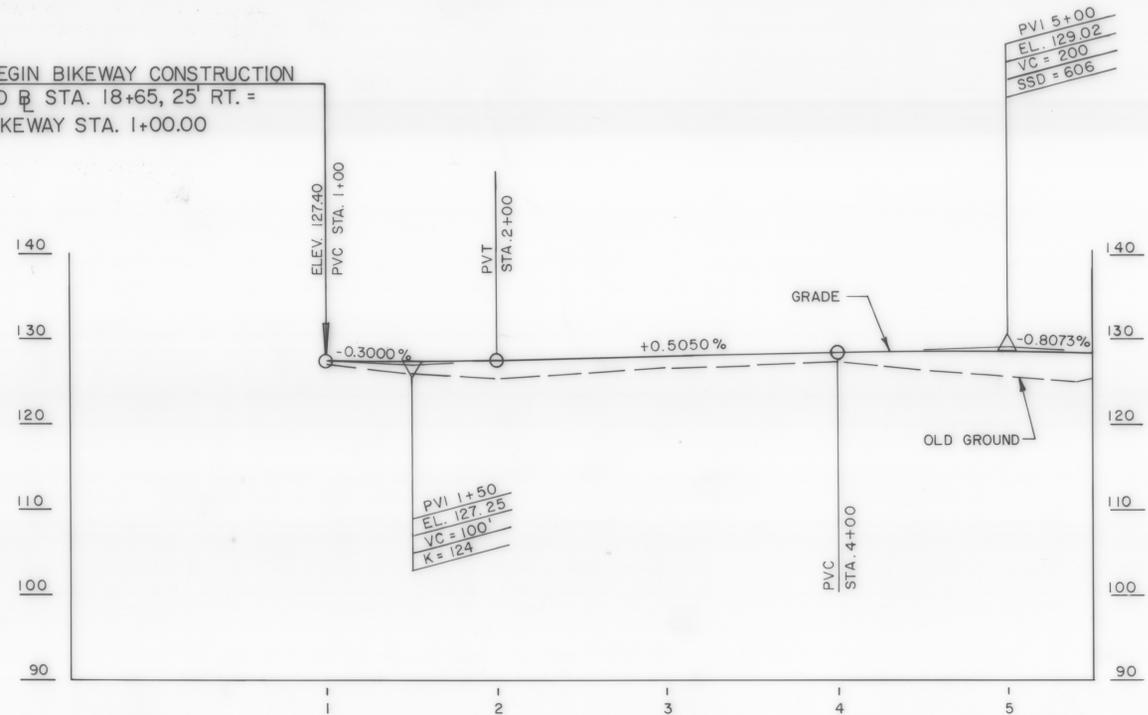

BIKEWAY PROFILE
 SCALE: 1" = 50' H
 1" = 10' V

DATE	
BY	
NO.	
PROFILE	
NO.	


VT. 289 SURV. @ STA. 27+00.00
 PROJECT NO. PB 033-1(1)
 WILLISTON - COLCHESTER

MATCH EXISTING
 HEINEBERG DRIVE
 (RTE. 127)

BEGIN CONTRACT 4

100'
 RESURFACING
 ONLY

PROFILE GRADE IN TRANSITION
 FOR ELEVATIONS, SEE "TABLES FOR
 PROFILE GRADE TRANSITION", SHT. NO. 33

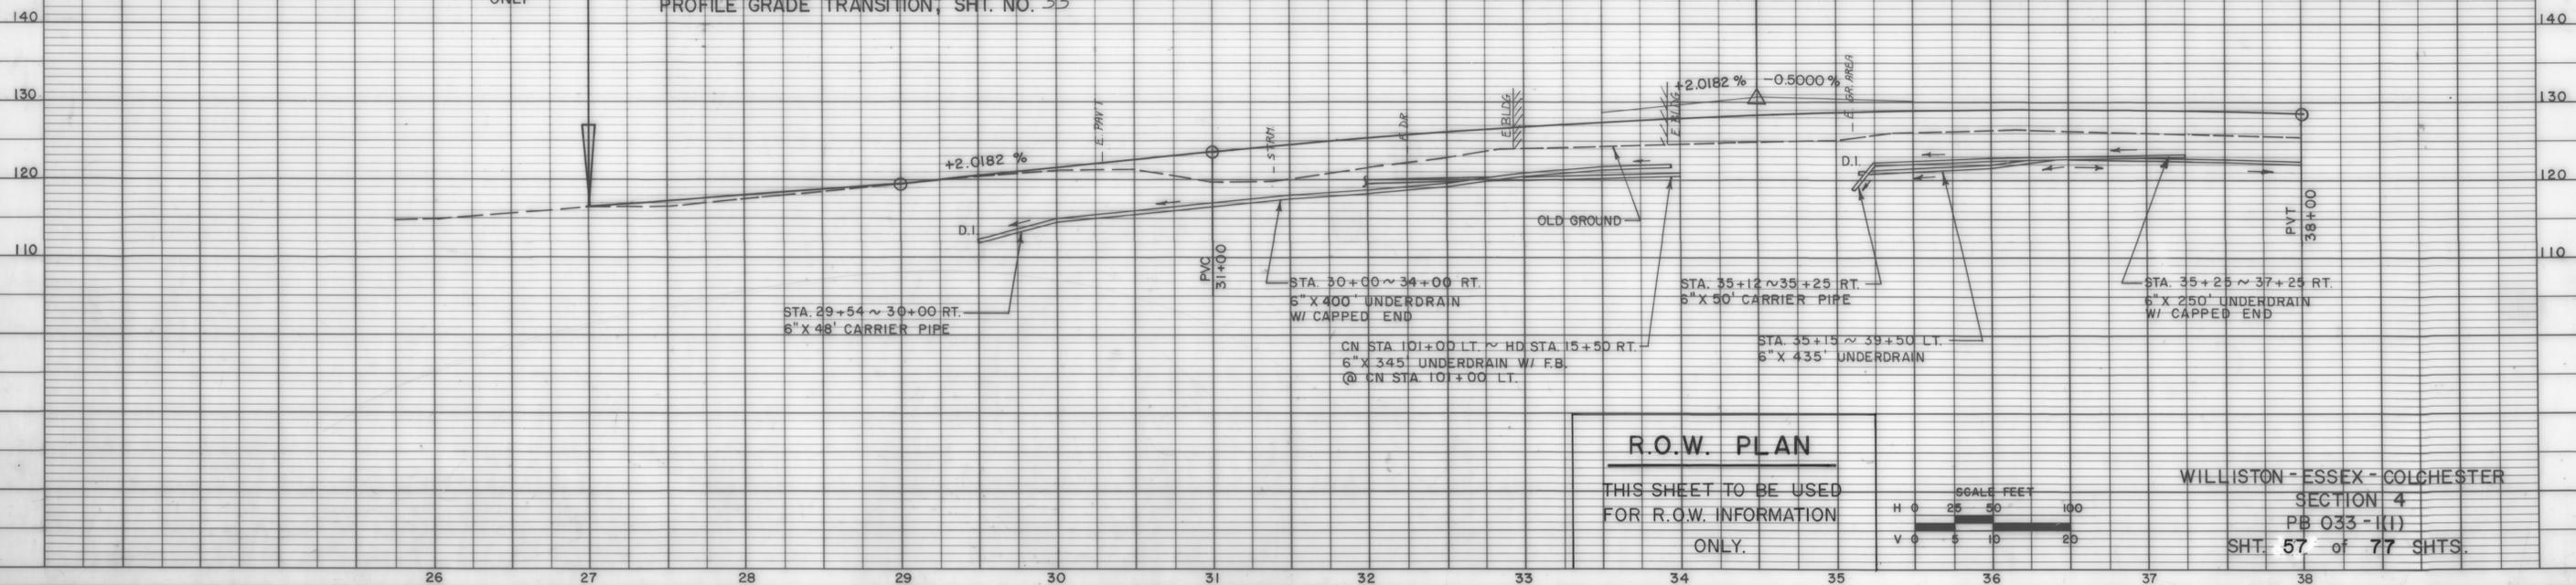

R.O.W. PLAN
 THIS SHEET TO BE USED
 FOR R.O.W. INFORMATION
 ONLY.



WILLISTON - ESSEX - COLCHESTER
 SECTION 4
 PB 033-1(1)
 SHT. 57 of 77 SHTS.