


PLAN	DATE	
	BY	
	SURVEYED	
	NOTE BOOK	



PROFILE	DATE	
	BY	
	SURVEYED	
	NOTE BOOK	

STA. 53+00
END PROFILE GRADE IN TRANSITION
FOR ELEVATIONS SEE "TABLE FOR PROFILE
GRADE TRANSITION", SHT. NO. 33
BEGIN MEDIAN EDGE PGL

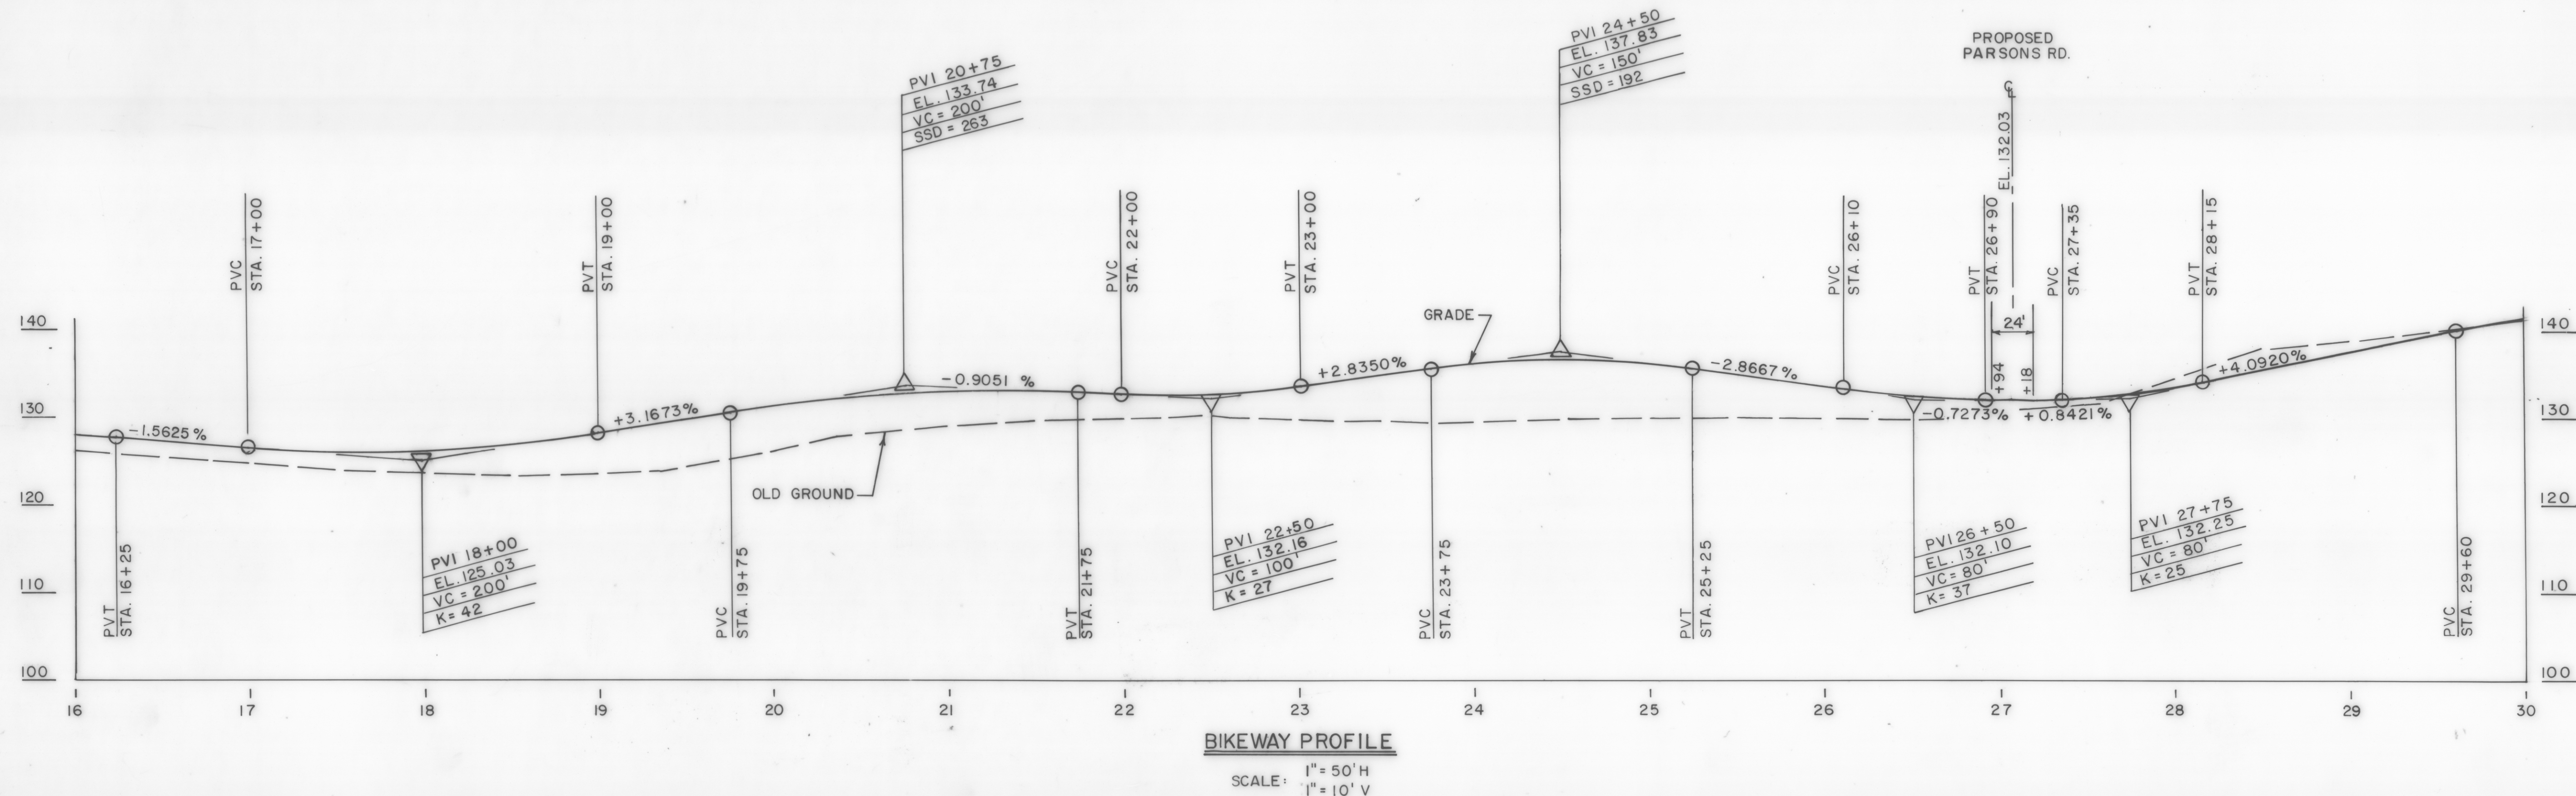