


PLAN	DATE	
	BY	
	SURVEYED	
	NOTED	



PROFILE	DATE	
	BY	
	SURVEYED	
	NOTED	

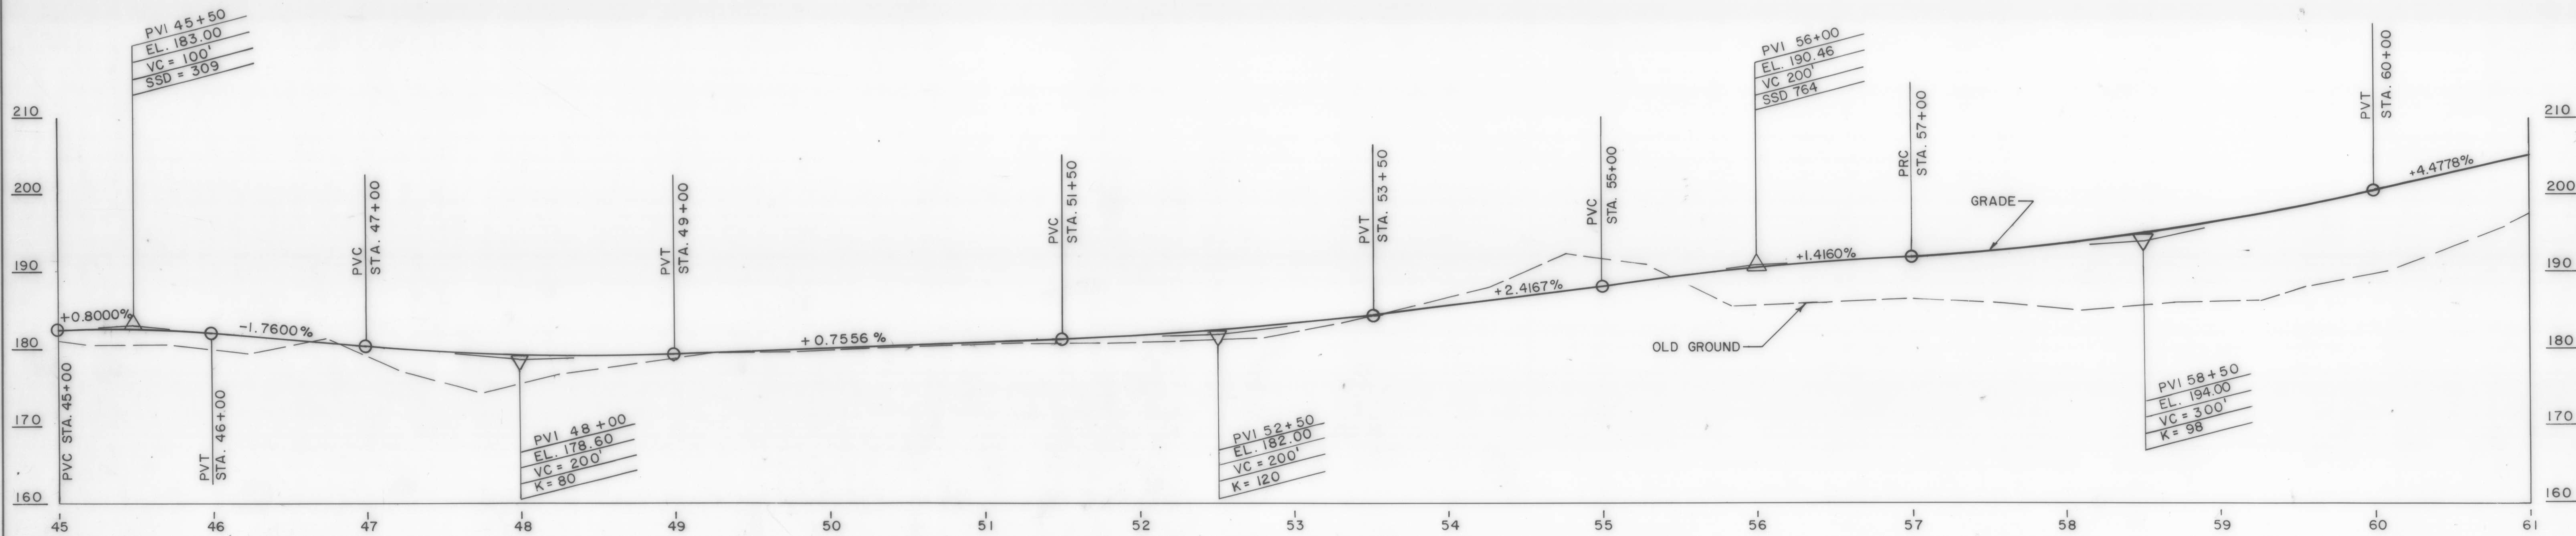