


PLAN	DATE	
	BY	
NOTE BOOK	SURVEYED	
	PLANNED	
No.	ADJUSTMENT CHECKED	
	RT. OF WAY CHECKED	



PROFILE	DATE	
	BY	
NOTE BOOK	SURVEYED	
	PLANNED	
No.	ADJUSTMENT CHECKED	
	STRUCTURE NOTATIONS CHECKED	

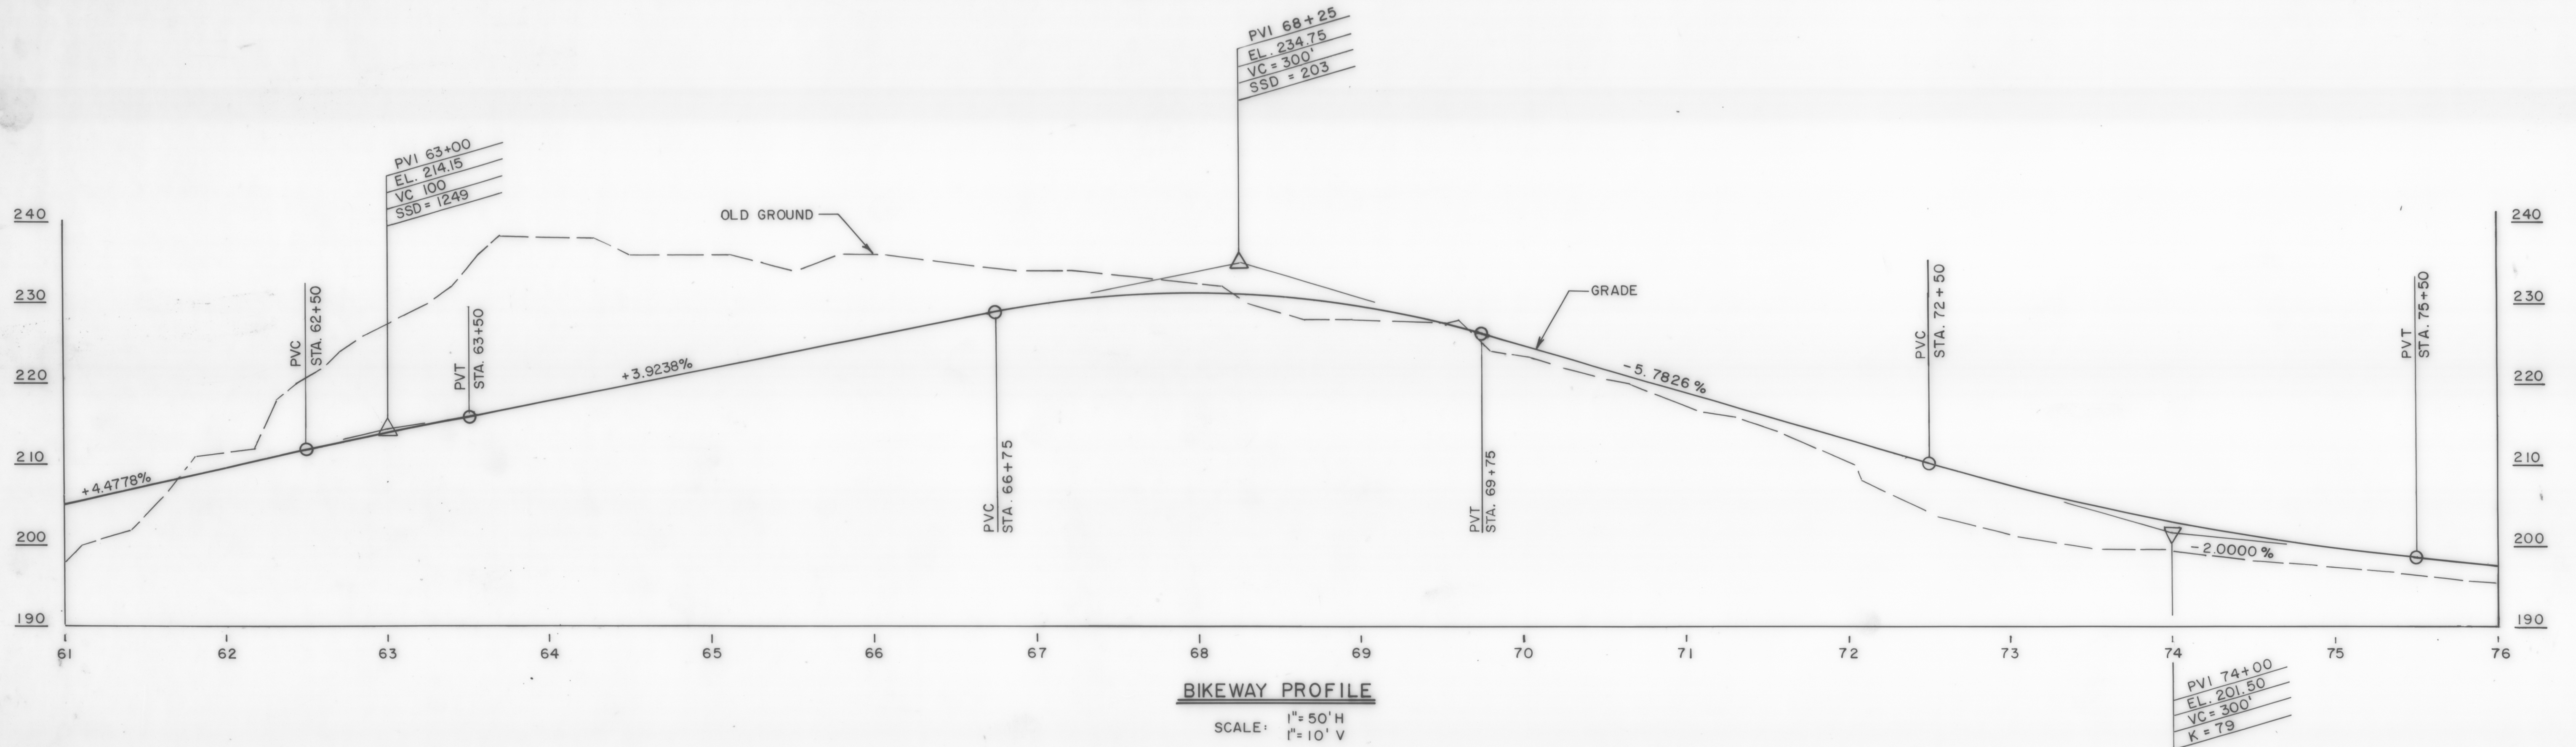