


PLAN	DATE	BY
	SURVEYED: _____ PLOTTED: _____ CHECKED: _____ RT. OF WAY CHECKED: _____	
NOTE BOOK NO. _____		



PROFILE	DATE	BY
	SURVEYED: _____ PLOTTED: _____ CHECKED: _____ STRUCTURE NOTATIONS CHECKED: _____	
NOTE BOOK NO. _____		

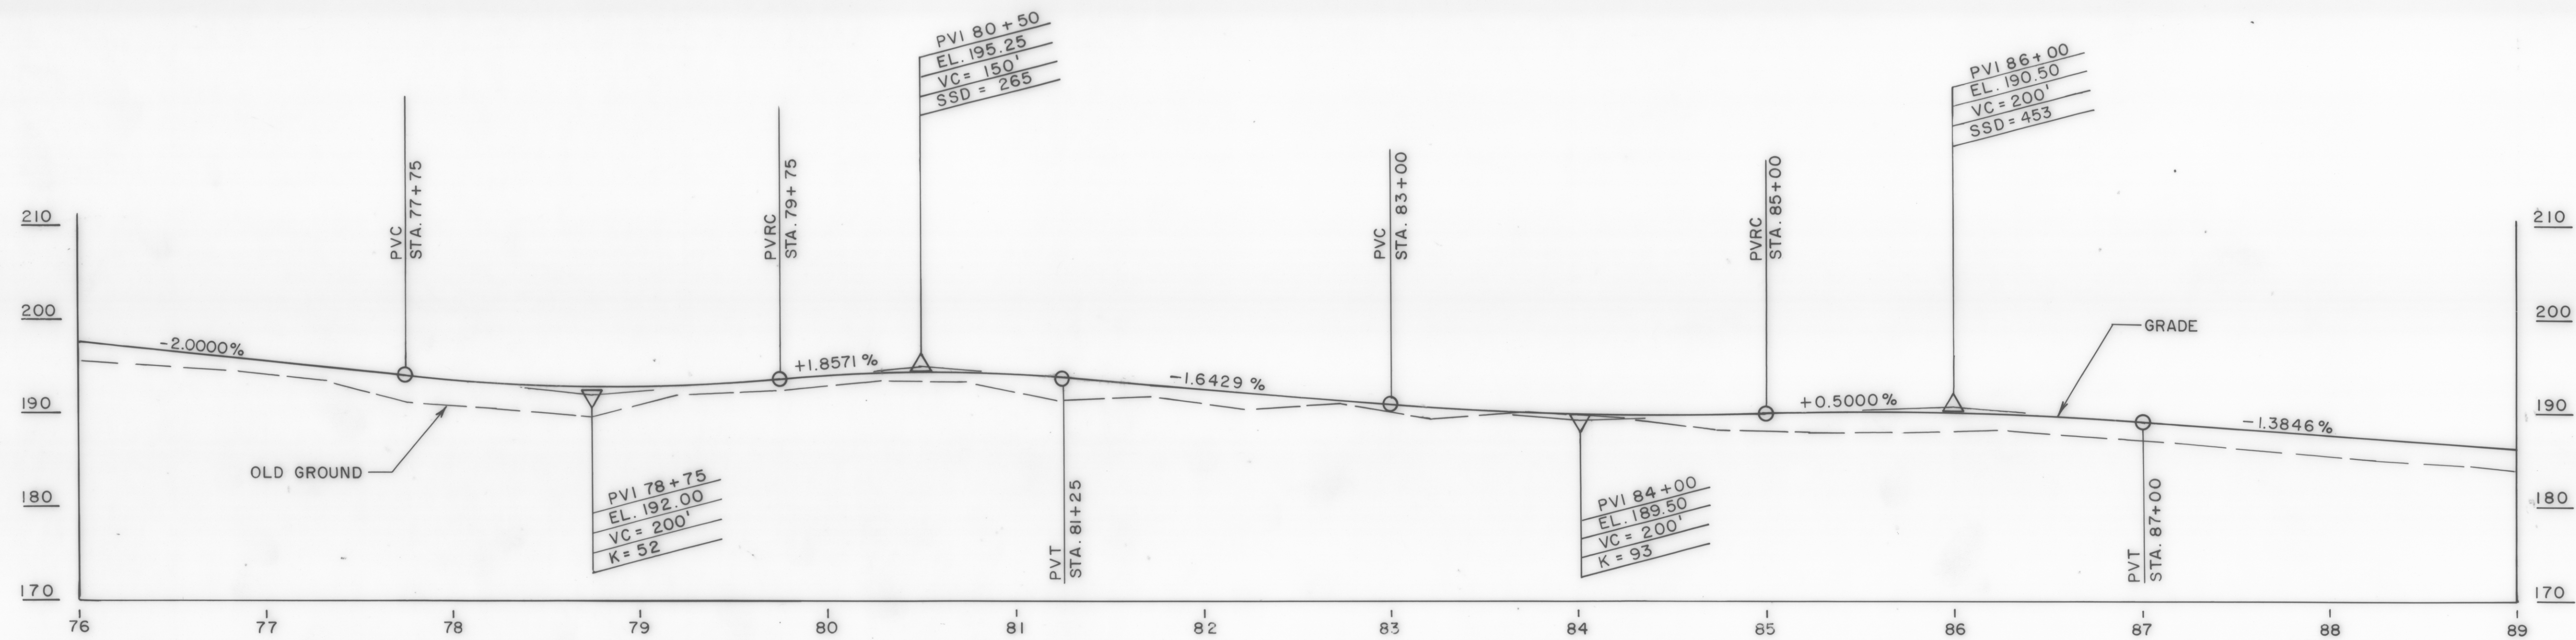