


BIKEWAY PROFILE

SCALE: 1" = 50' H
1" = 10' V

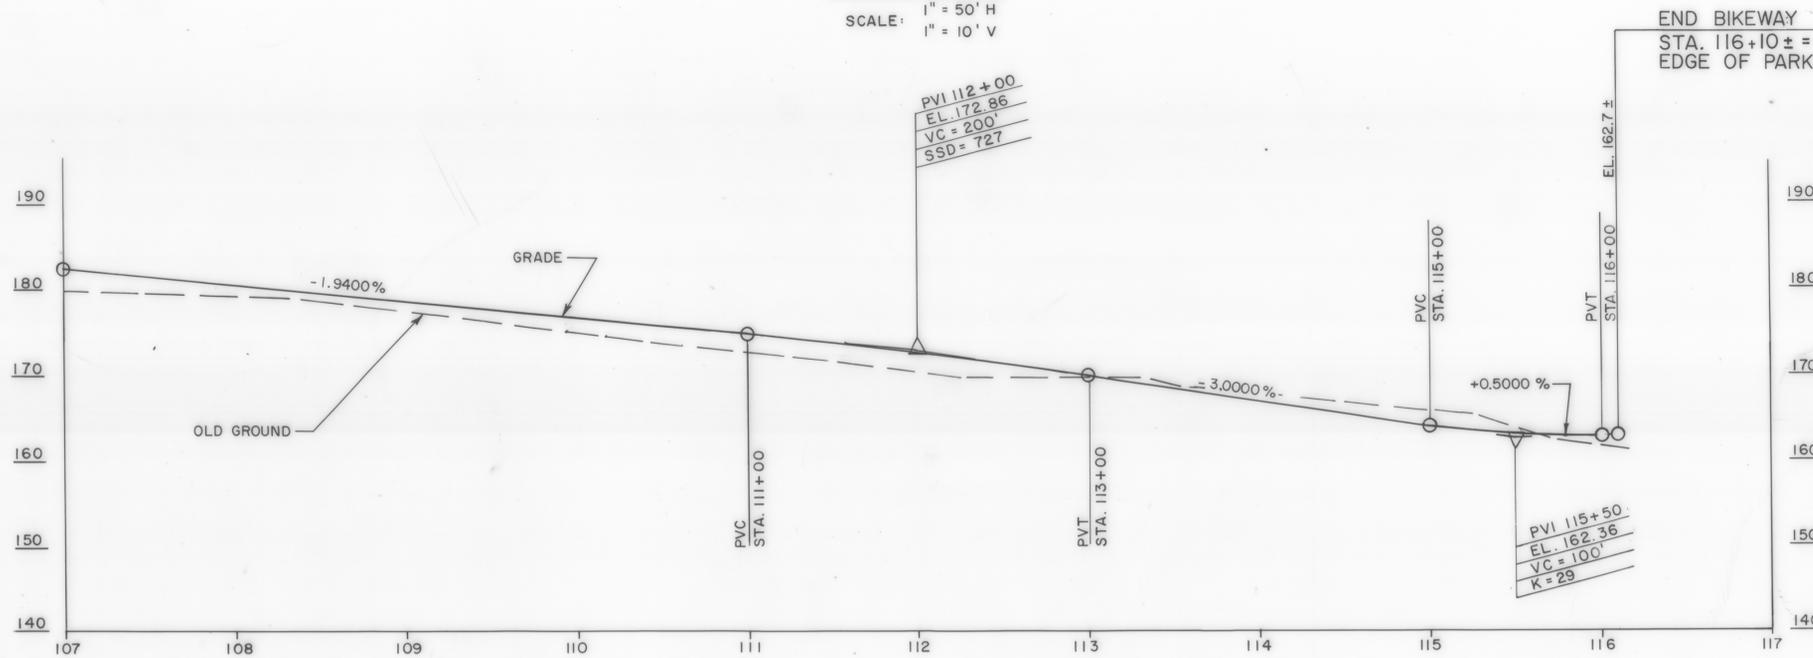

BIKEWAY PROFILE

SCALE: 1" = 50' H
1" = 10' V

R.O.W. PLAN

THIS SHEET TO BE USED
FOR R.O.W. INFORMATION
ONLY.

VT. SURVEY CONSULTANTS DATE 8/90
DRAWN BY BRYANT ASSOC. DATE 10/90
TRACED BY DATE

PARKSIDE DRIVE
PROJ. PB NO. 033 - (1)
SHEET 69 OF 77