


BEGIN RADIO STATION ACCESS DR.  
STA. 1+00.00  
MATCH EXISTING

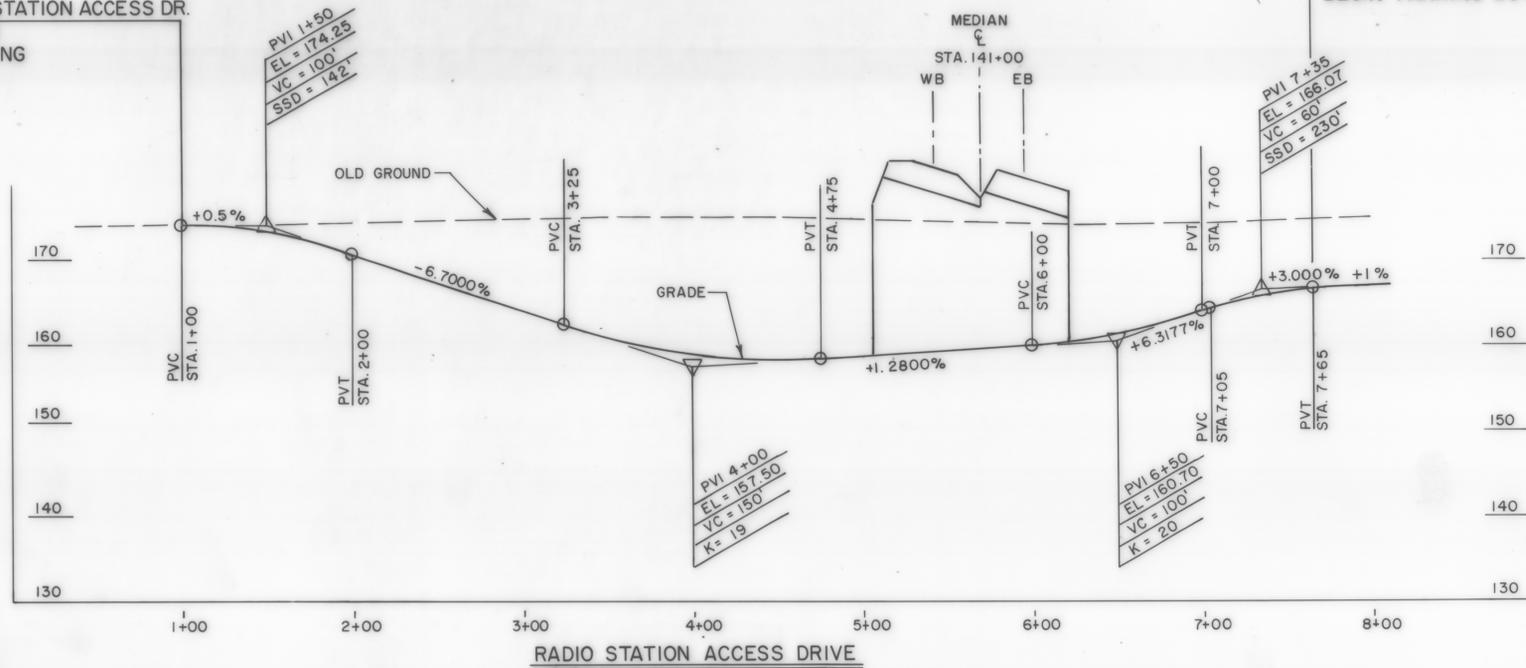


END RADIO STATION ACCESS DR.  
STA. 7+69.00  
BEGIN PARKING LOT

RADIO STATION ACCESS DRIVE

SCALE: 1" = 50' V  
1" = 10' H

BEGIN CONSTRUCTION  
REV. C STA. 10+00.00 =  
SURV. B STA. 10+00.00, 3' LT.  
MATCH EXISTING

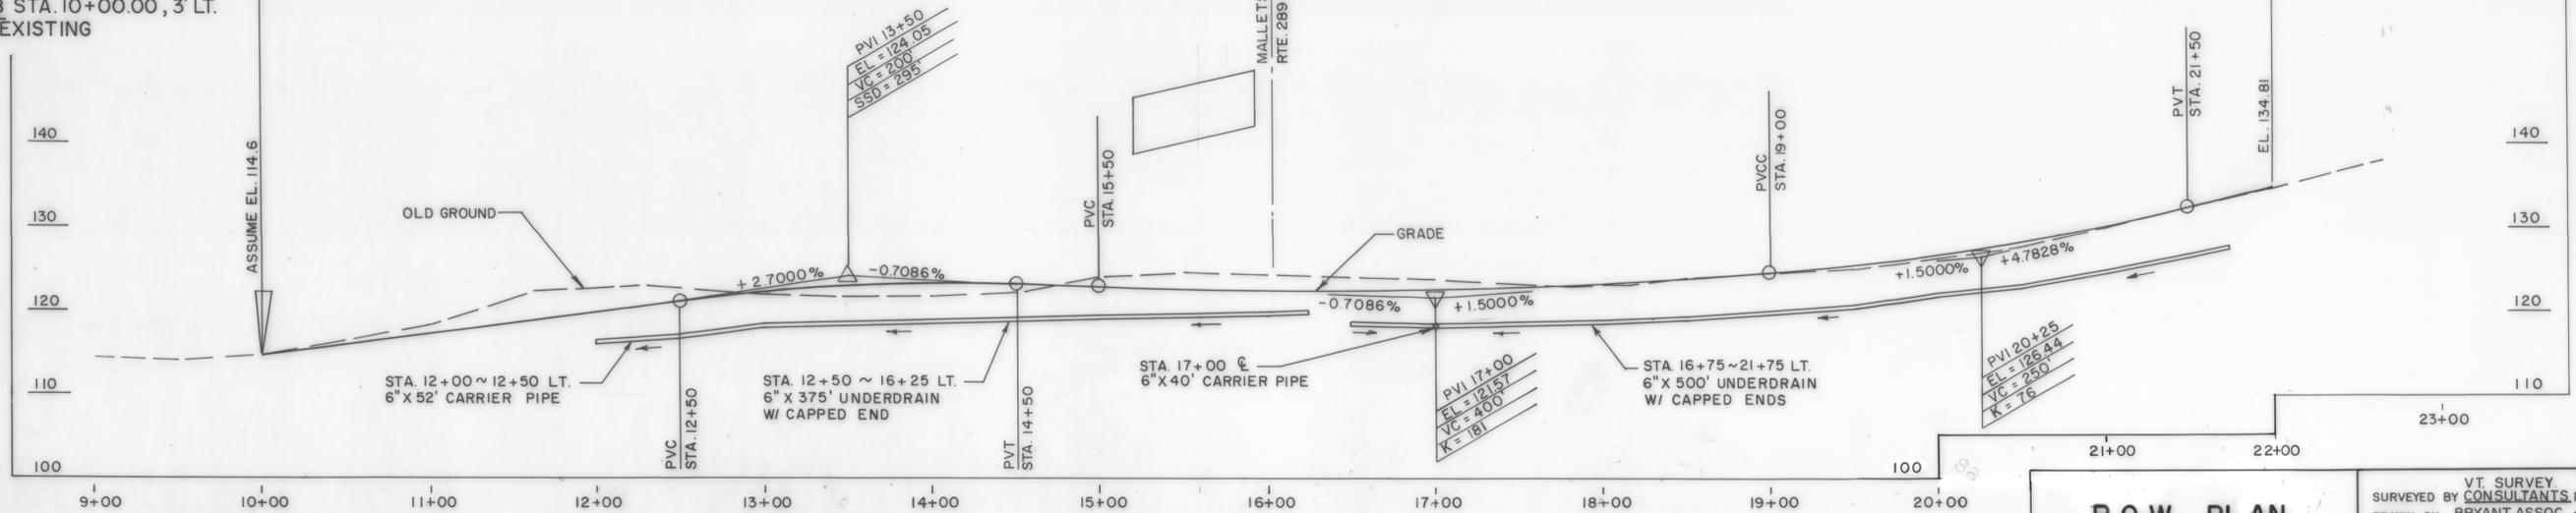

END CONSTRUCTION  
REV. C STA. 22+00 =  
SURV. B STA. 22+00.05, 25' RT.  
MATCH EXISTING

MALLETTS BAY AVENUE

SCALE: 1" = 50' V  
1" = 10' H

**R.O.W. PLAN**

THIS SHEET TO BE USED  
FOR R.O.W. INFORMATION  
ONLY.

VT. SURVEY  
CONSULTANTS, DATE \_\_\_\_\_  
DRAWN BY BRYANT ASSOC. DATE \_\_\_\_\_  
TRACED BY \_\_\_\_\_ DATE \_\_\_\_\_  
WILLISTON-ESSEX-COLCHESTER  
SECTION 4  
PROJ. PB NO. 033-1(1)  
SHEET 71 OF 77