


TYPICAL SECTIONS

3" BITUMINOUS CONCRETE PAVEMENT - 1 1/4" TYPE III WEARING COURSE, 1 3/4" TYPE II BINDING COURSE
 3" BITUMINOUS CONCRETE PAVEMENT, TYPE I - BASE COURSE 1-3" COURSE
 30" SUBBASE OF DENSE GRADED CRUSHED STONE
 SHOULDERS 1 1/4" BITUMINOUS CONCRETE PAVEMENT
 18" SAND BORROW

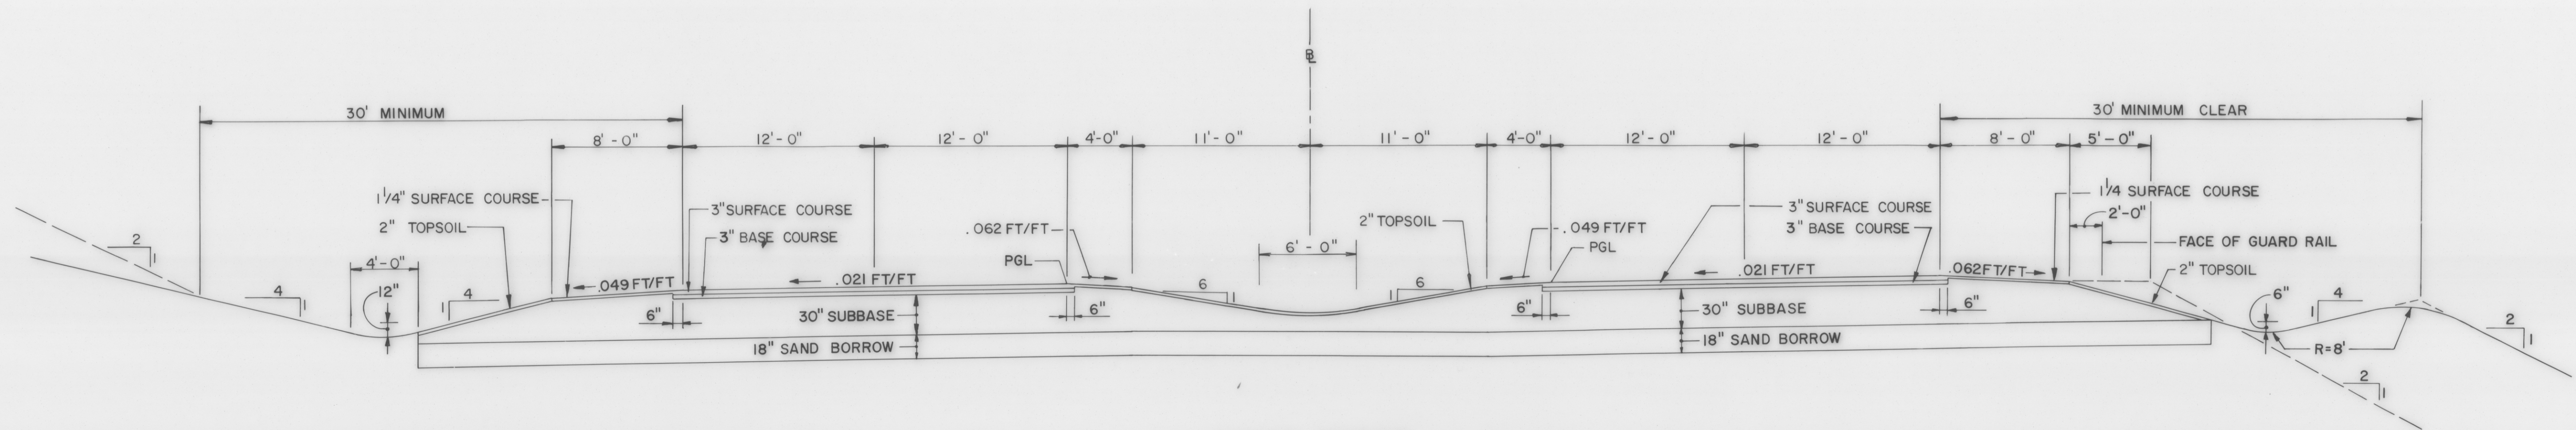

BANKED SECTION

RIGHT SIDE
 STA 756+00 TO 760+00

NOTE:
 WHEN EXISTING SUBGRADE MATERIAL IN A CUT MEETS OR EXCEEDS THE REQUIREMENTS FOR SAND BORROW, THE EXISTING MATERIAL SHALL REMAIN AND THE SAND BORROW SHALL BE ELIMINATED IN THAT AREA.

DATUM
 VERTICAL _____
 HORIZONTAL _____

R. O. W. PLANS

SURVEYED BY PINKHAM ENG. DATE 6/87
 DRAWN BY R.C.A. DATE 8/88
 TRACED BY N.P.D. DATE 8/88
 VERMONT ROUTE 289 (F.A.P.)
 TOWN OF WILLISTON
 PROJ WILLISTON NO. PB 033-1(1)
 COLCHESTER
 SHEET 5 OF 35