



RAMP TYPICAL SECTIONS

3" BITUMINOUS CONCRETE PAVEMENT - 1 1/4" TYPE III WEARING COURSE, 1 3/4" TYPE II BINDING COURSE
 3" BITUMINOUS CONCRETE PAVEMENT, TYPE I - BASE COURSE 1-3" COURSE
 30" SUBBASE OF DENSE GRADED CRUSHED STONE
 SHOULDERS 1 1/4" BITUMINOUS CONCRETE PAVEMENT
 18" SAND BORROW

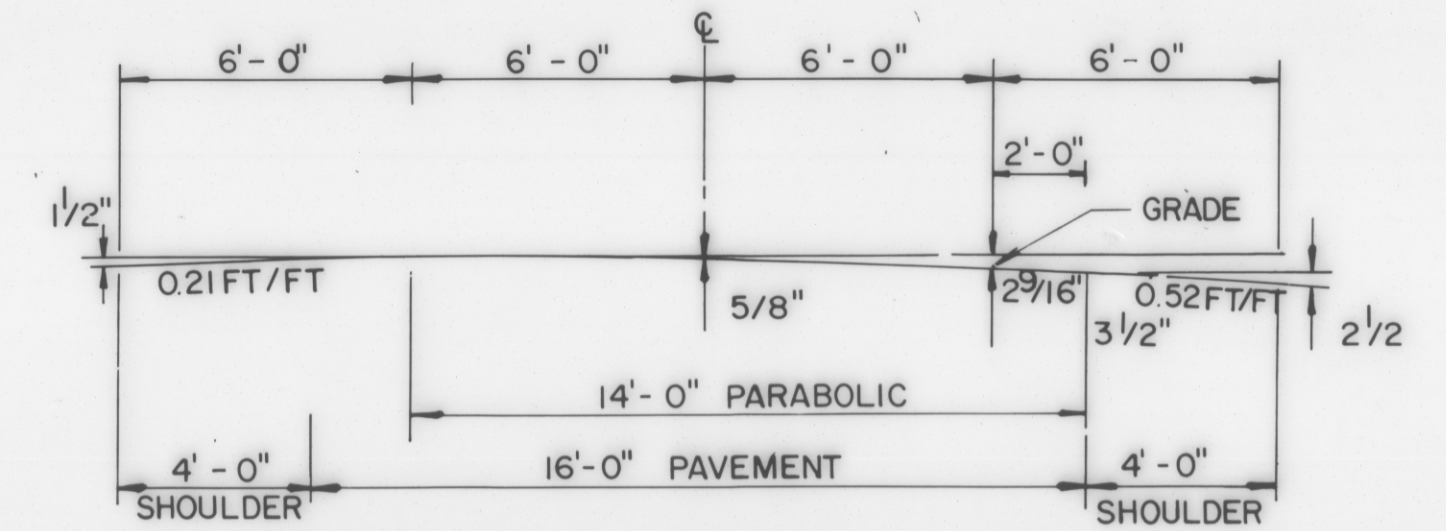

CROSS-SLOPE & PARABOLIC DETAIL

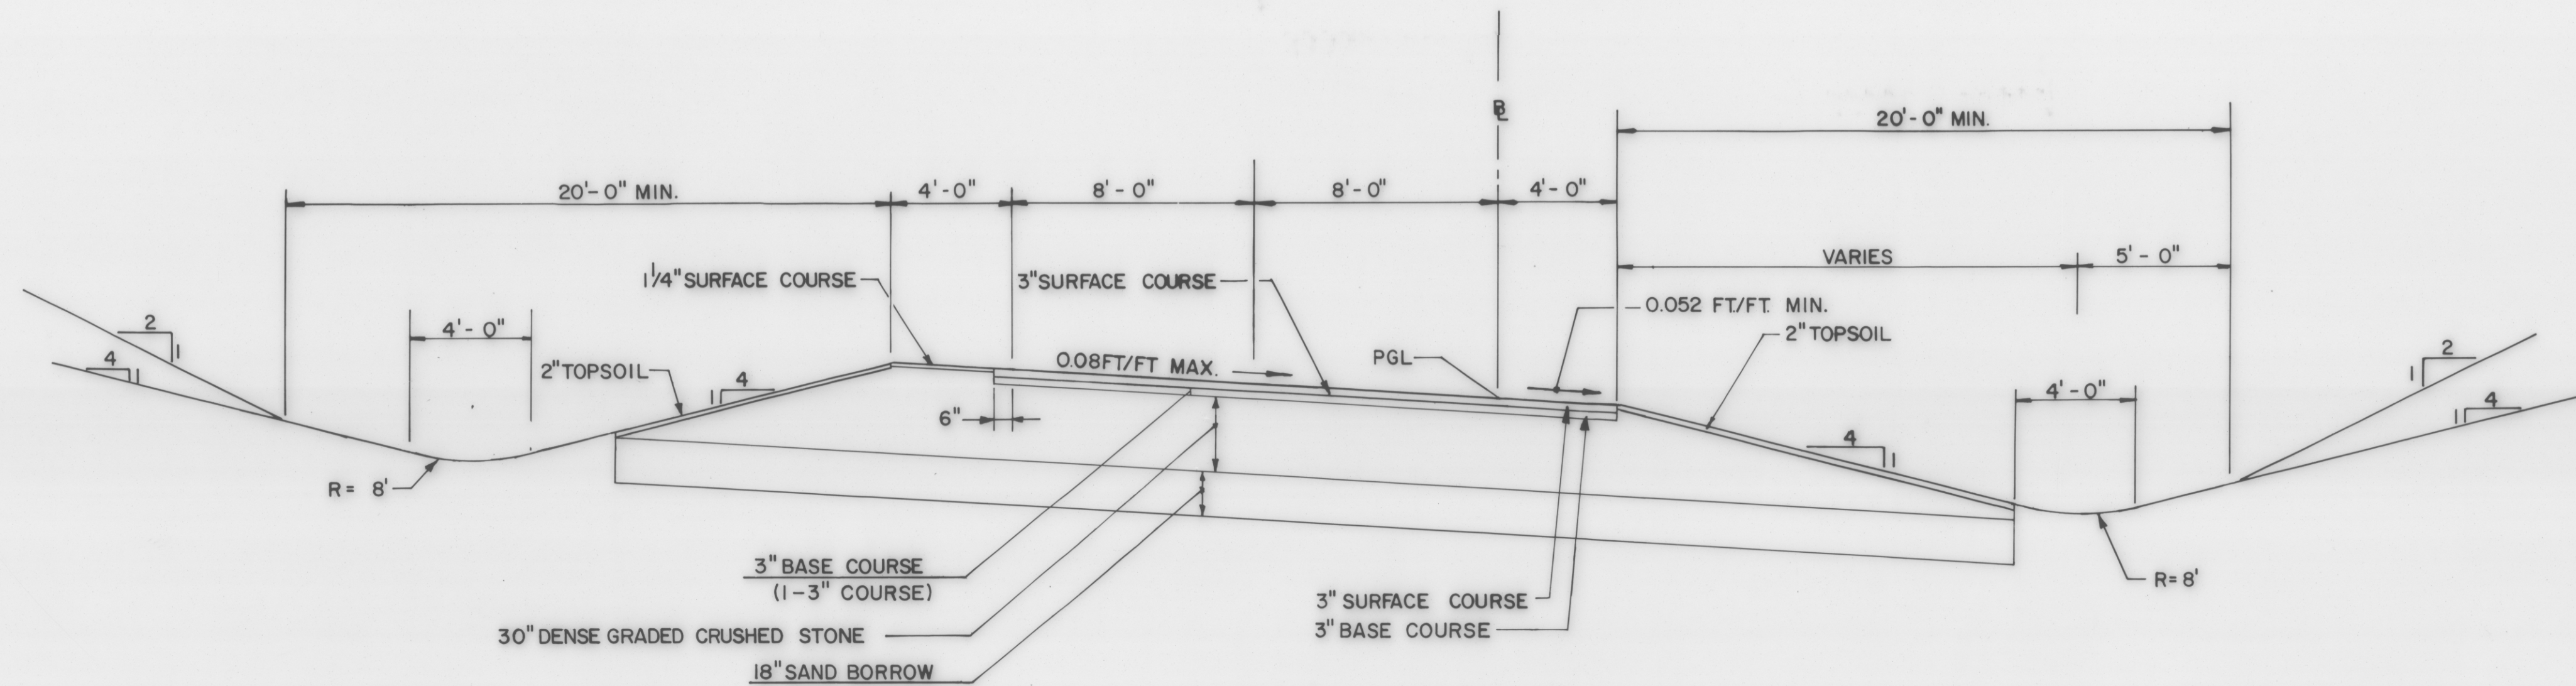


TYPICAL RAMP - BANKED SECTION

SCALE : 1/4" = 1'-0" VERT.
 1/4" = 1'-0" HORZ.

SHOULDER PAVEMENT TO INCLUDE FULL DEPTH OF PAVEMENT AND BASE

RAMP A	STA 45+06 TO 48+00 LT
	STA 49+00 TO 56+00 RT
RAMP B	STA 0+00 TO 8+43 RT
RAMP C	STA 0+00 TO 3+00 RT
	STA 7+00 TO 15+10 RT
RAMP D	STA 0+00 TO 4+30 RT
	STA 8+75 TO 16+60 RT
RAMP E	STA 0+00 TO 4+50 RT

NOTE:
 WHEN EXISTING SUBGRADE MATERIAL IN A CUT MEETS OR EXCEEDS THE REQUIREMENTS FOR SAND BORROW, THE EXISTING MATERIAL SHALL REMAIN AND THE SAND BORROW SHALL BE ELIMINATED IN THAT AREA.

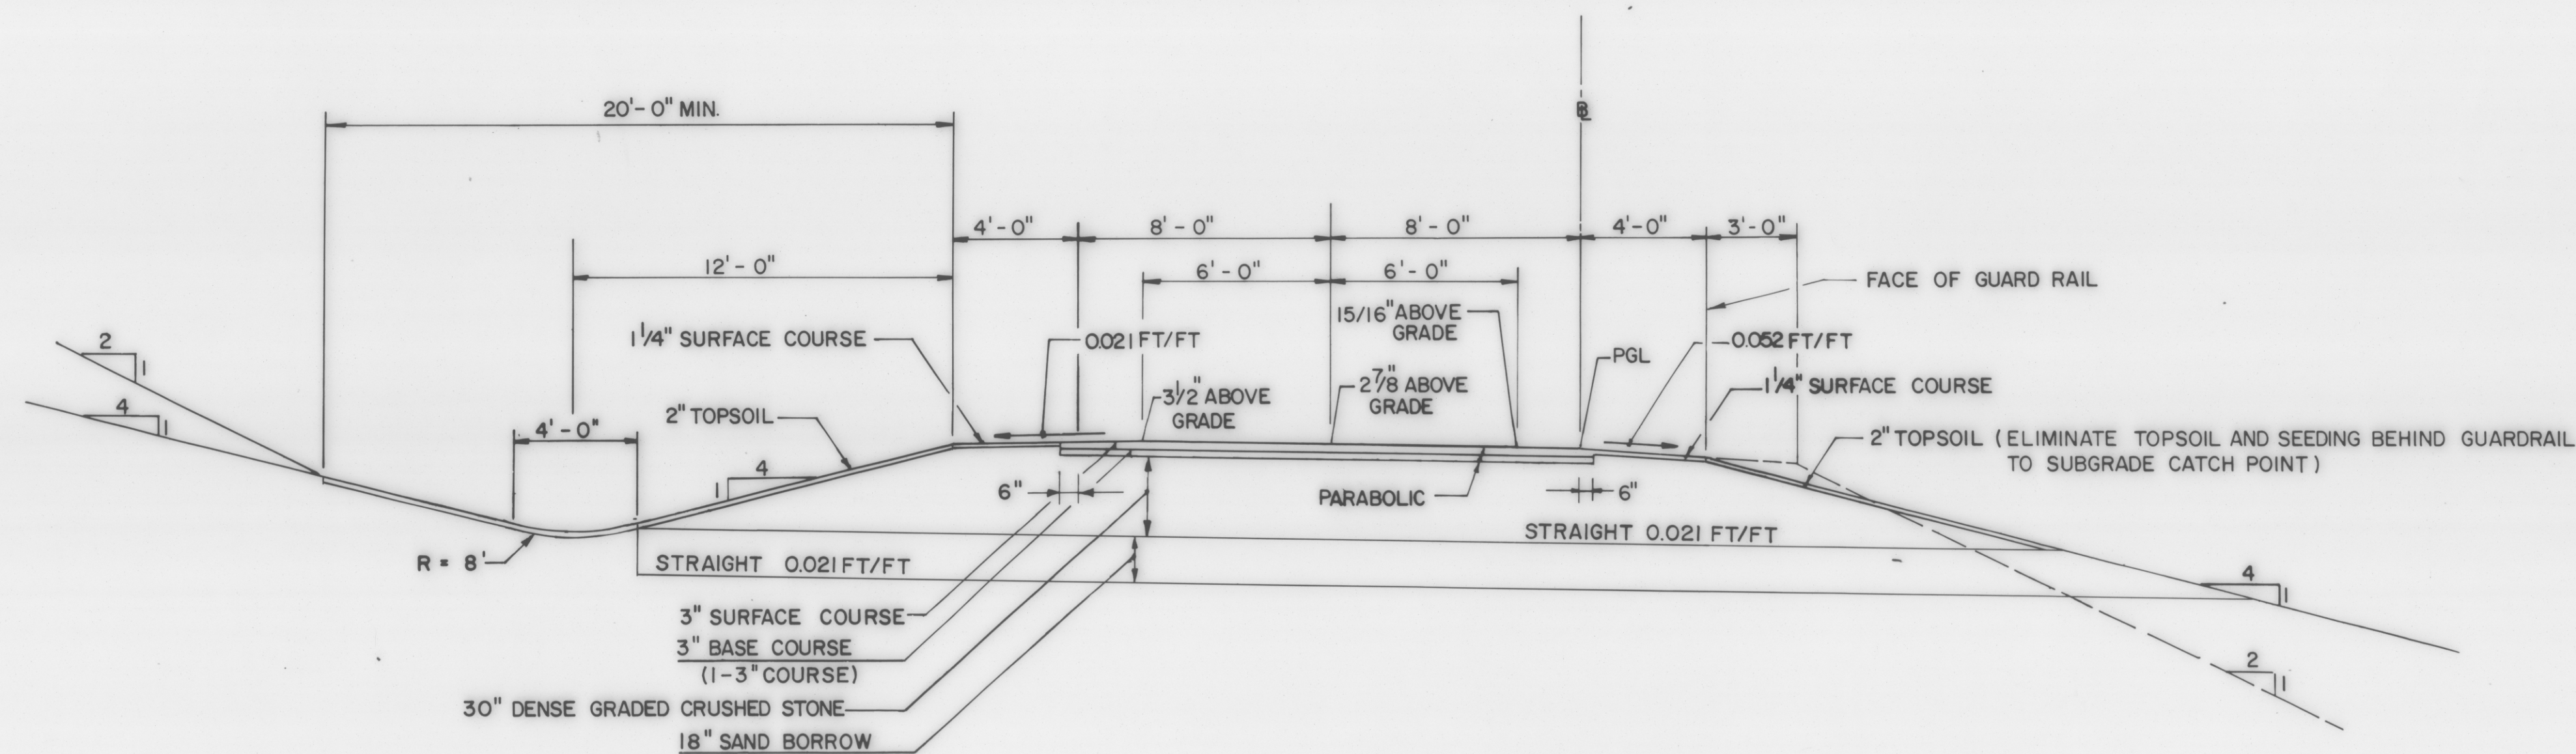

TYPICAL RAMP - NORMAL SECTION

SCALE : 1/4" = 1'-0" VERT.
 1/4" = 1'-0" HORZ.

DATUM
 VERTICAL _____
 HORIZONTAL _____

R. O. W. PLANS

SURVEYED BY PINKHAM ENG. DATE 6/86
 DRAWN BY S.K.O. DATE 1/87
 TRACED BY N.P.D. DATE 2/87
 VERMONT ROUTE 289 (F.A.P.)
 TOWN OF WILLISTON
 PROJ. WILLISTON NO. PB 033-1(1)
 COLCHESTER
 SHEET 6 OF 35