


**CURVE #2**  
 R = 60.00'  
 $\Delta = 84^\circ 02' 03.584''$   
 D = 95° 24' 36.68"  
 L = 88.00'  
 T = 54.06'  
 E = 20.76'

**CURVE #1**  
 R = 45'  
 $\Delta = 86^\circ 12' 40.505''$   
 D = 127° 19' 26"  
 L = 67.71'  
 T = 42.12'  
 E = 16.64'

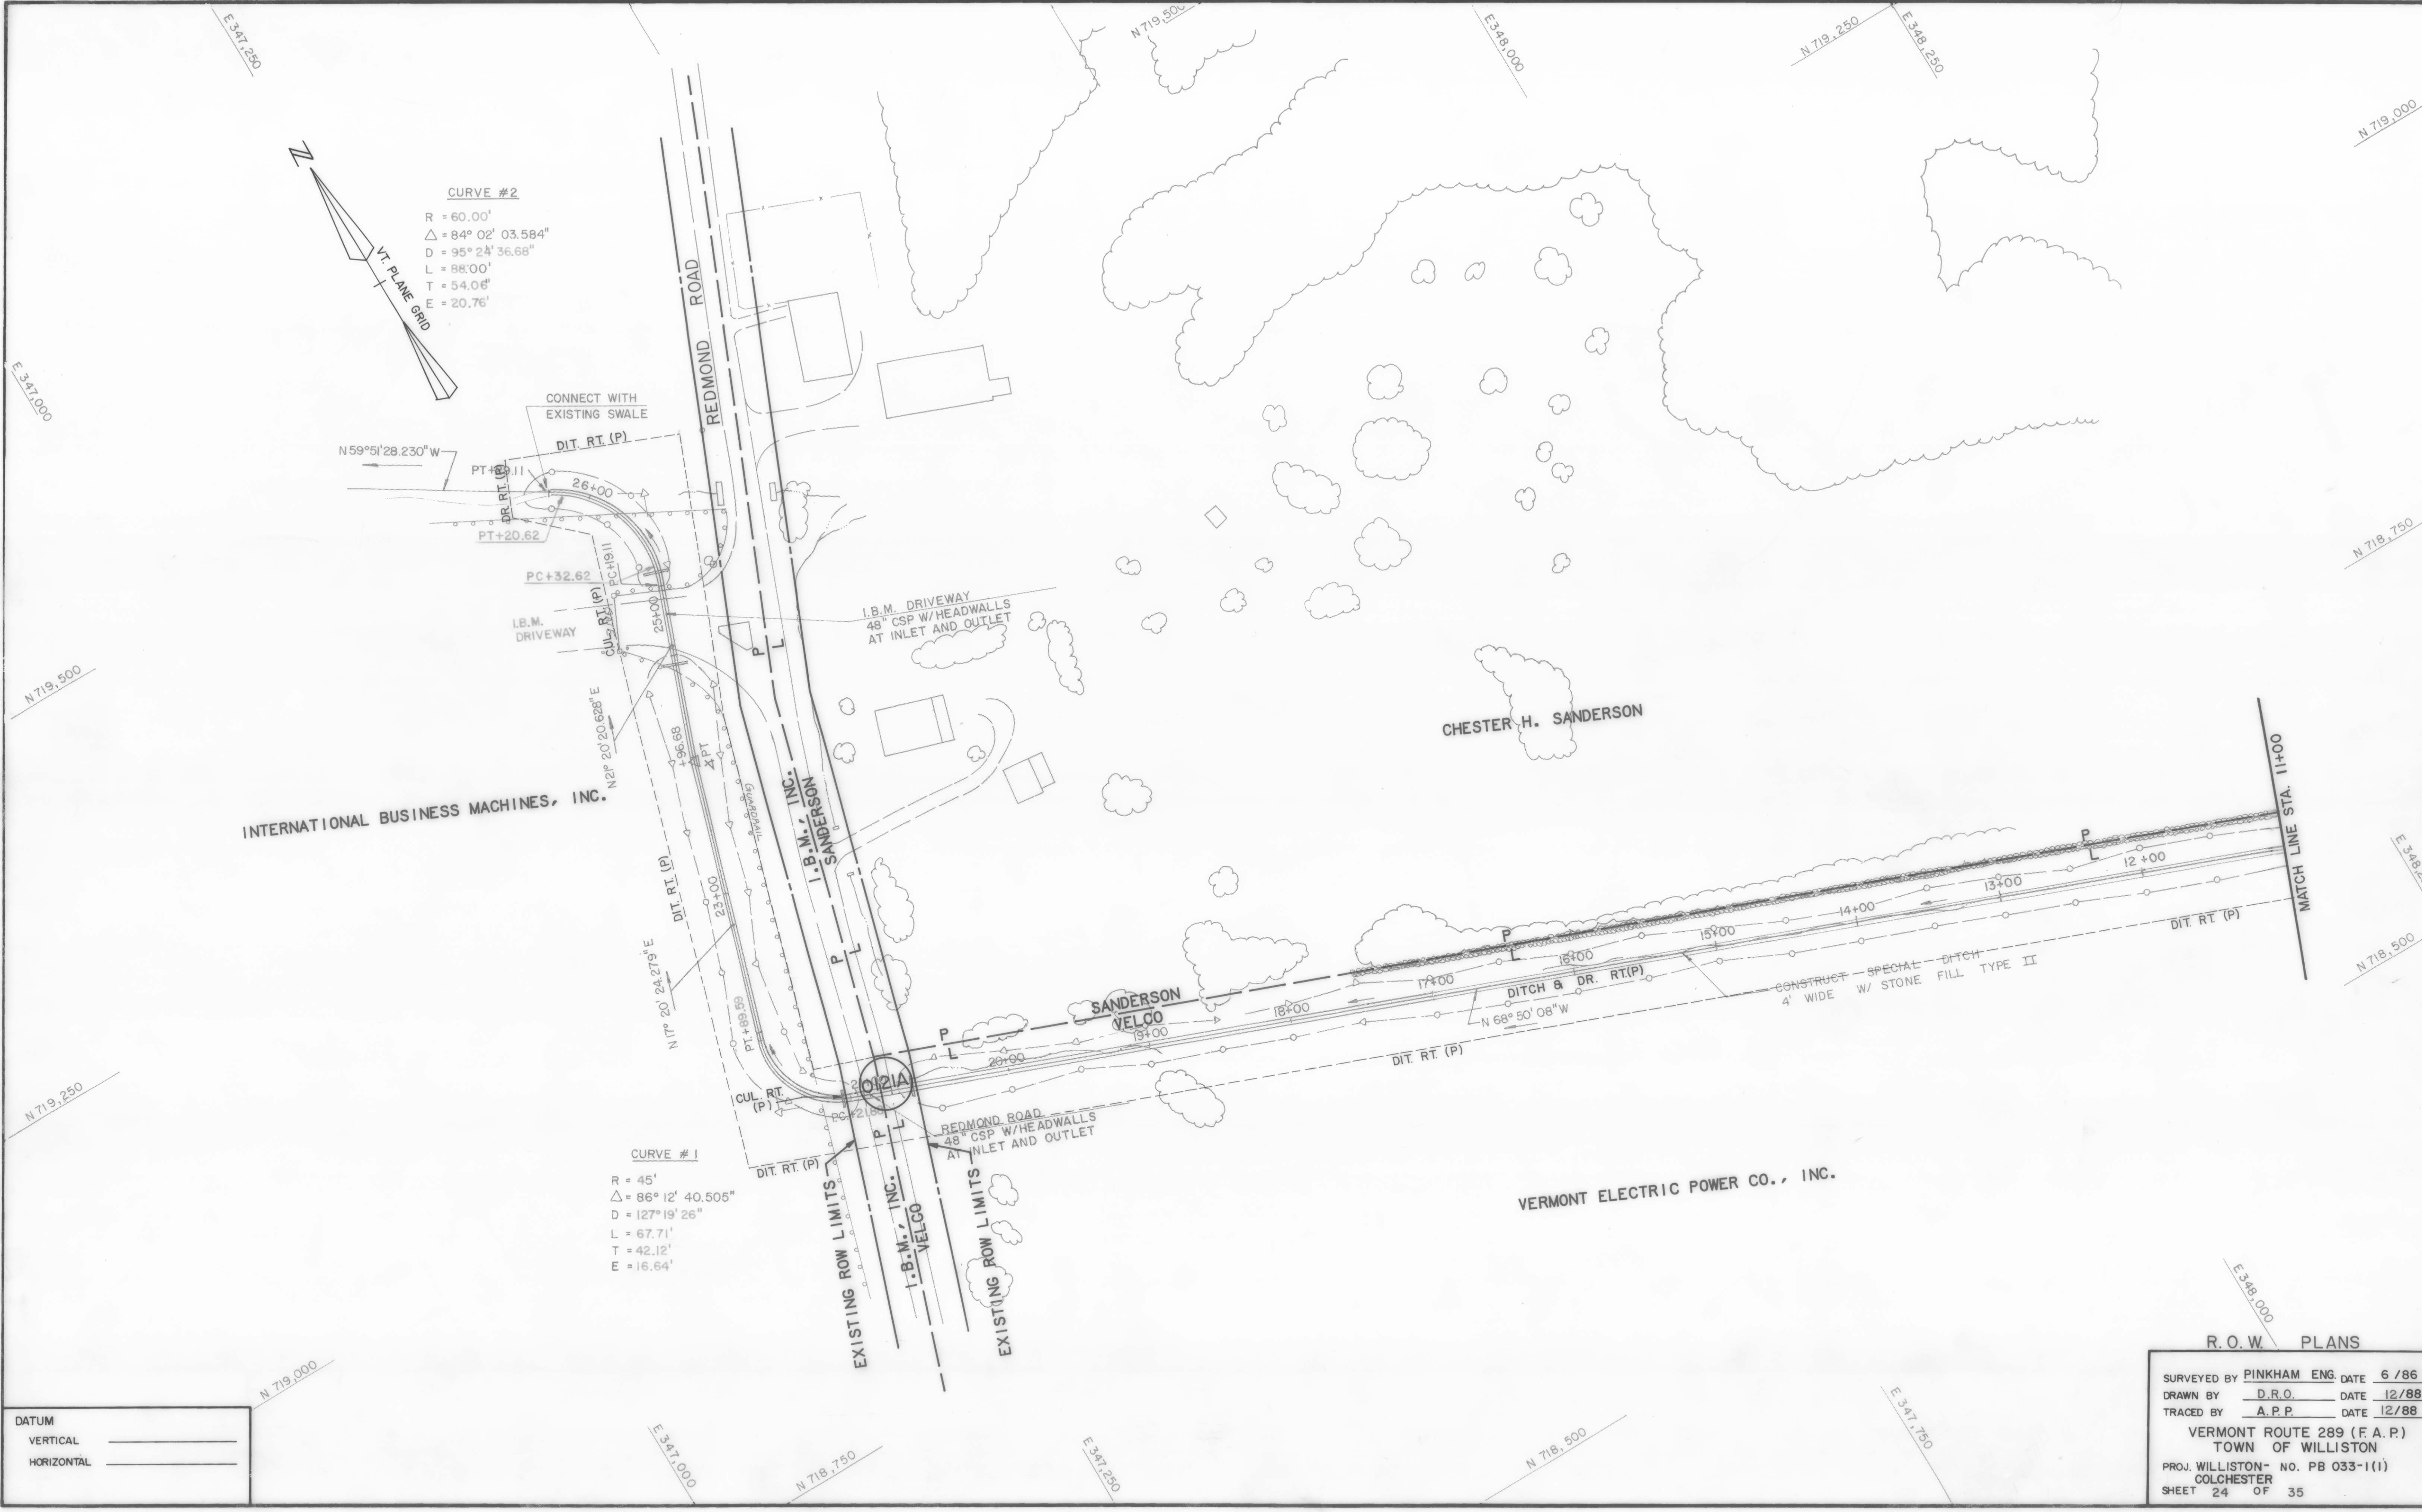

DATUM  
 VERTICAL \_\_\_\_\_  
 HORIZONTAL \_\_\_\_\_

**R.O.W. PLANS**  
 SURVEYED BY PINKHAM ENG. DATE 6/86  
 DRAWN BY D.R.O. DATE 12/88  
 TRACED BY A.P.P. DATE 12/88  
 VERMONT ROUTE 289 (F.A.P.)  
 TOWN OF WILLISTON  
 PROJ. WILLISTON- NO. PB 033-1(1)  
 COLCHESTER  
 SHEET 24 OF 35