

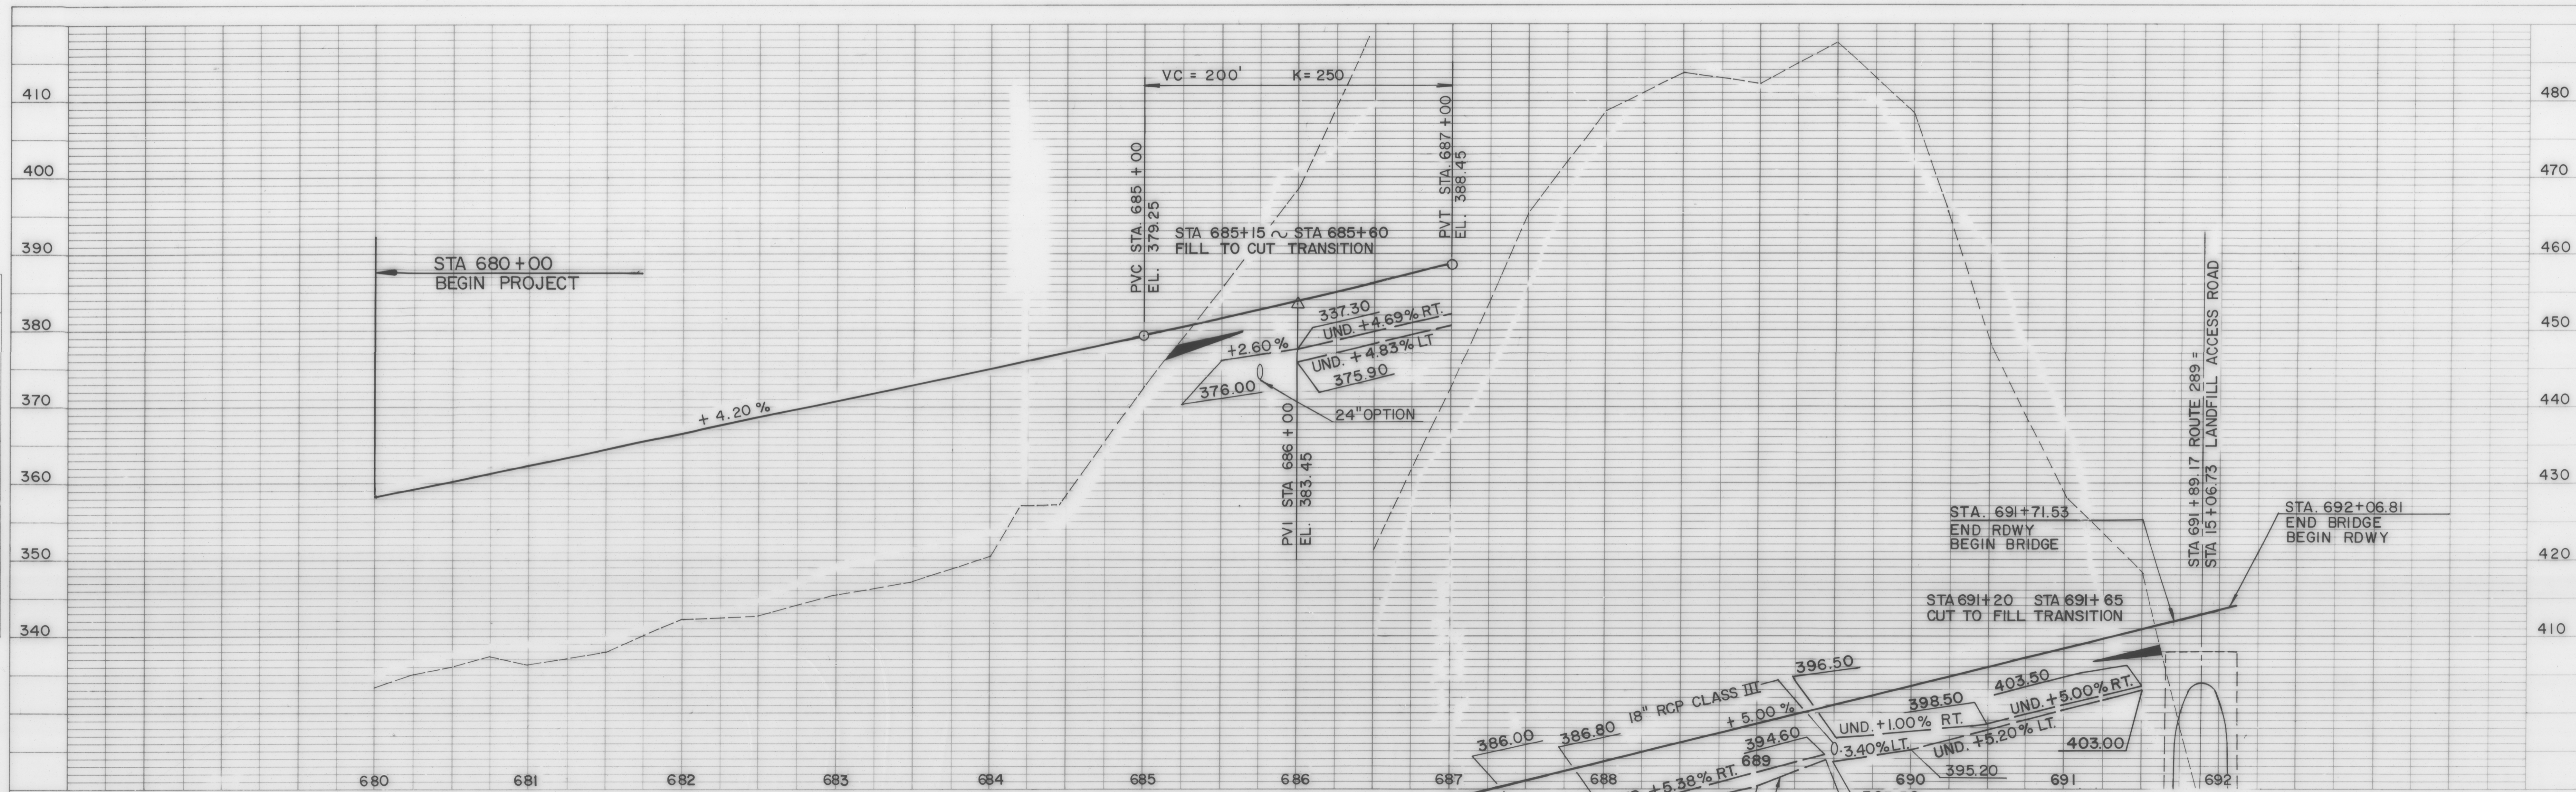


PROFILE SURVEYED BY DATE
 NOTE BOOK GRADES CHECKED B.M.'s NOTED
 NO. STRUCTURE NOTATIONS CH'VD

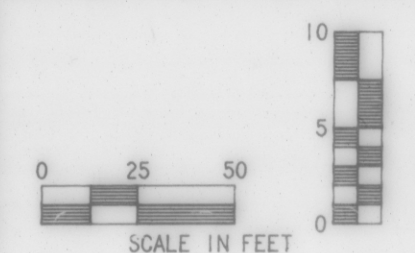

PROFILE SURVEYED BY DATE
 NOTE BOOK GRADES CHECKED B.M.'s NOTED
 NO. STRUCTURE NOTATIONS CH'VD

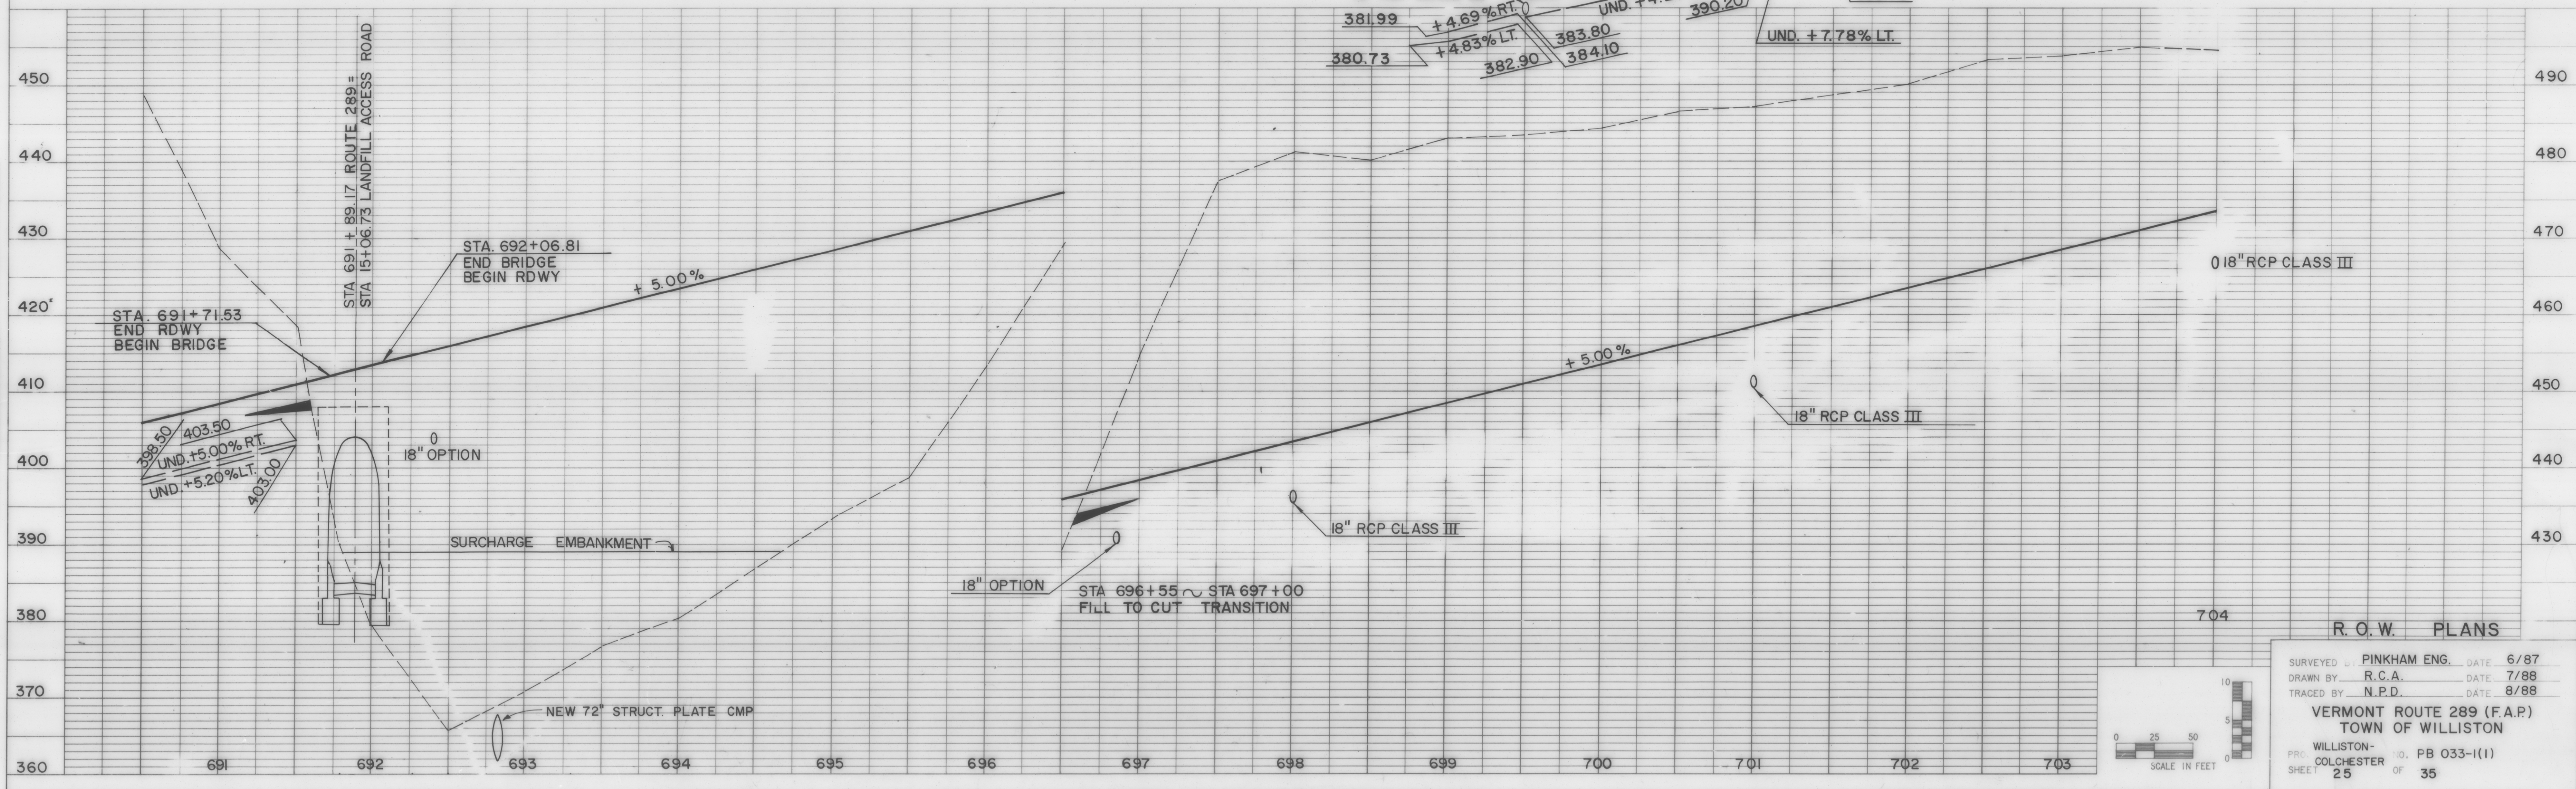

R.O.W. PLANS

SURVEYED BY PINKHAM ENG. DATE 6/87
 DRAWN BY R.C.A. DATE 7/88
 TRACED BY N.P.D. DATE 8/88

**VERMONT ROUTE 289 (F.A.P.)
 TOWN OF WILLISTON**

WILLISTON- COLCHESTER 10. PB 033-1(1)
 SHEET 25 OF 35