
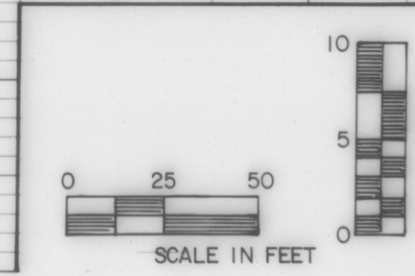


DATE: _____
 BY: _____
 CHECKED: _____
 PLAN
 NOTE BOOK: _____
 No. _____

DATE: _____
 BY: _____
 CHECKED: _____
 PROFILE
 NOTE BOOK: _____
 No. _____

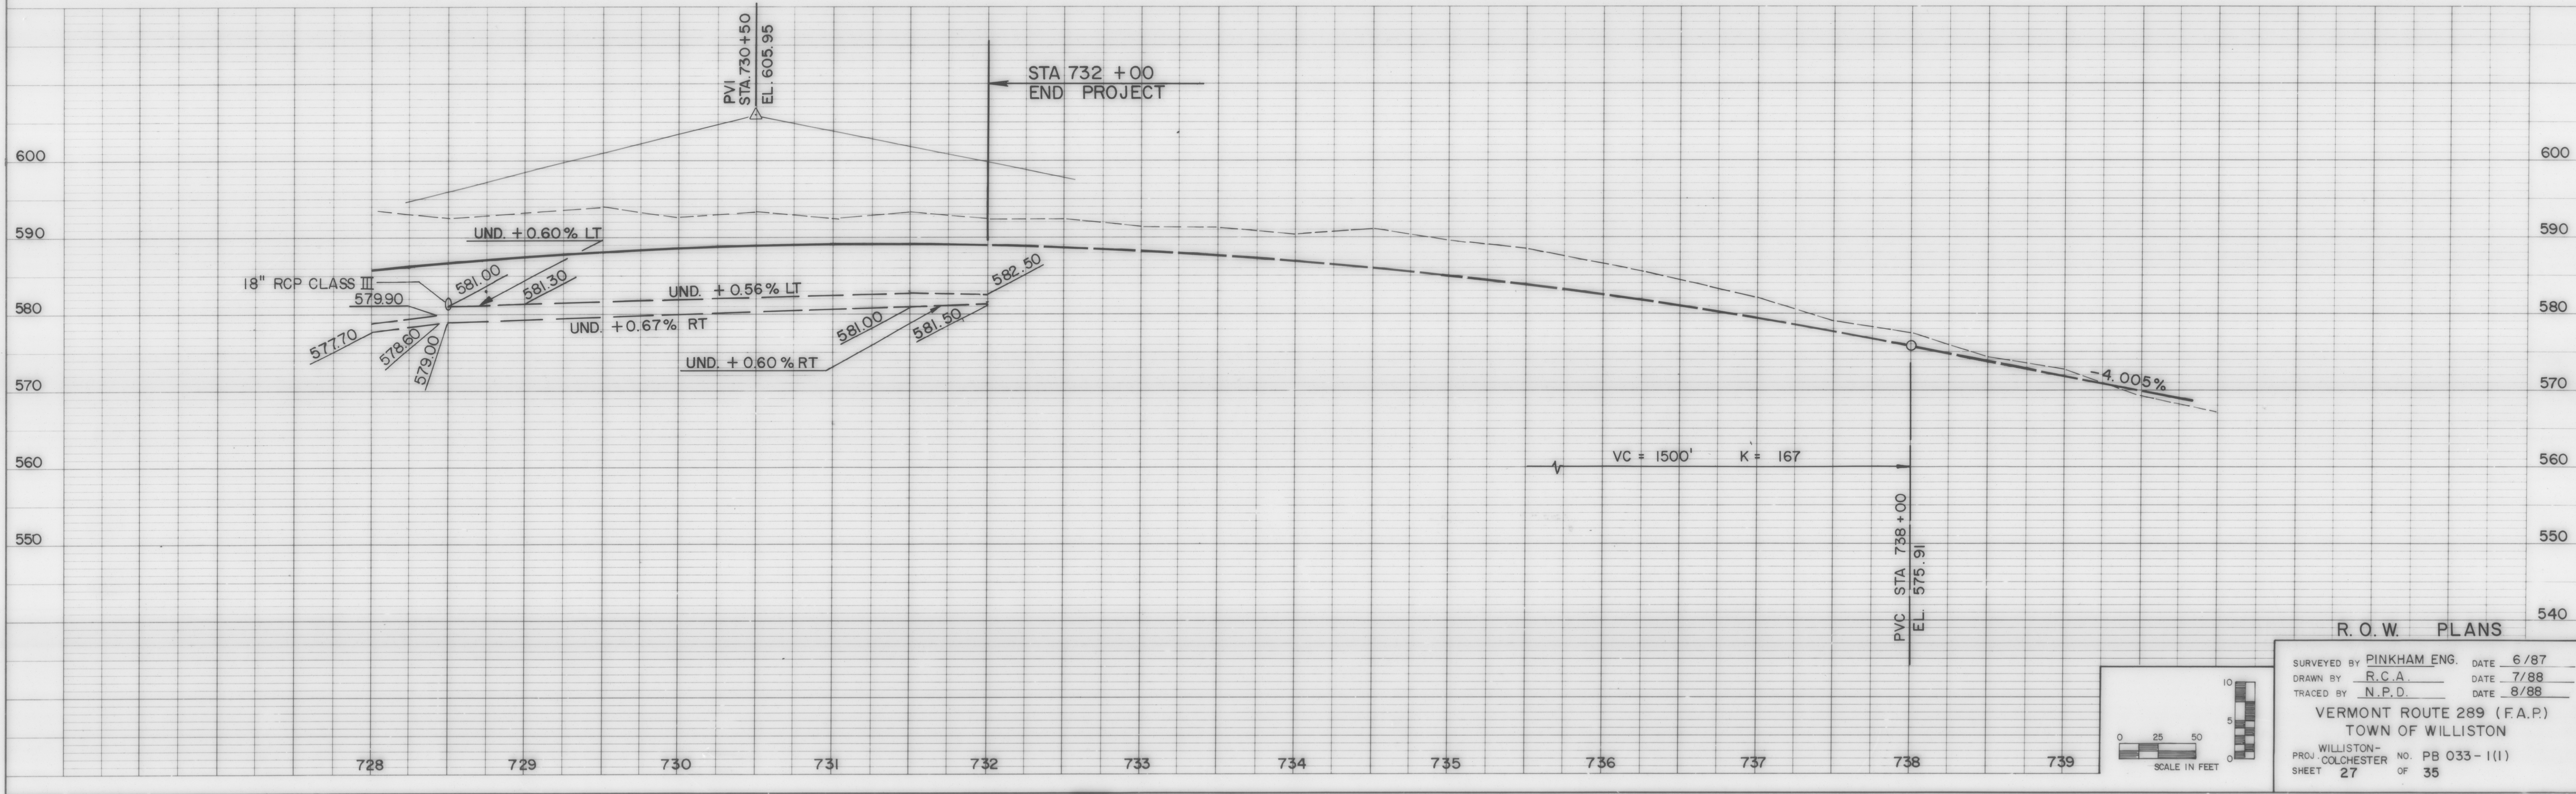

R. O. W. PLANS

SURVEYED BY PINKHAM ENG. DATE 6/87
 DRAWN BY R.C.A. DATE 7/88
 TRACED BY N.P.D. DATE 8/88

VERMONT ROUTE 289 (F.A.P.)
 TOWN OF WILLISTON

PROJ. WILLISTON-COLCHESTER NO. PB 033-1(1)
 SHEET 27 OF 35