


PROFILE
 SURVEYED BY _____ DATE _____
 PLOTTED BY _____
 NOTE BOOK NO. _____
 GRADES CHECKED BY _____
 B.M.'s NOTED BY _____
 STRUCTURE NOTATIONS CH'VD NO. _____



PROFILE
 SURVEYED BY _____ DATE _____
 PLOTTED BY _____
 NOTE BOOK NO. _____
 GRADES CHECKED BY _____
 B.M.'s NOTED BY _____
 STRUCTURE NOTATIONS CH'VD NO. _____

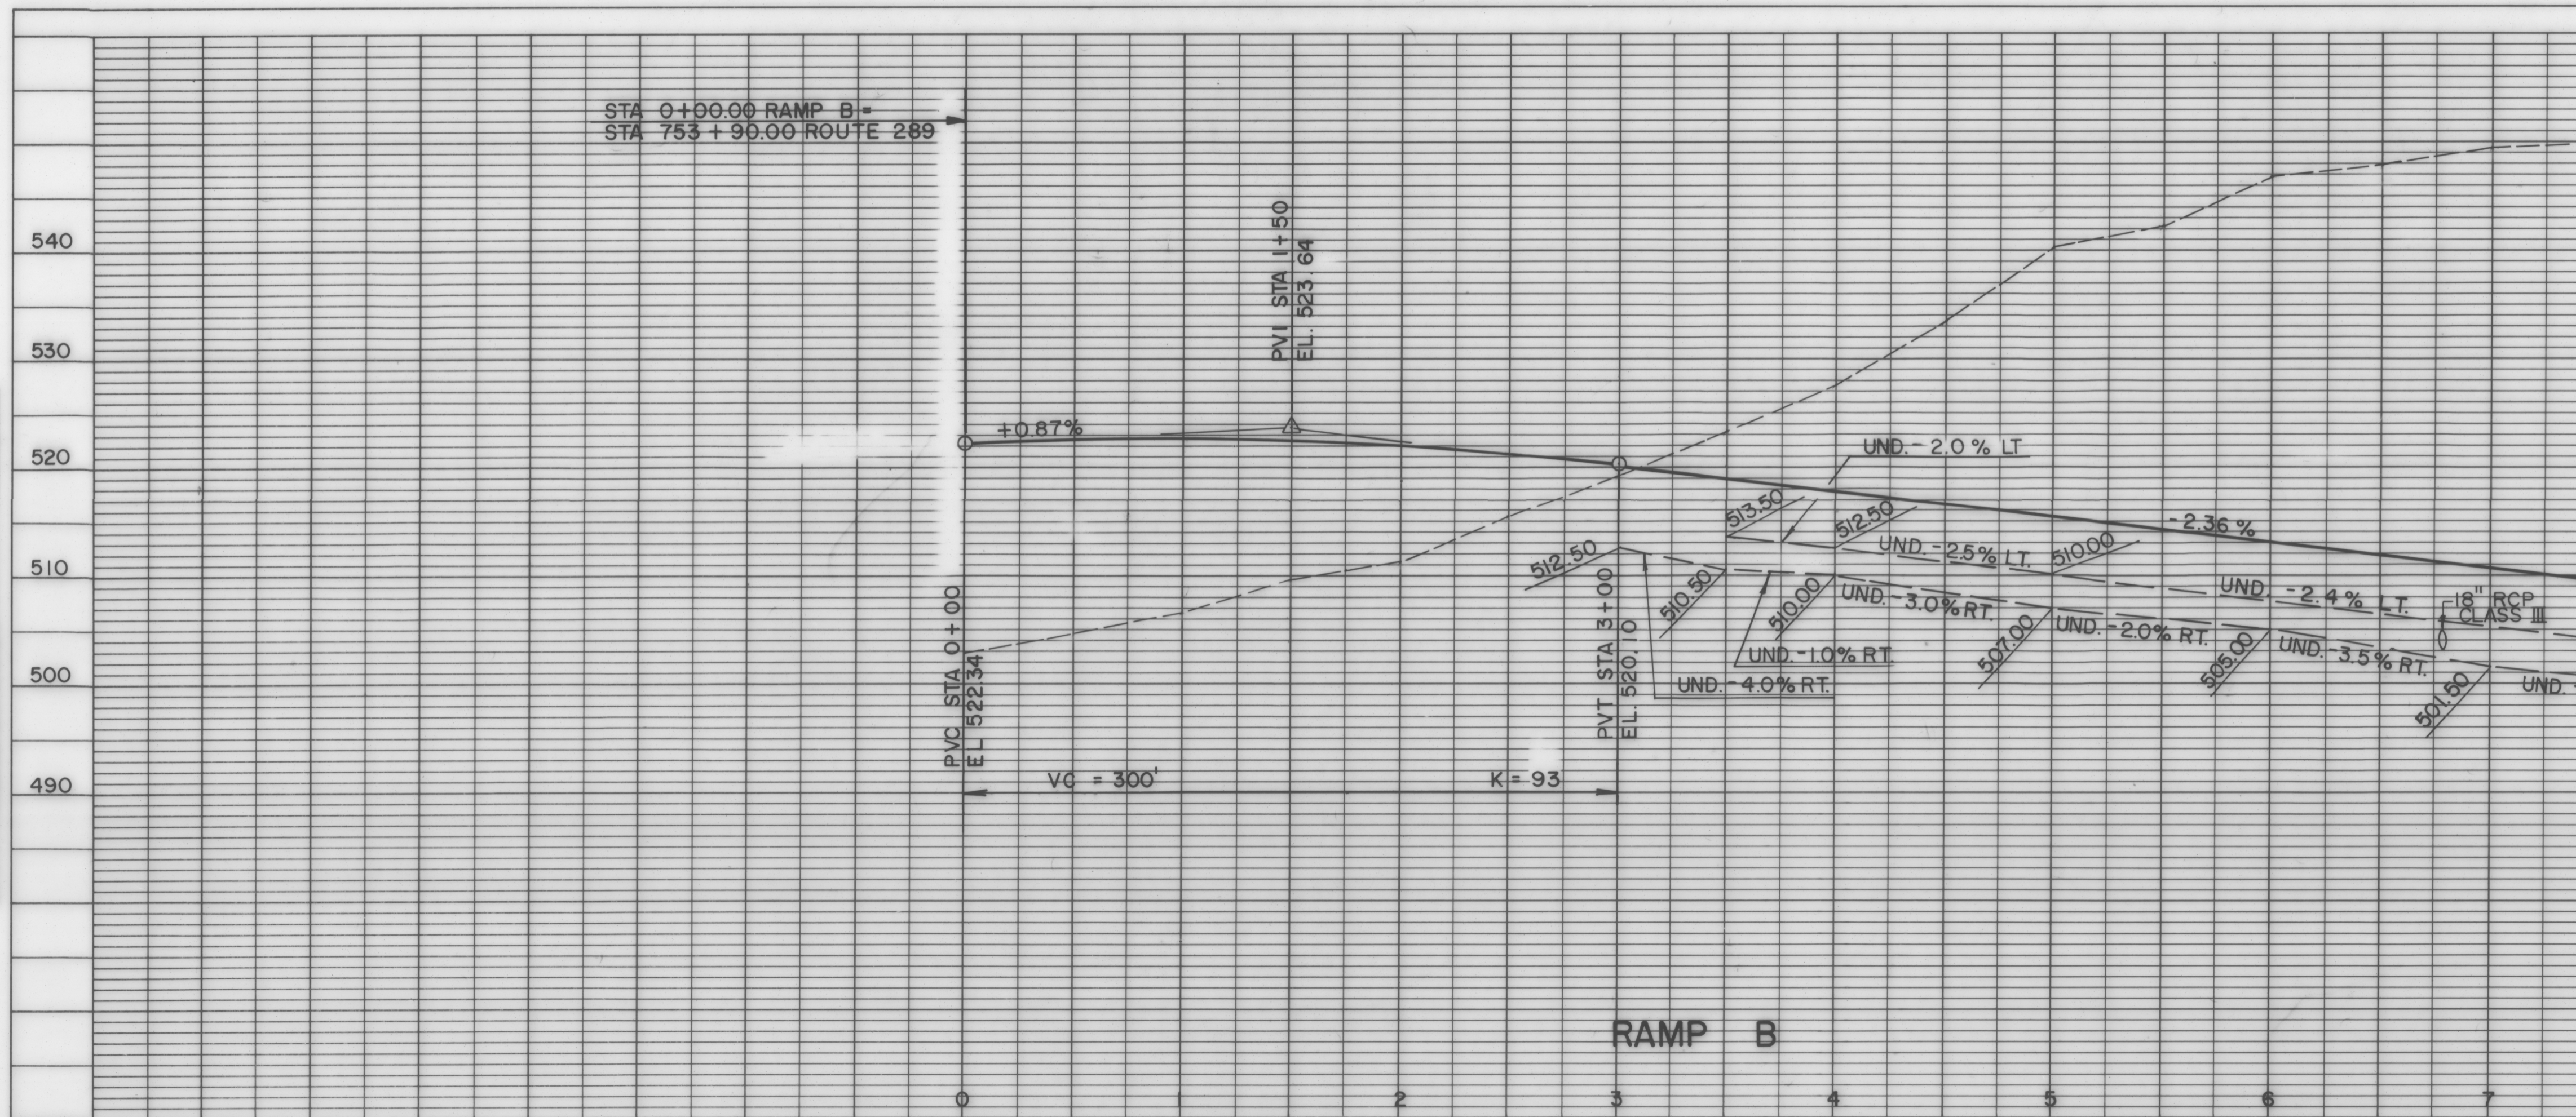