

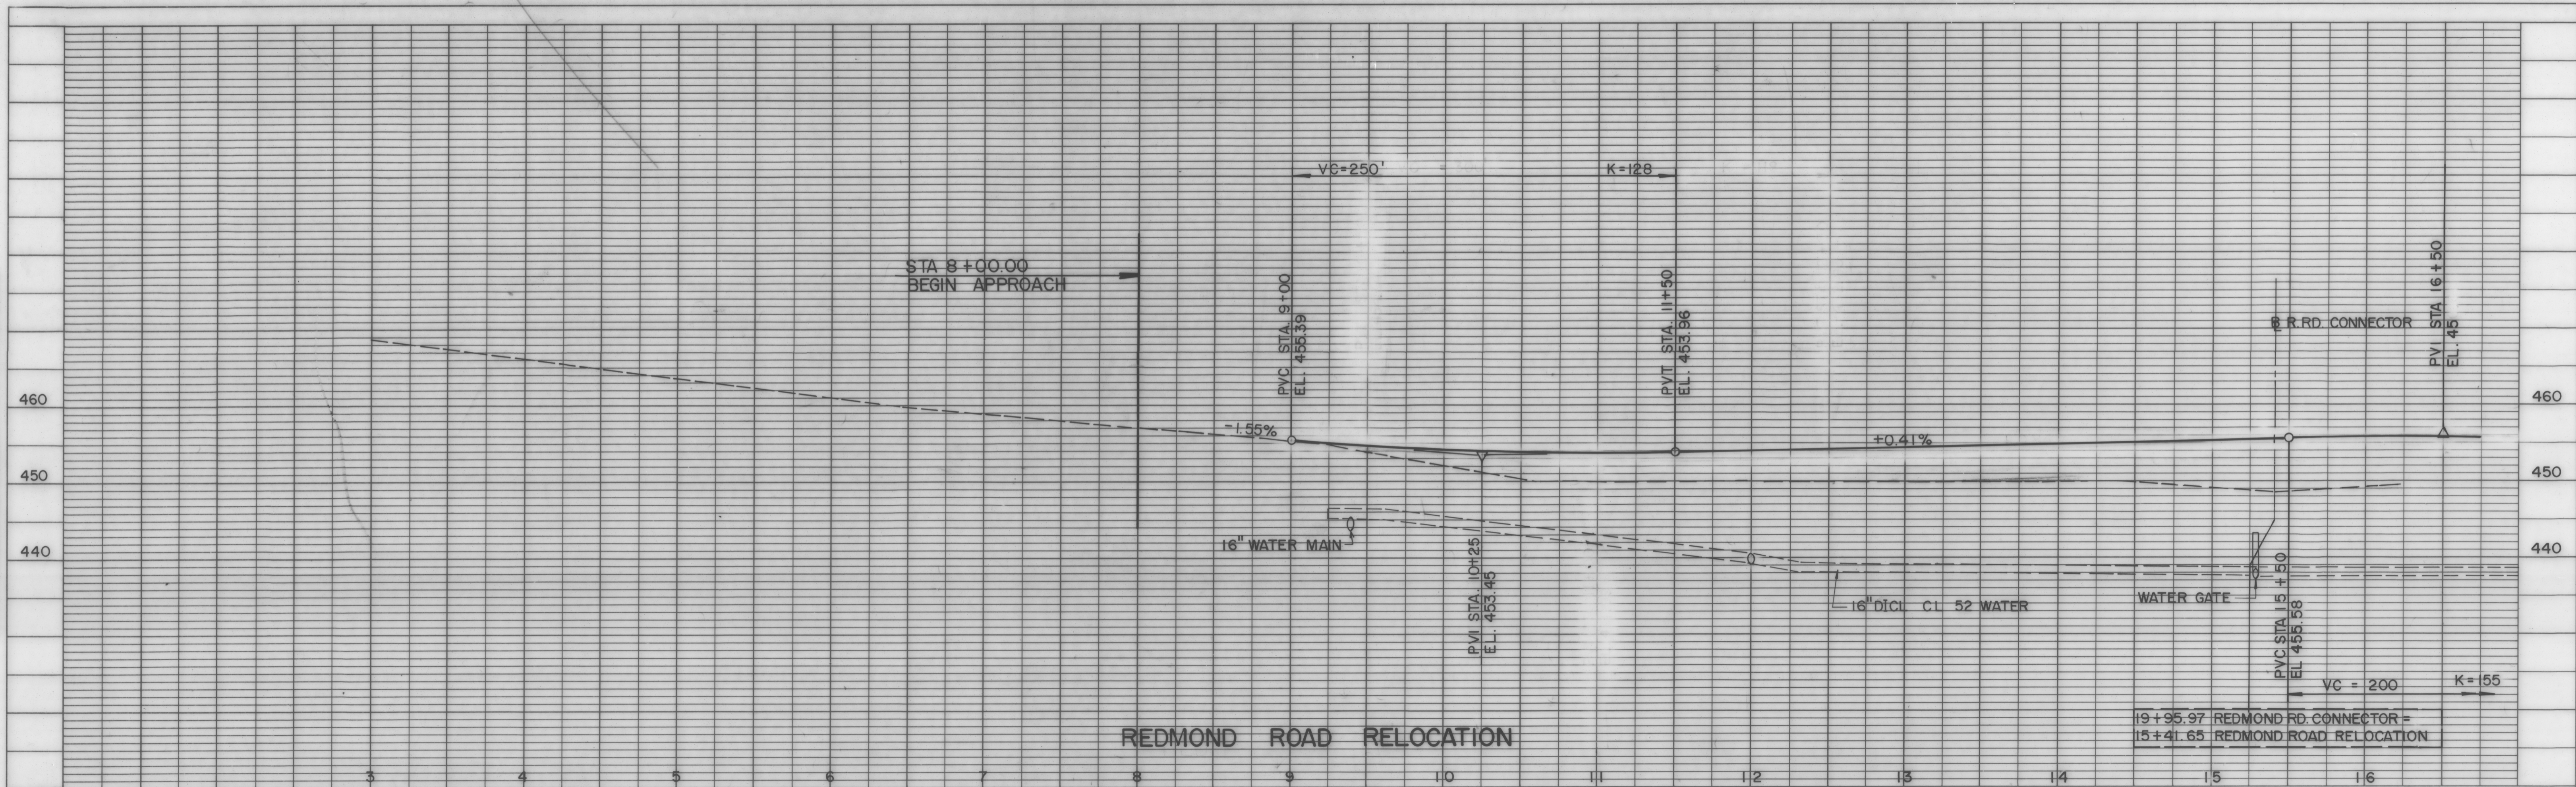


PROFILE SURVEYED BY DATE
 PLOTTED BY
 NOTE BOOK NO. _____
 RANGES CHECKED BY _____
 STRUCTURE NOTATIONS CH'VD

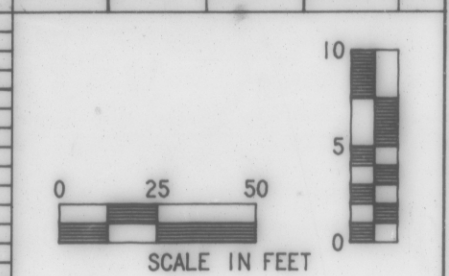

PROFILE SURVEYED BY DATE
 PLOTTED BY
 NOTE BOOK NO. _____
 RANGES CHECKED BY _____
 STRUCTURE NOTATIONS CH'VD

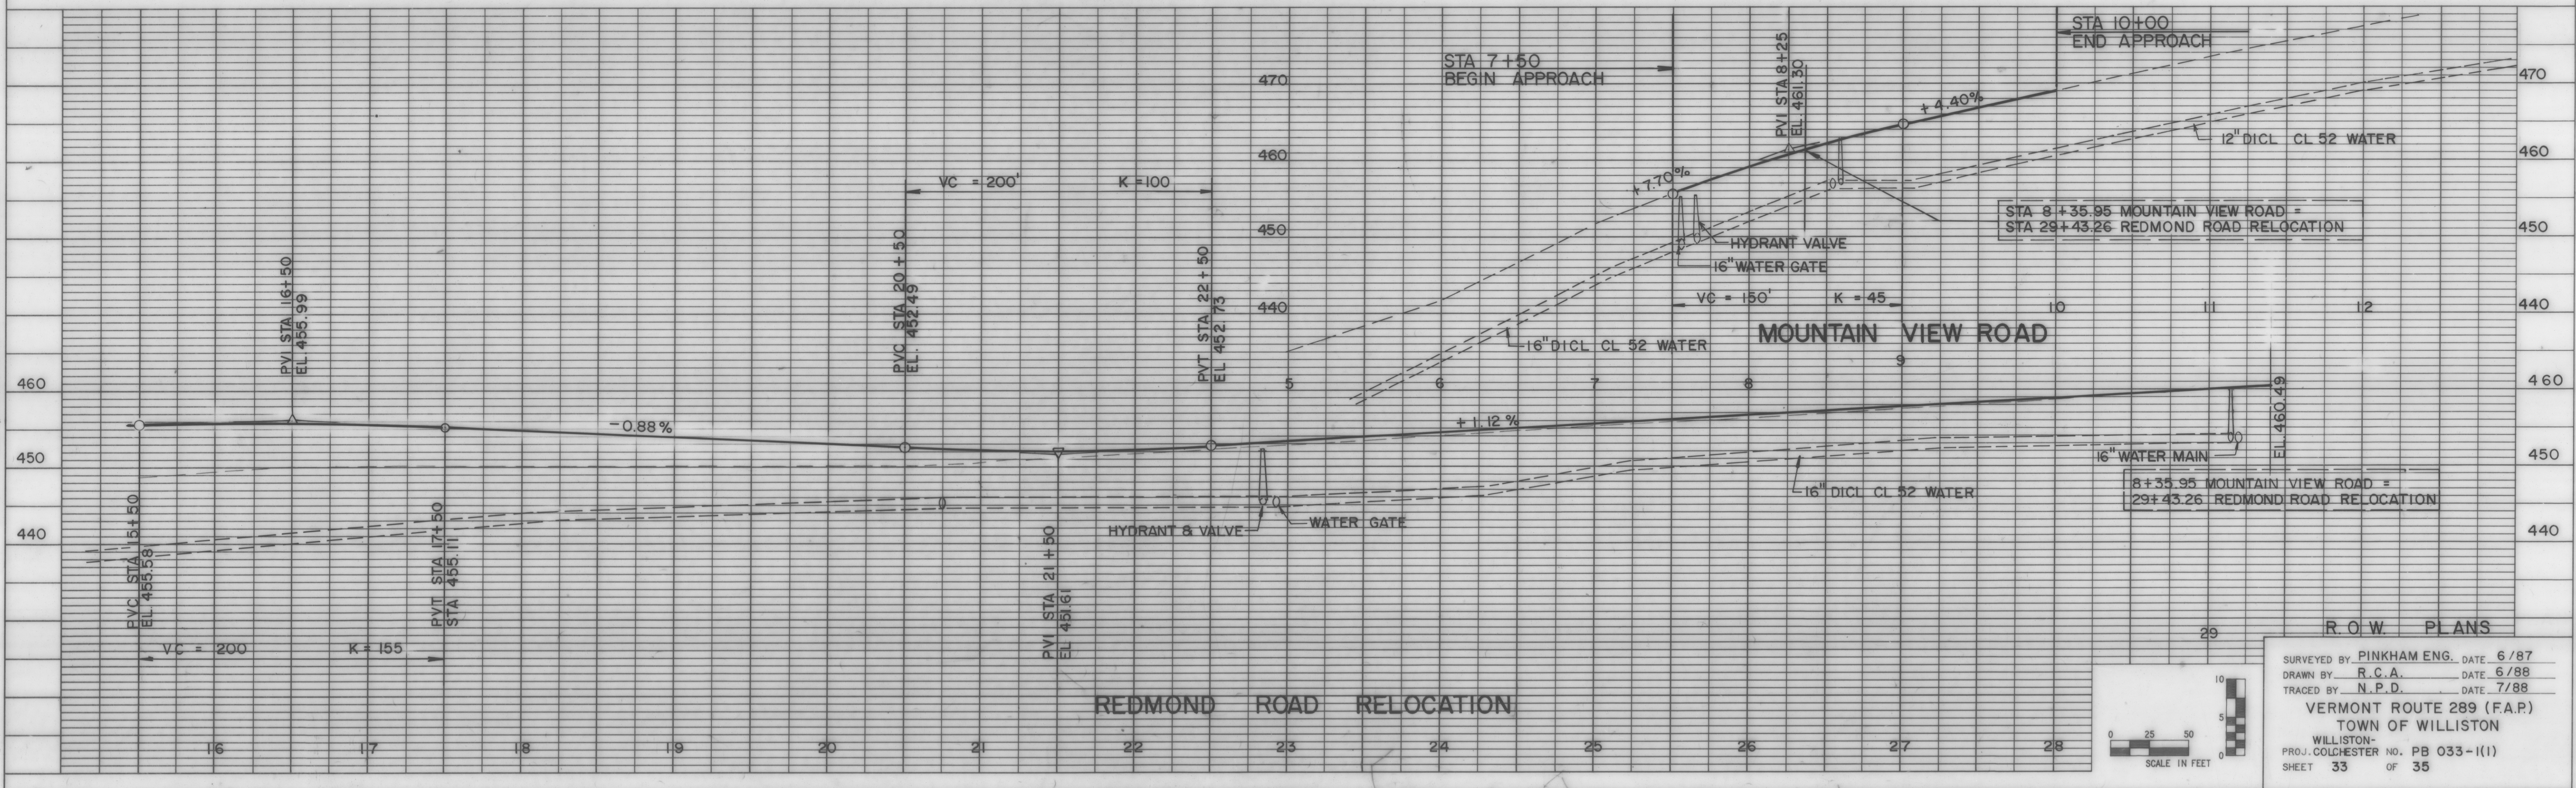

R.O.W. PLANS

SURVEYED BY PINKHAM ENG. DATE 6/87
 DRAWN BY R.C.A. DATE 6/88
 TRACED BY N.P.D. DATE 7/88

**VERMONT ROUTE 289 (F.A.P.)
 TOWN OF WILLISTON**

WILLISTON-
 PROJ. COLCHESTER NO. PB 033-(11)
 SHEET 33 OF 35