



PROFILE SURVEYED BY DATE
 NOTE BOOK GRADES CHECKED
 NO. B.M.'s NOTED
 STRUCTURE NOTATION'S CH'VD

PROFILE SURVEYED BY DATE
 NOTE BOOK GRADES CHECKED
 NO. B.M.'s NOTED
 STRUCTURE NOTATION'S CH'VD

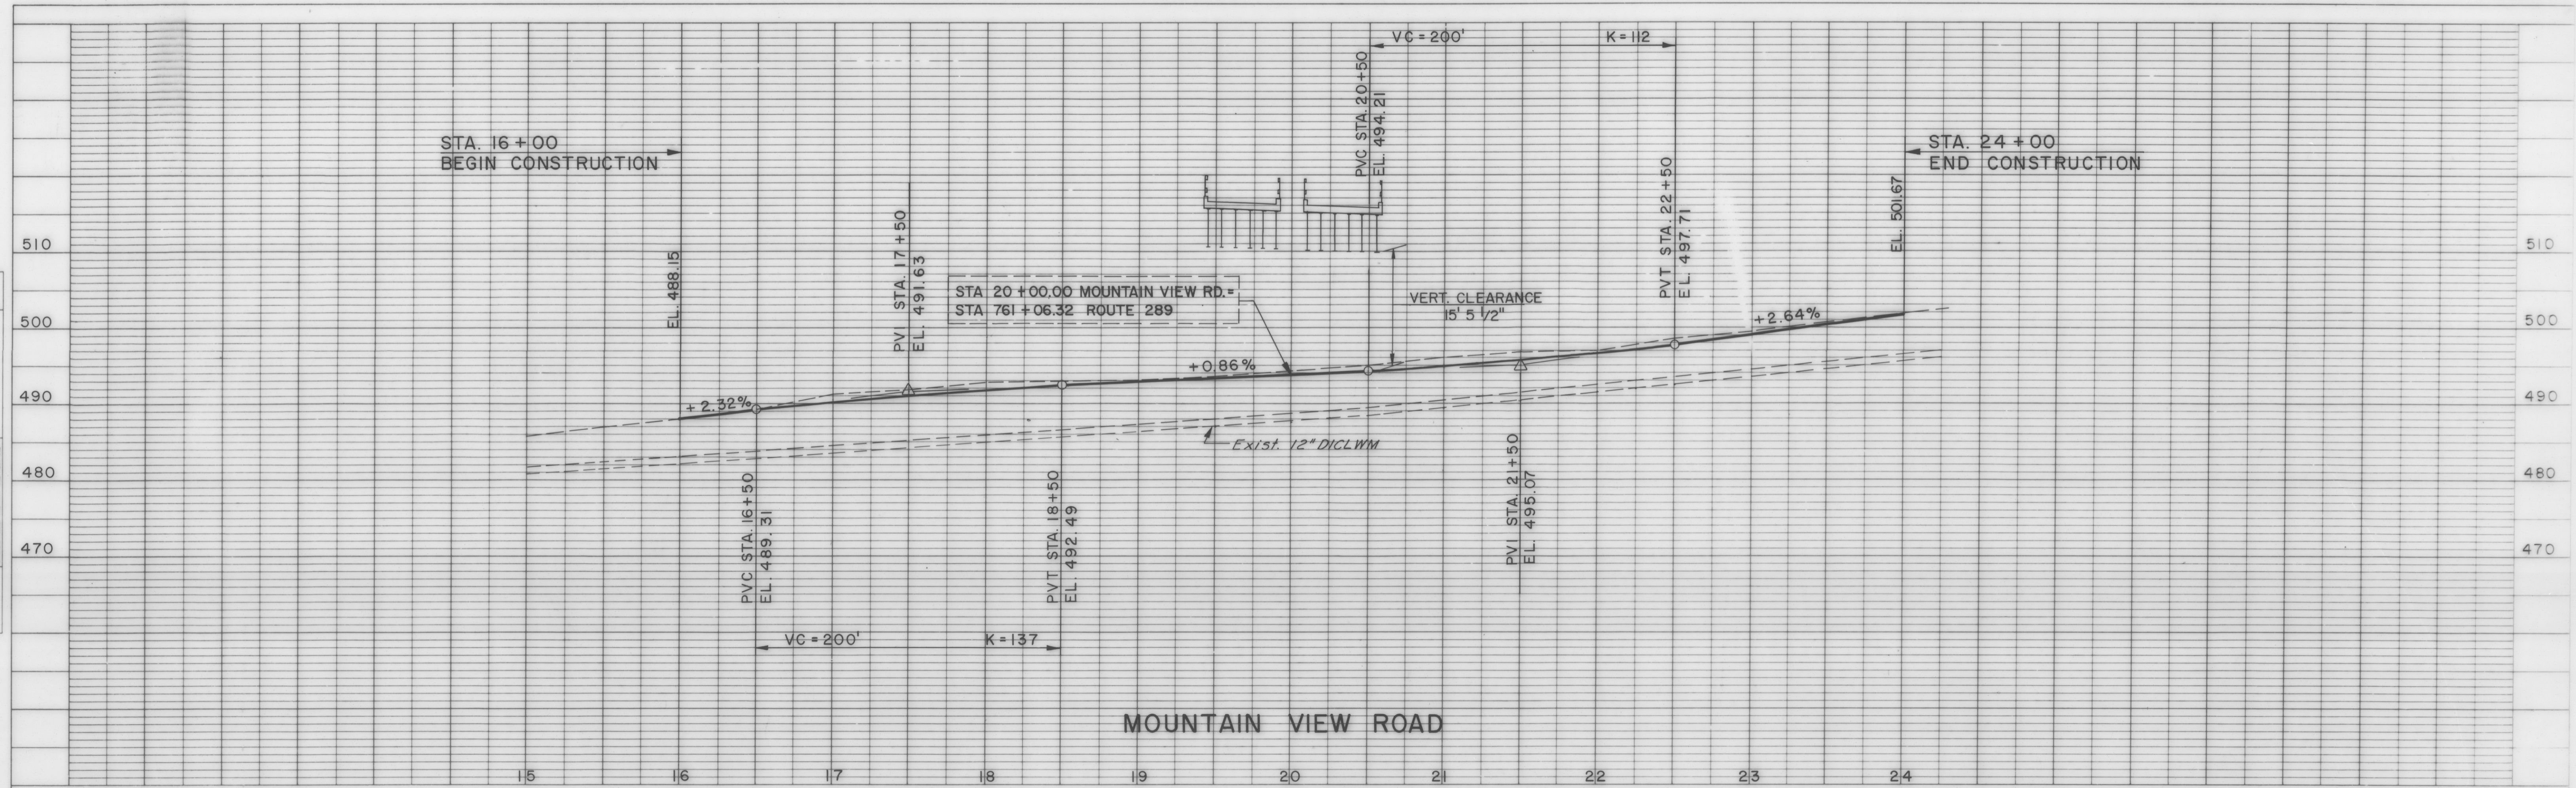

15539
 MAKEPEACE

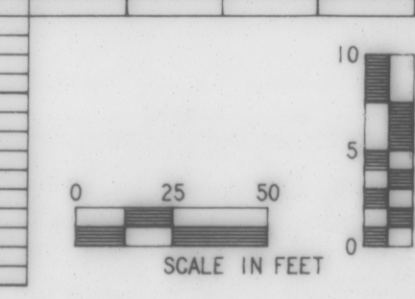

R.O.W. PLANS
 SURVEYED BY PINKHAM ENG. DATE 6/87
 DRAWN BY M.M.N. DATE 8/88
 TRACED BY E.I.D. DATE 9/88
 VERMONT ROUTE 289 (F.A.P.)
 TOWN OF WILLISTON
 PROJ. WILLISTON NO. PB 033-1(1)
 SHEET 34 OF 35