



TYPICAL SECTIONS

3" BITUMINOUS CONCRETE PAVEMENT - 1 1/4" TYPE III WEARING COURSE, 1 3/4" TYPE II BINDING COURSE
 3" BITUMINOUS CONCRETE PAVEMENT, TYPE I - BASE COURSE 1-3" COURSE
 36" SUBBASE OF DENSE GRADED CRUSHED STONE
 SHOULDERS 1 1/4" BITUMINOUS CONCRETE PAVEMENT EXCEPT WHERE FULL DEPTH OF PAVEMENT IS NOTED
 12" SAND BORROW

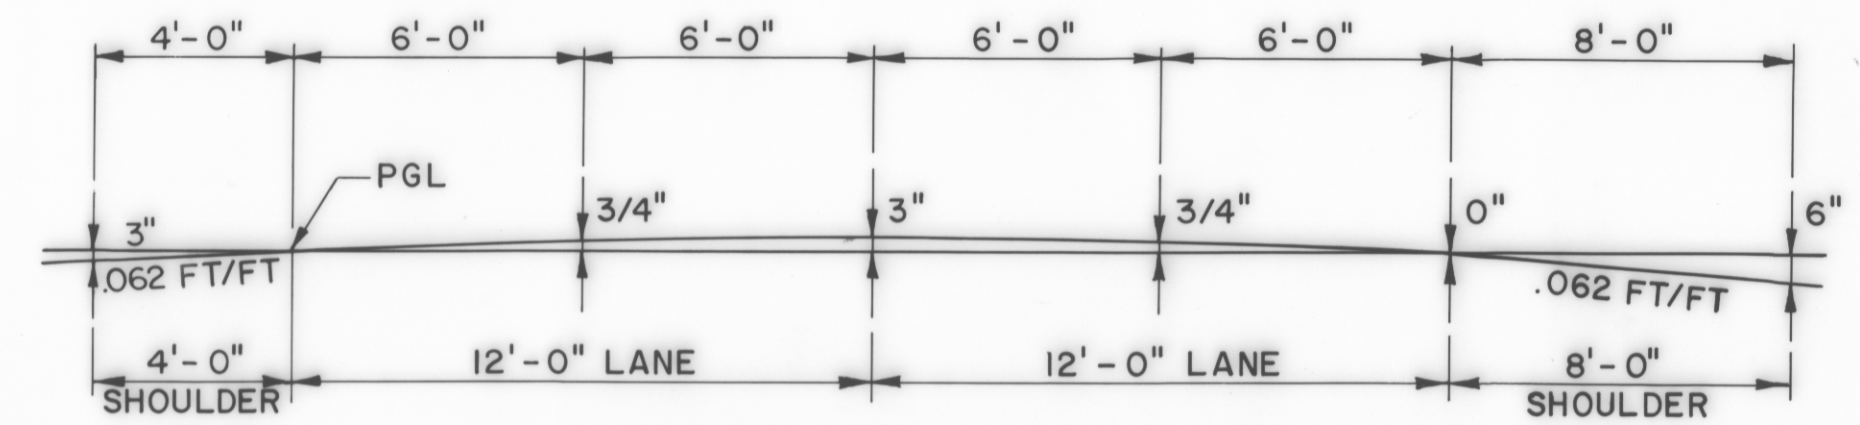

CROSS-SLOPE & PARABOLIC DETAIL

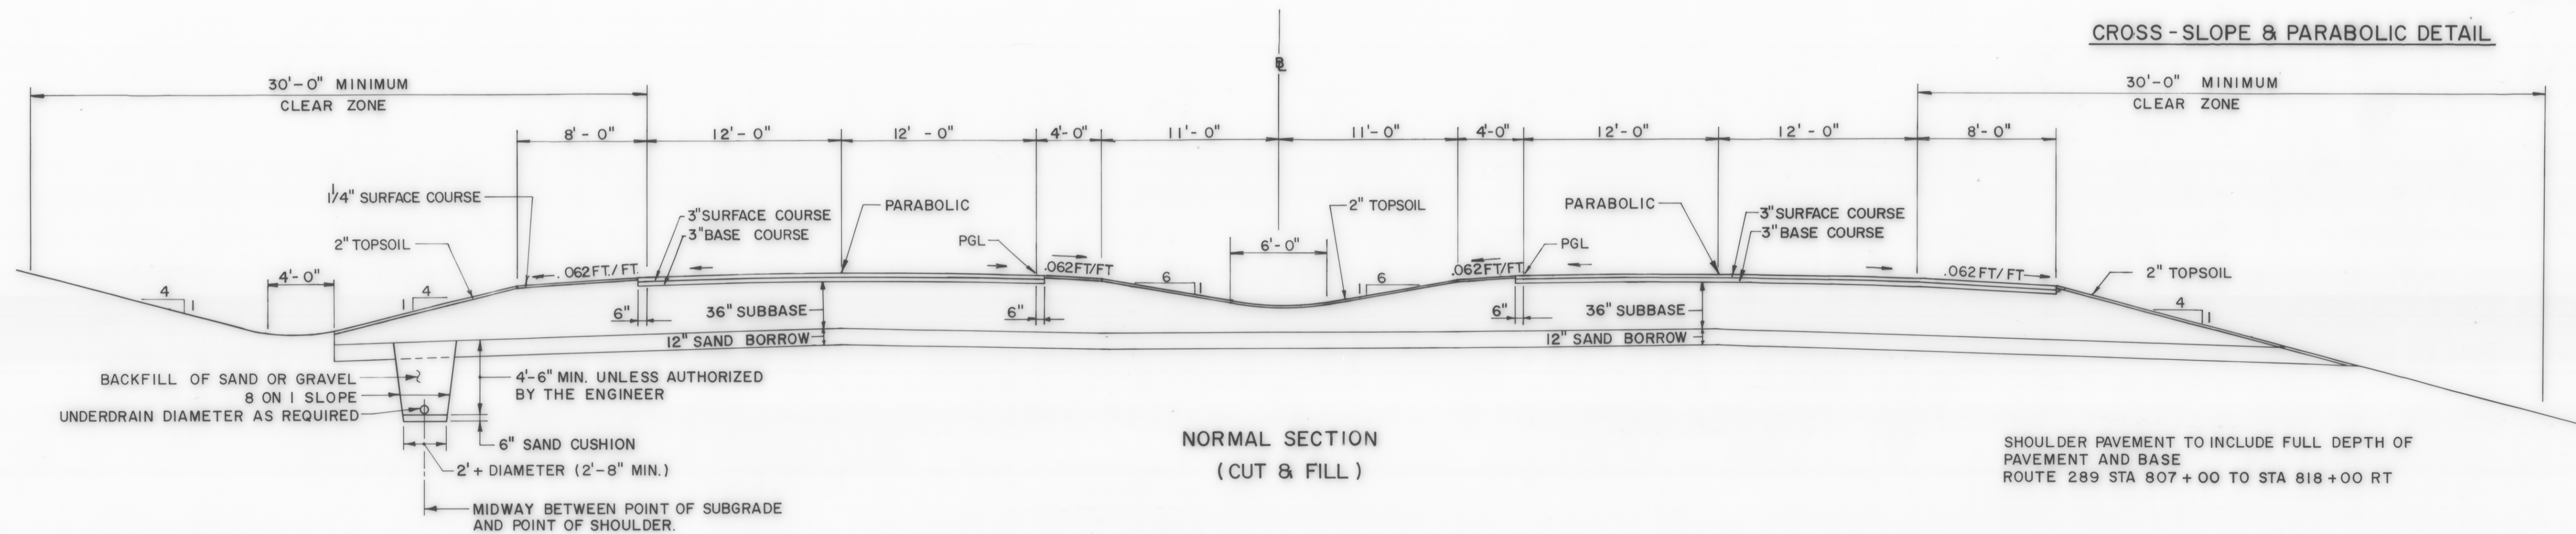


NORMAL SECTION
(CUT & FILL)


SHOULDER PAVEMENT TO INCLUDE FULL DEPTH OF PAVEMENT AND BASE
 ROUTE 289 STA 807+00 TO STA 818+00 RT

NOTE:
 UNDERDRAIN SHOULD BE PROVIDED WHERE THE SAND BORROW IS IN A BOX CUT, OR AS DIRECTED BY THE ENGINEER.

NOTE:
 WHEN EXISTING SUBGRADE MATERIAL IN A CUT MEETS OR EXCEEDS THE REQUIREMENTS FOR SAND BORROW, THE EXISTING MATERIAL SHALL REMAIN AND THE SAND BORROW SHALL BE ELIMINATED IN THAT AREA.

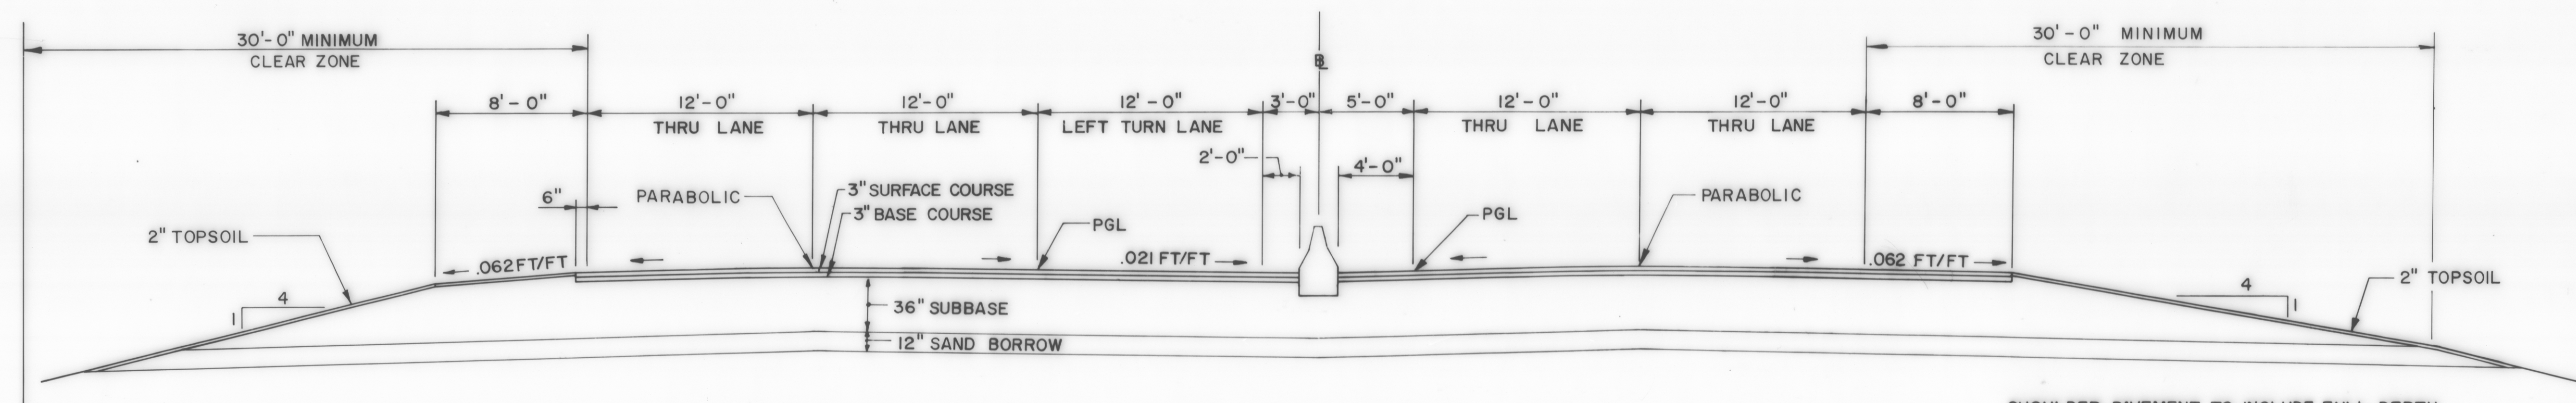

SHOULDER PAVEMENT TO INCLUDE FULL DEPTH OF PAVEMENT AND BASE
 ROUTE 289 STA 818+00 TO STA 829+00 RT

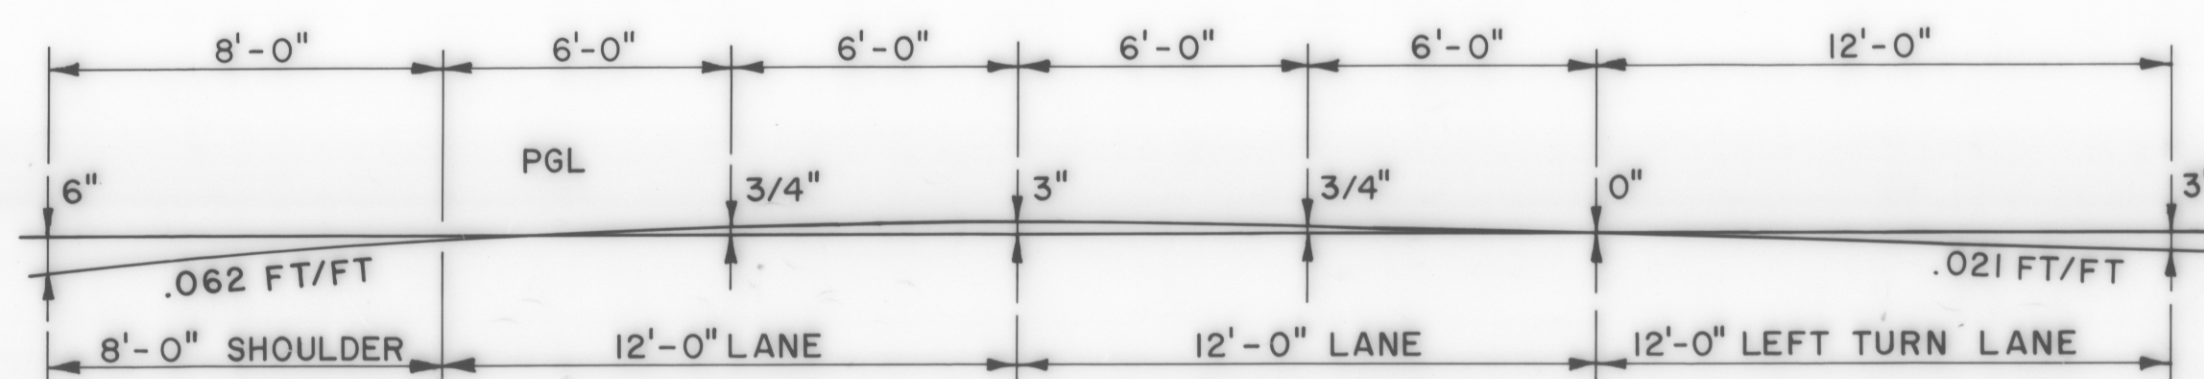

CROSS-SLOPE & PARABOLIC DETAIL

NORMAL SECTION

DATUM
 VERTICAL _____
 HORIZONTAL _____

R.O.W. PLANS

SURVEYED BY PINKHAM ENG. DATE 7-87
 DRAWN BY R.C.A. DATE 11-87
 TRACED BY N.P.D. DATE 11-87
 VERMONT ROUTE 289 (F.A.P.)
 TOWN OF WILLISTON
 PROJ. WILLISTON NO. PB 033-1(1)
 COLCHESTER
 SHEET 3 OF 26