



DATE: _____
 BY: _____
 PLAN NO. _____
 REVISIONS:
 1. _____
 2. _____
 3. _____
 4. _____
 5. _____

DATE: _____
 BY: _____
 PROFILE NO. _____
 REVISIONS:
 1. _____
 2. _____
 3. _____
 4. _____
 5. _____

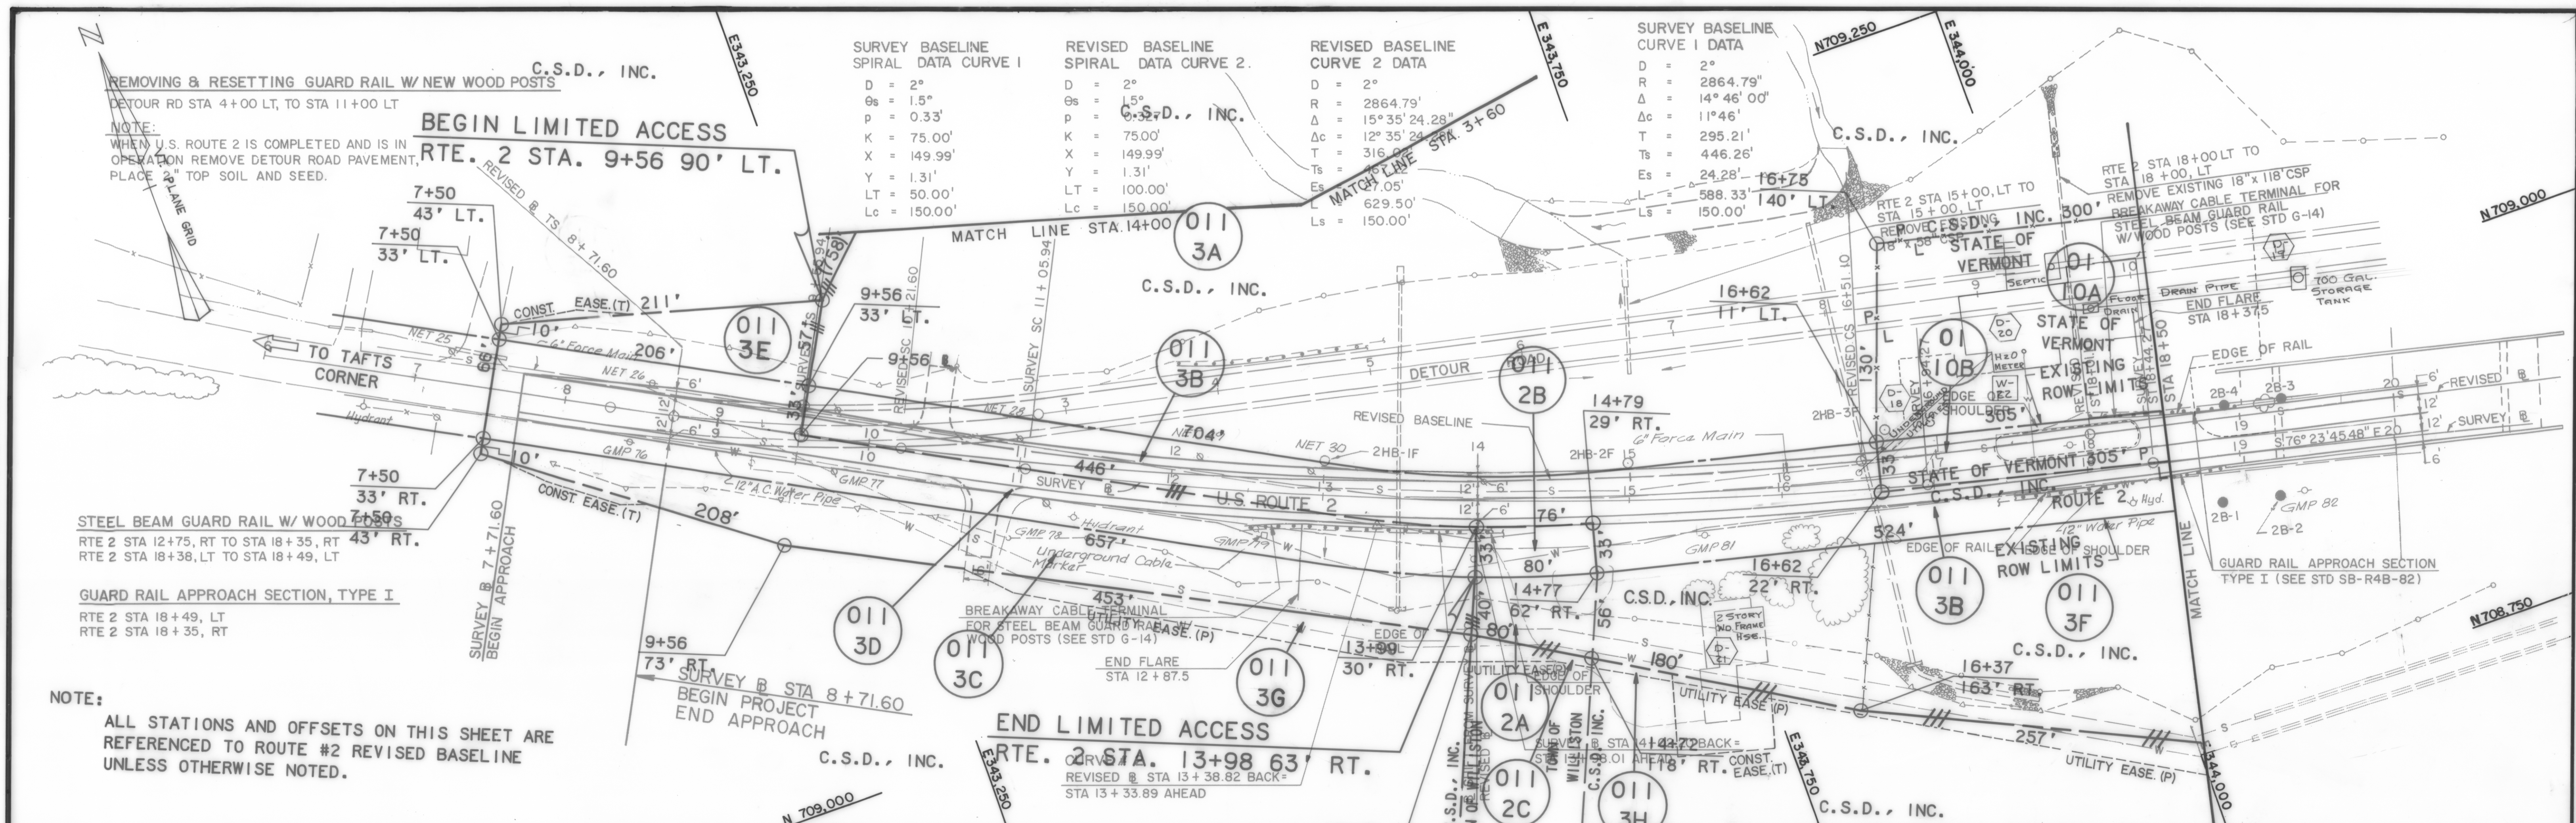

NOTE:
 ALL STATIONS AND OFFSETS ON THIS SHEET ARE REFERENCED TO ROUTE #2 REVISED BASELINE UNLESS OTHERWISE NOTED.

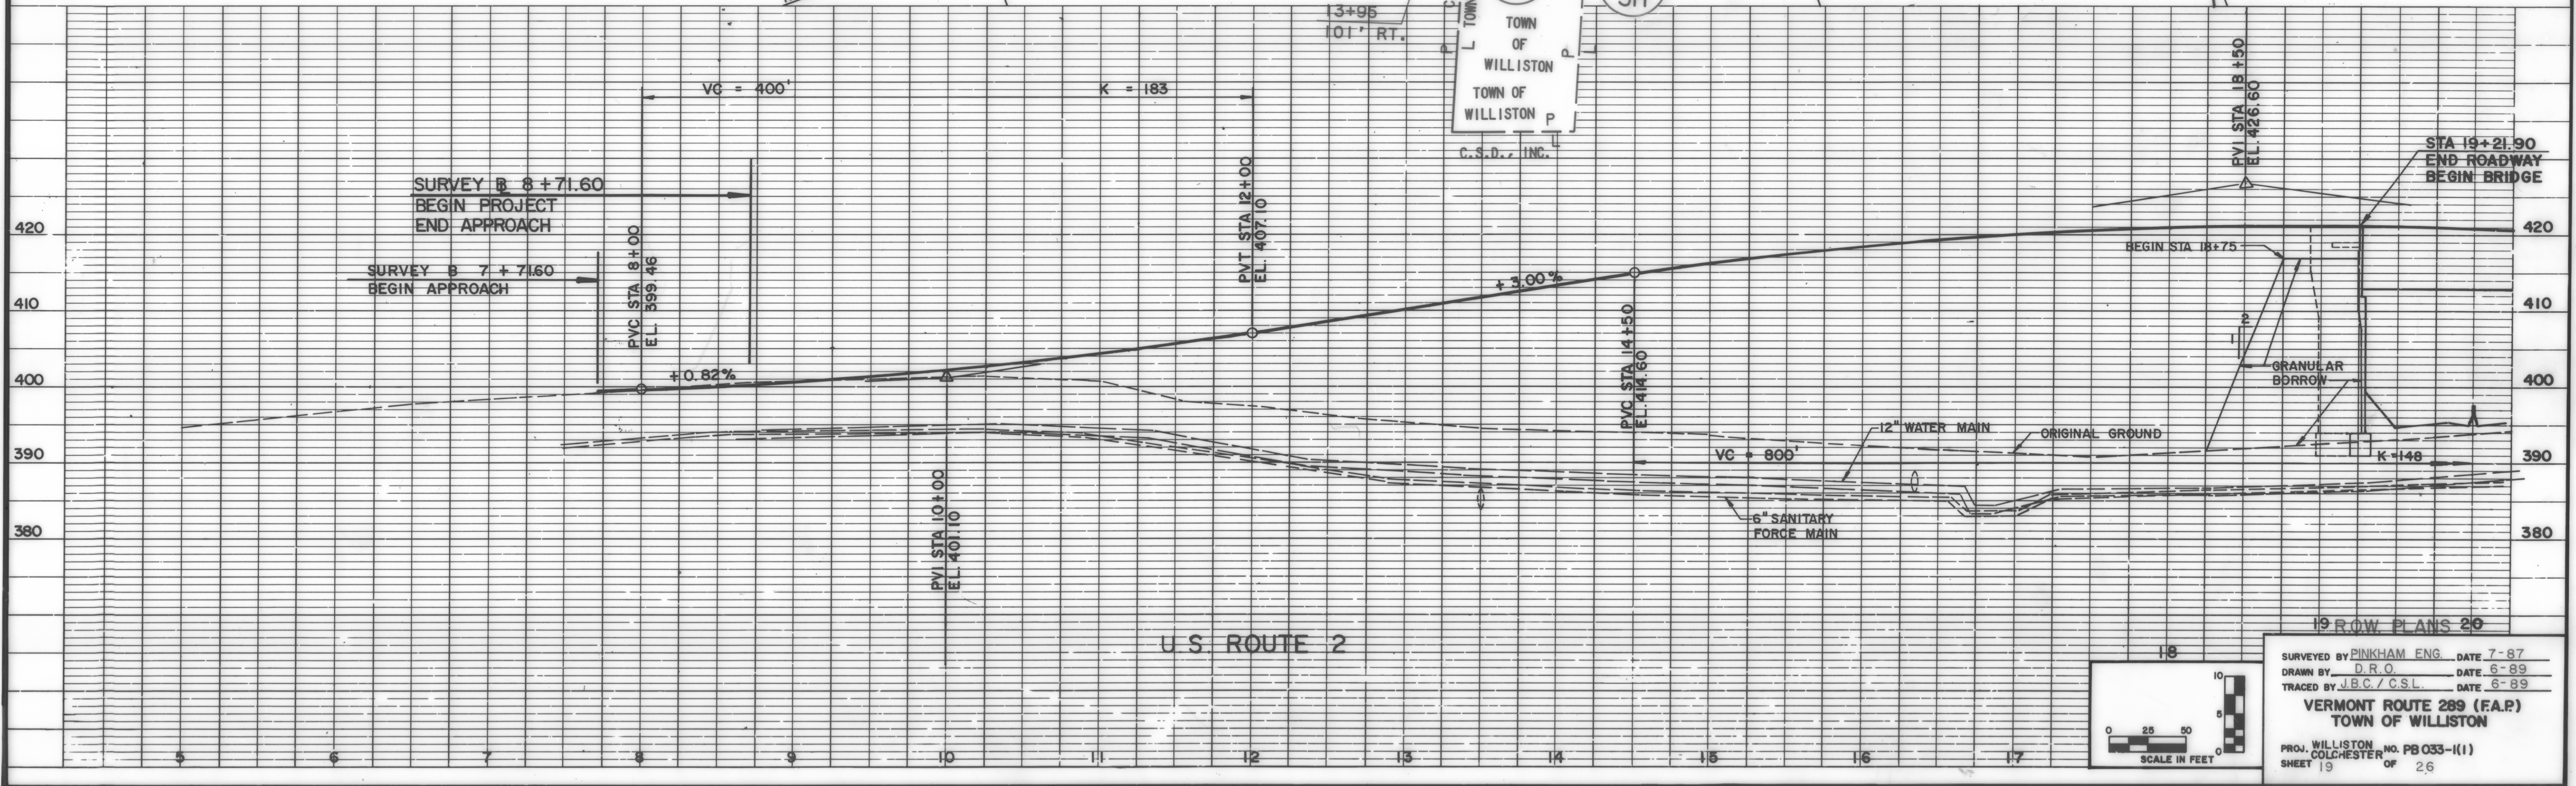

19 ROW PLANS 20
 SURVEYED BY PINKHAM ENG. DATE 7-87
 DRAWN BY D.R.O. DATE 6-89
 TRACED BY J.B.C./C.S.L. DATE 6-89
VERMONT ROUTE 289 (F.A.P.)
TOWN OF WILLISTON
 PROJ. WILLISTON NO. PB 033-1(1)
 SHEET 19 OF 26