



PROFILE SURVEYED BY DATE  
 PLOTTED BY  
 NOTE BOOK GRADES CHECKED  
 NO. STRUCTURE NOTATIONS CH'VD

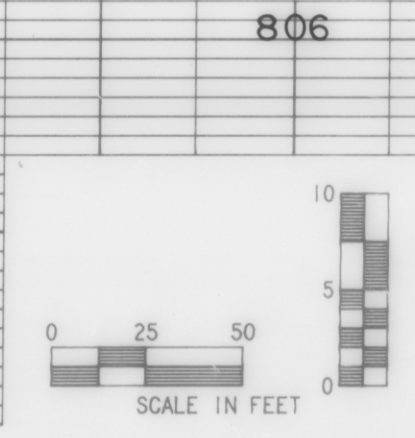

PROFILE SURVEYED BY DATE  
 PLOTTED BY  
 NOTE BOOK GRADES CHECKED  
 NO. STRUCTURE NOTATIONS CH'VD

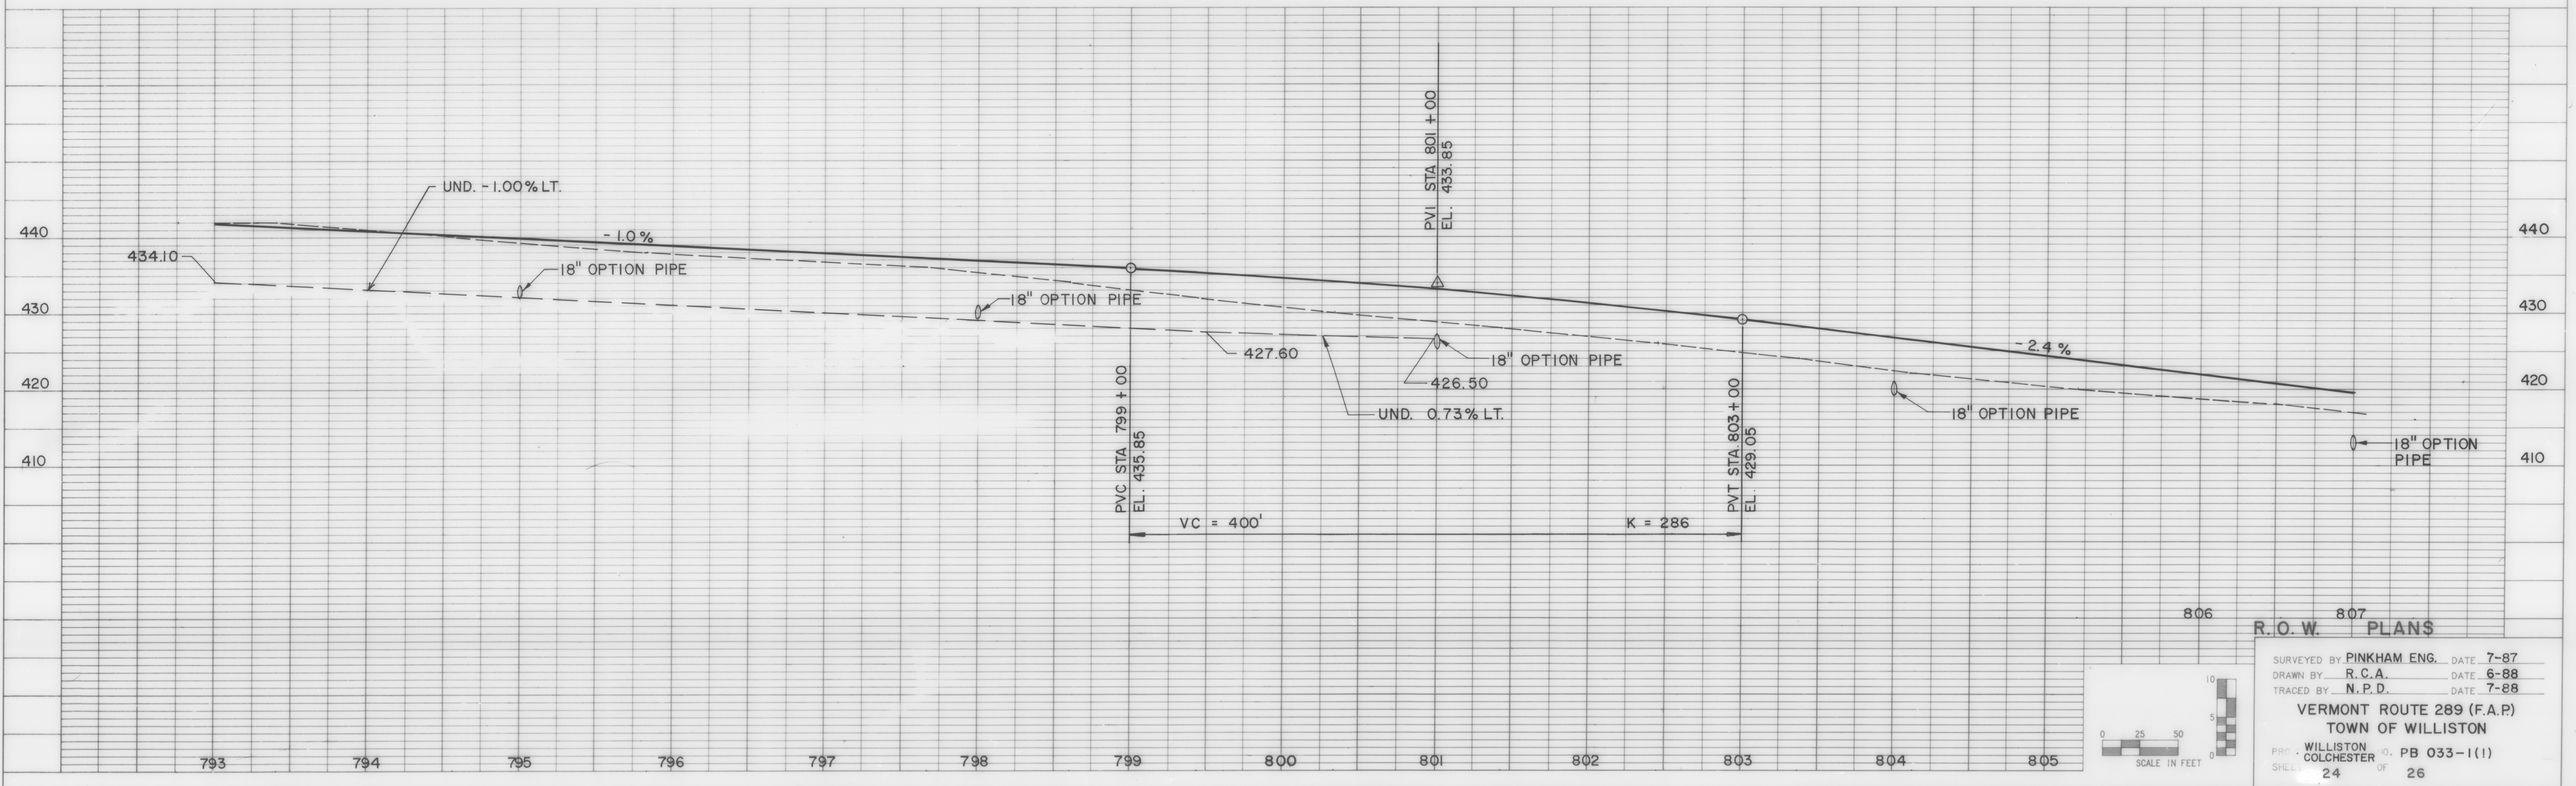

R.O.W. PLANS

SURVEYED BY PINKHAM ENG. DATE 7-87  
 DRAWN BY R.C.A. DATE 6-88  
 TRACED BY N.P.D. DATE 7-88

VERMONT ROUTE 289 (F.A.P.)  
 TOWN OF WILLISTON

PROJ. WILLISTON COLCHESTER CO. PB 033-1(1)  
 SHEET 24 OF 26