


PROFILE SURVEYED BY \_\_\_\_\_ DATE \_\_\_\_\_  
 PLOTTED BY \_\_\_\_\_  
 NOTE BOOK NO. \_\_\_\_\_ GRADES CHECKED BY \_\_\_\_\_  
 NO. \_\_\_\_\_ STRUCTURE NOTATIONS CH'VD



PROFILE SURVEYED BY \_\_\_\_\_ DATE \_\_\_\_\_  
 PLOTTED BY \_\_\_\_\_  
 NOTE BOOK NO. \_\_\_\_\_ GRADES CHECKED BY \_\_\_\_\_  
 NO. \_\_\_\_\_ STRUCTURE NOTATIONS CH'VD

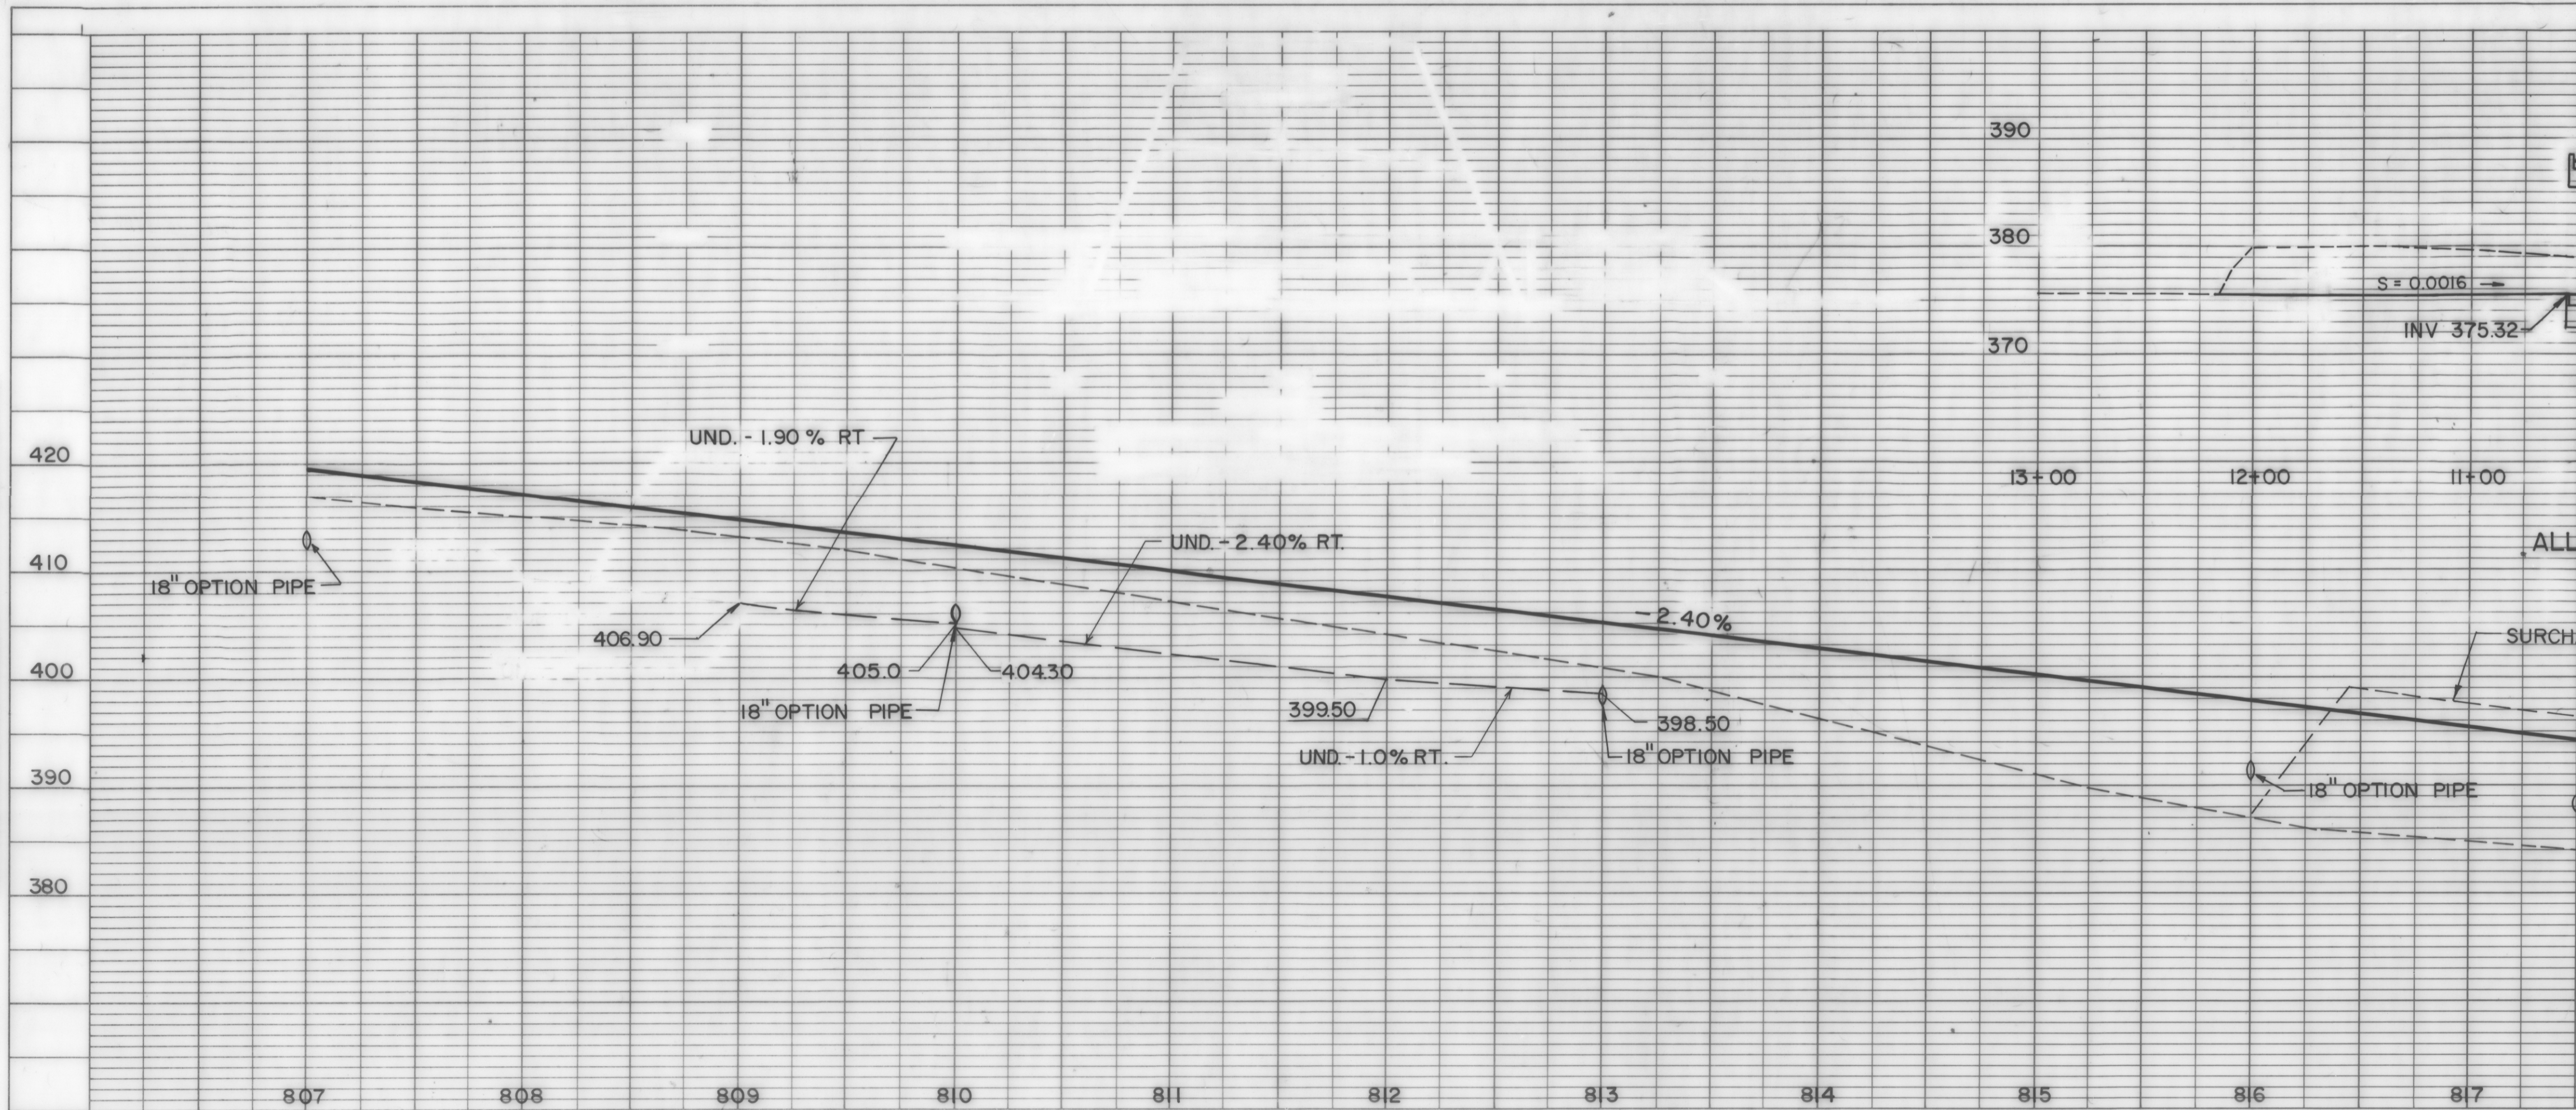