
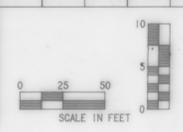
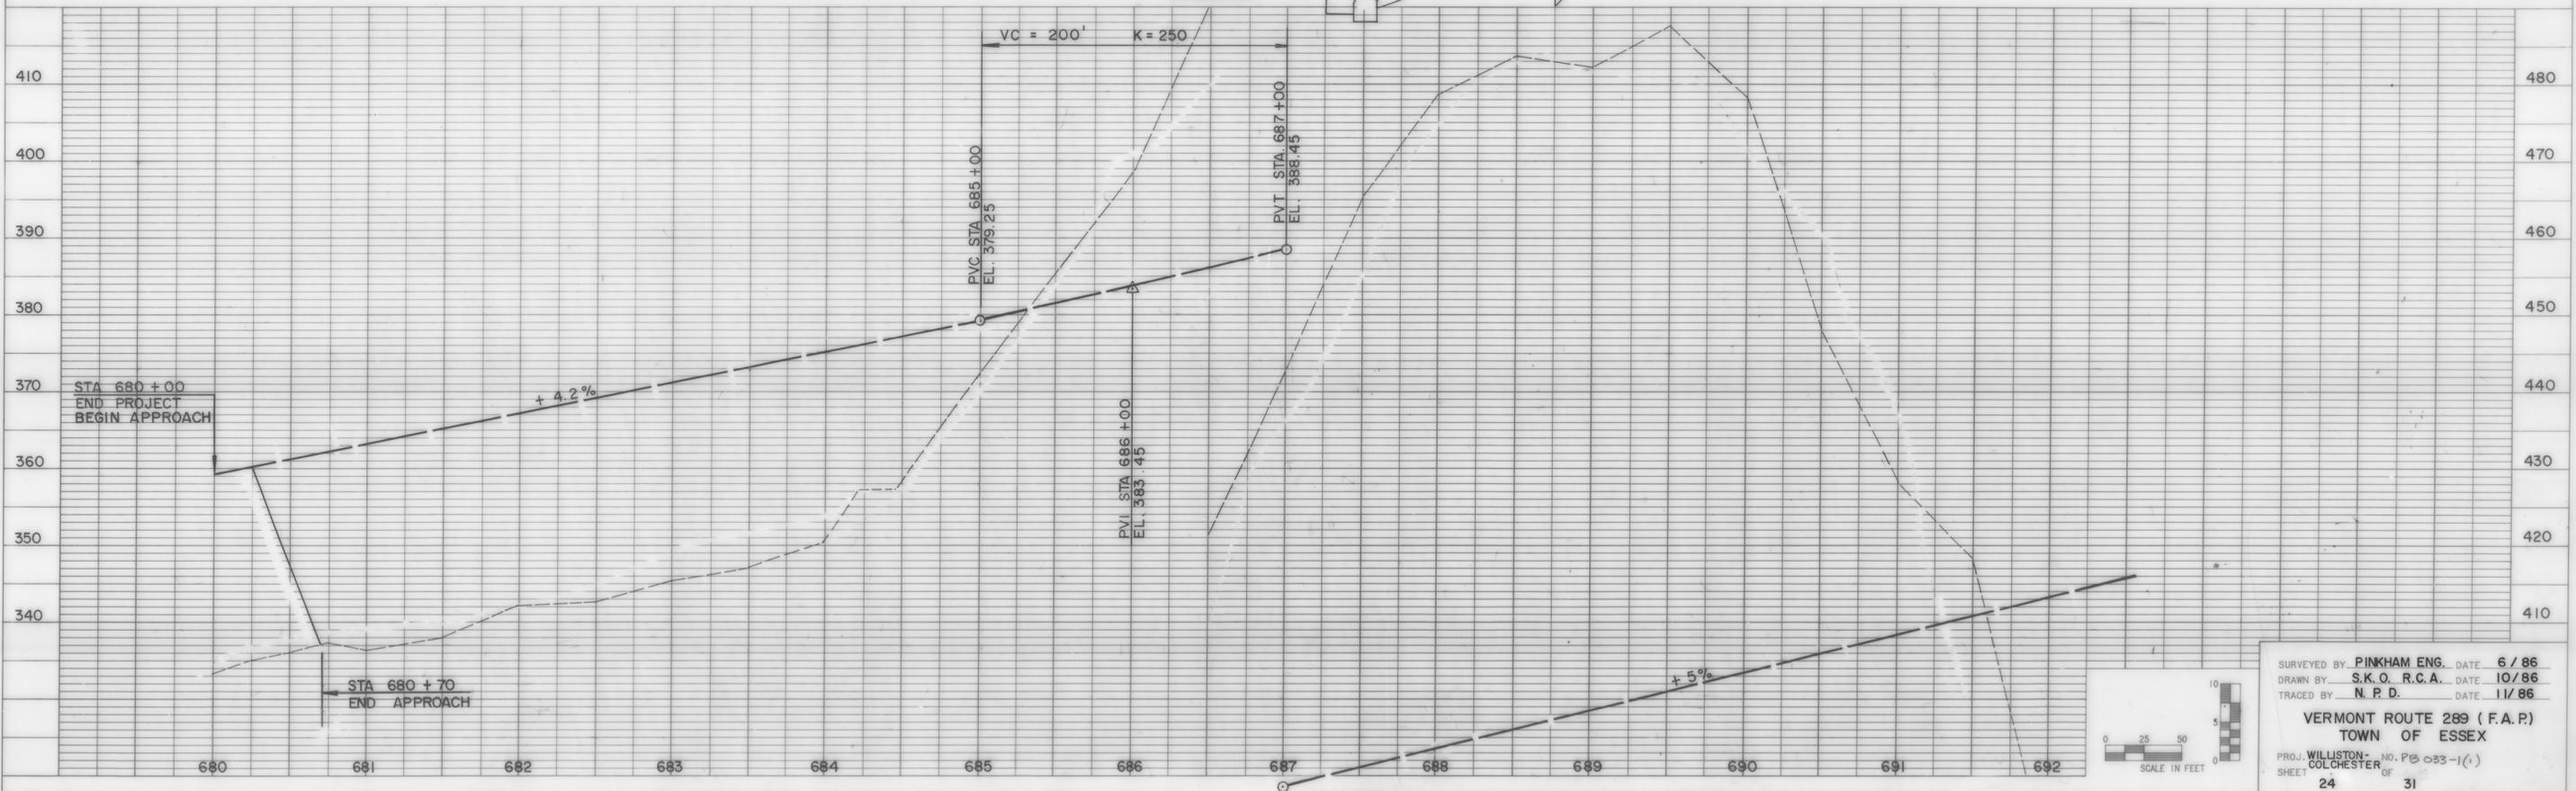


PROFILE SURVEYED BY DATE
 PLOTTED BY
 NOTE BOOK NO. GRADES CHECKED
 STRUCTURE NOTATIONS CH'VD

PROFILE SURVEYED BY DATE
 PLOTTED BY
 NOTE BOOK NO. GRADES CHECKED
 STRUCTURE NOTATIONS CH'VD

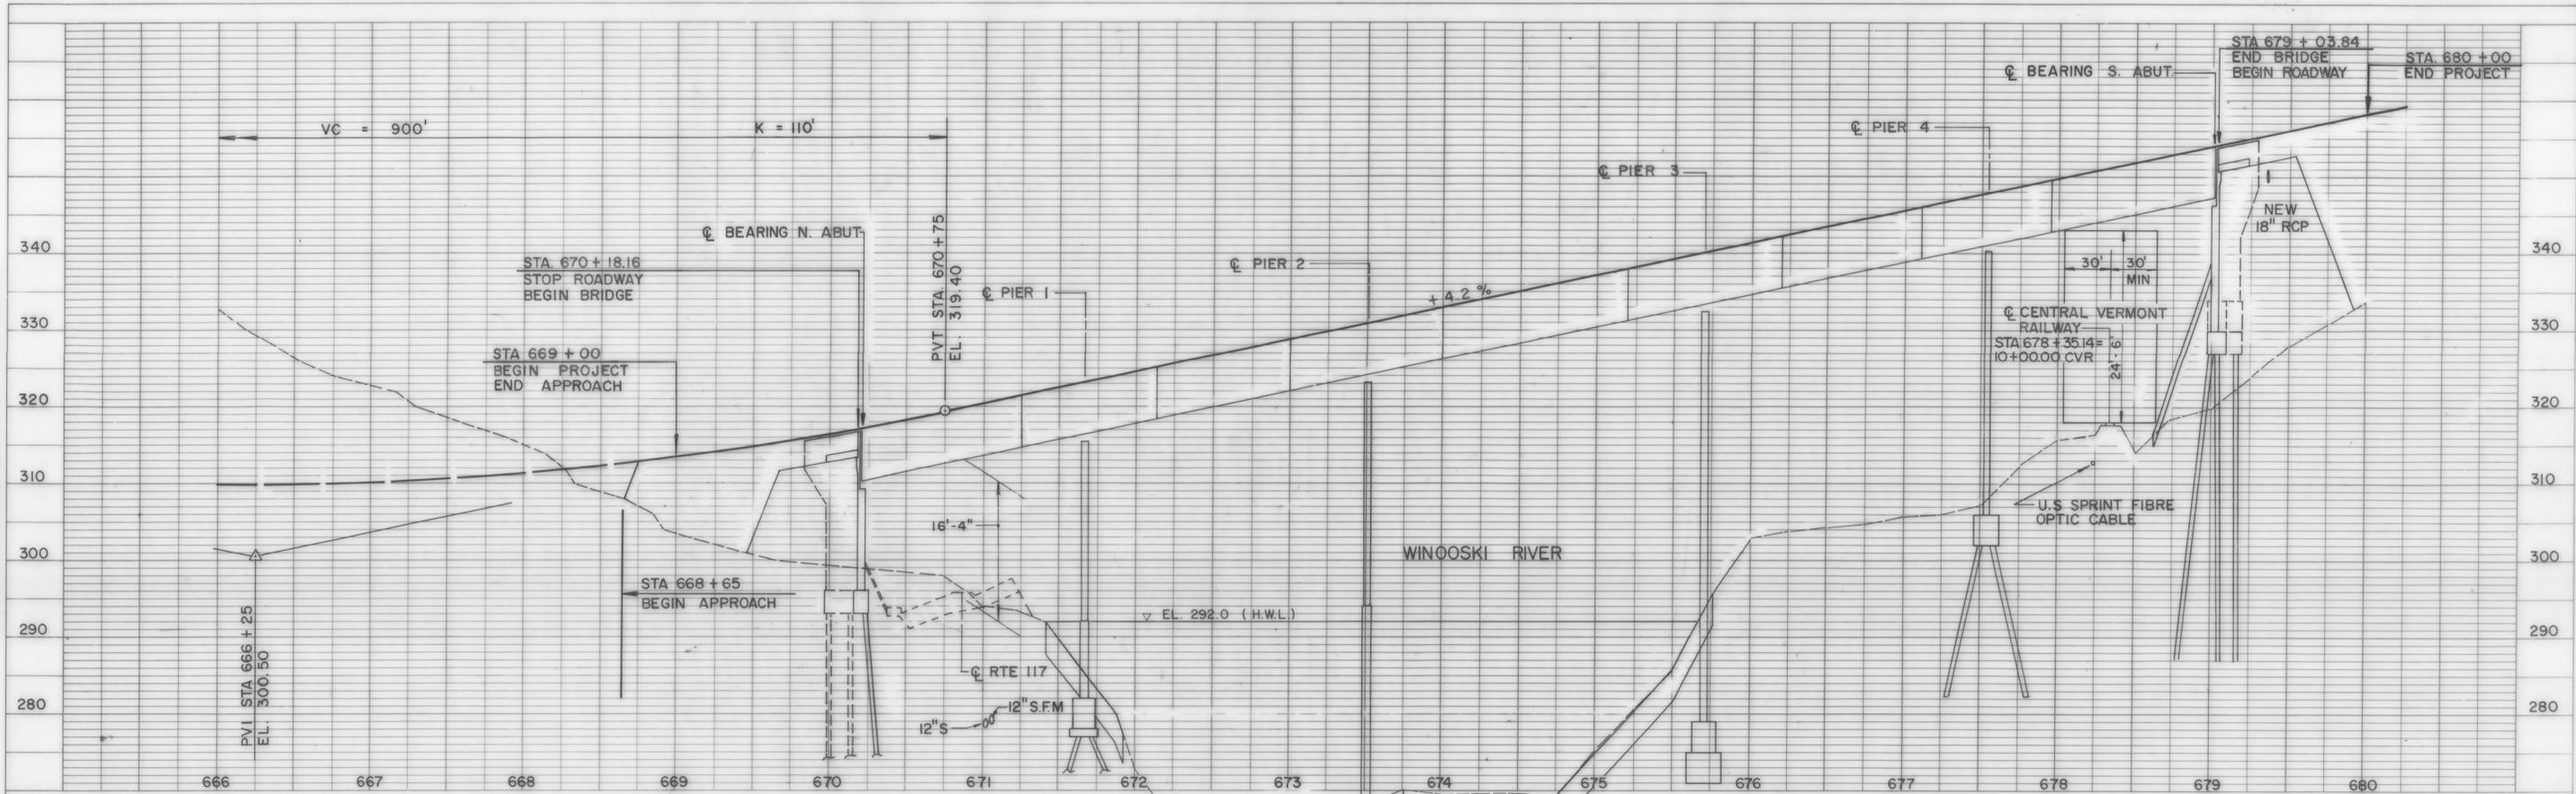

SURVEYED BY PINKHAM ENG. DATE 6/86
 DRAWN BY S.K.O. R.C.A. DATE 10/86
 TRACED BY N.P.D. DATE 11/86
 VERMONT ROUTE 289 (F.A.P.)
 TOWN OF ESSEX
 PROJ. WILLISTON- NO. PB 033-1(1)
 SHEET COLCHESTER OF
 24 31