
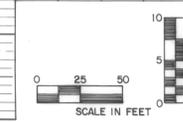


DATE _____ BY _____
 PLAN
 NOTE BOOK
 No. _____

DATE _____ BY _____
 PROFILE
 NOTE BOOK
 No. _____

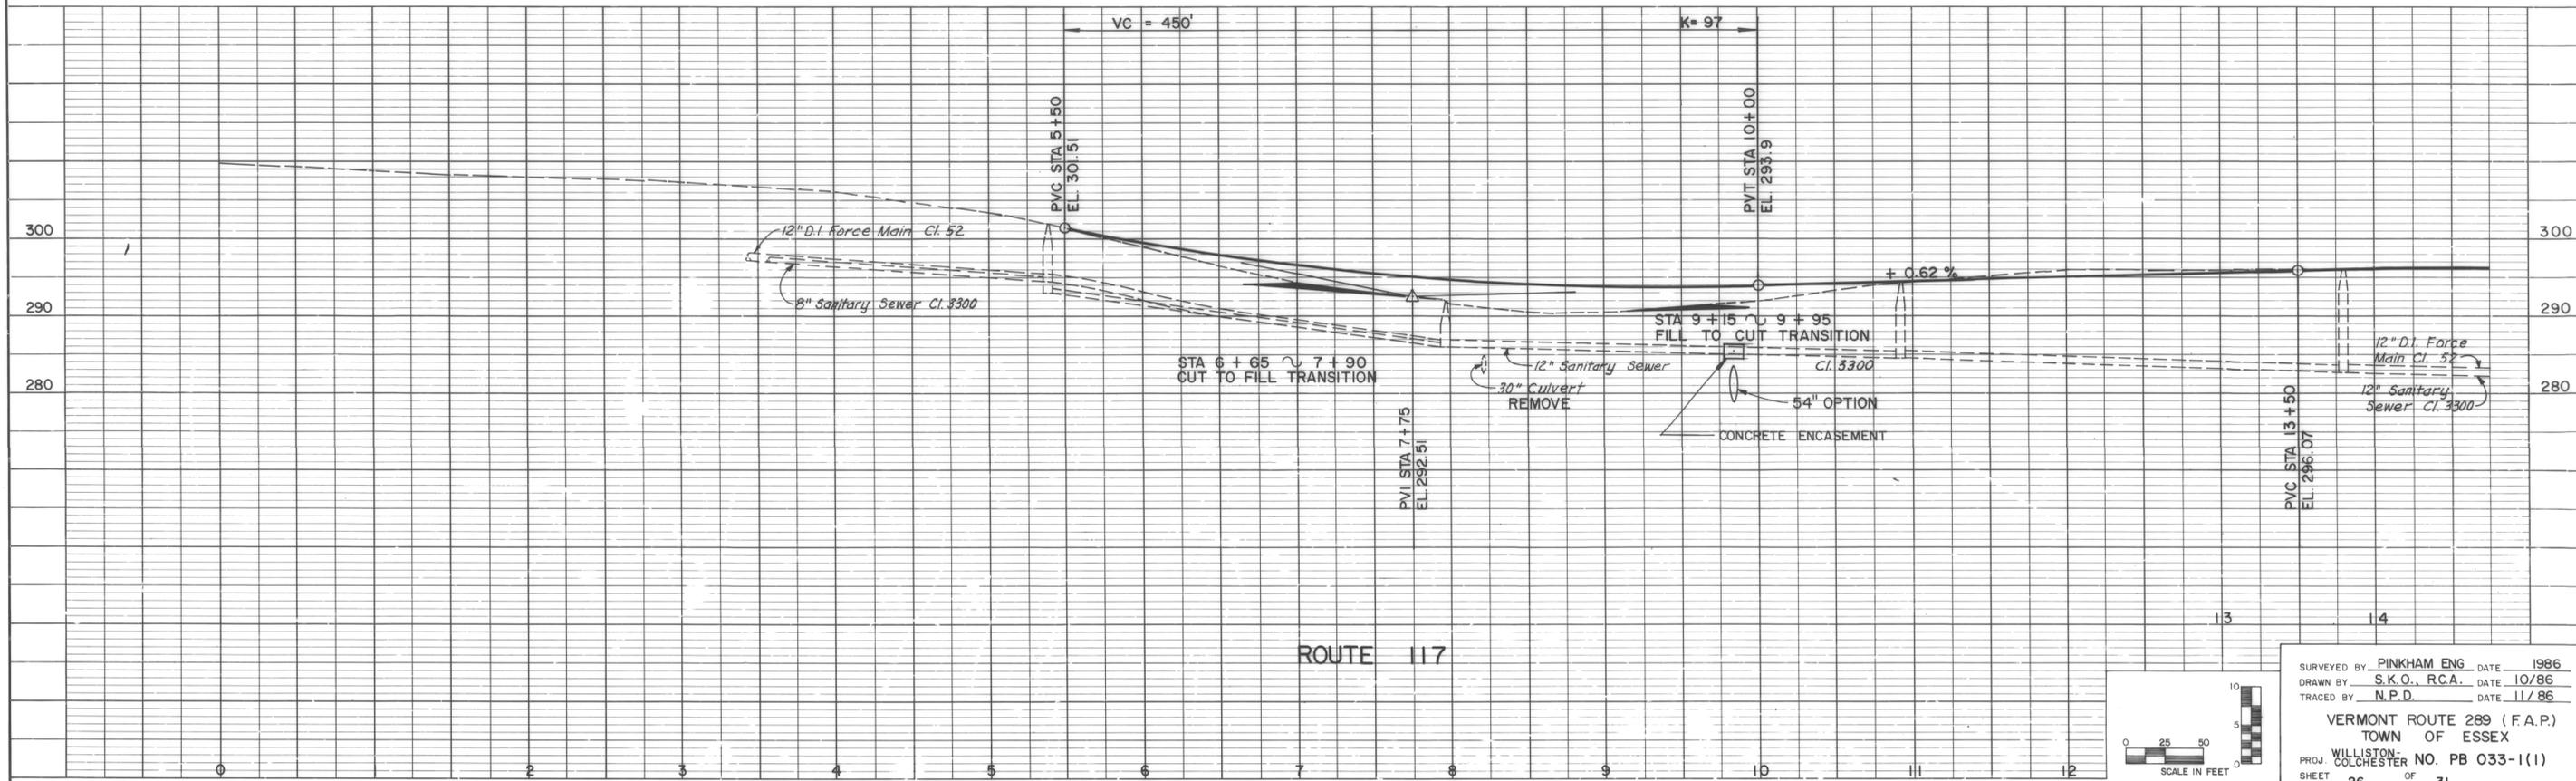

SURVEYED BY PINKHAM ENG DATE 1986
 DRAWN BY S.K.O., R.C.A. DATE 10/86
 TRACED BY N.P.D. DATE 11/86
 VERMONT ROUTE 289 (F.A.P.)
 TOWN OF ESSEX
 PROJ. COLCHESTER NO. PB 033-1(1)
 SHEET 26 OF 31