

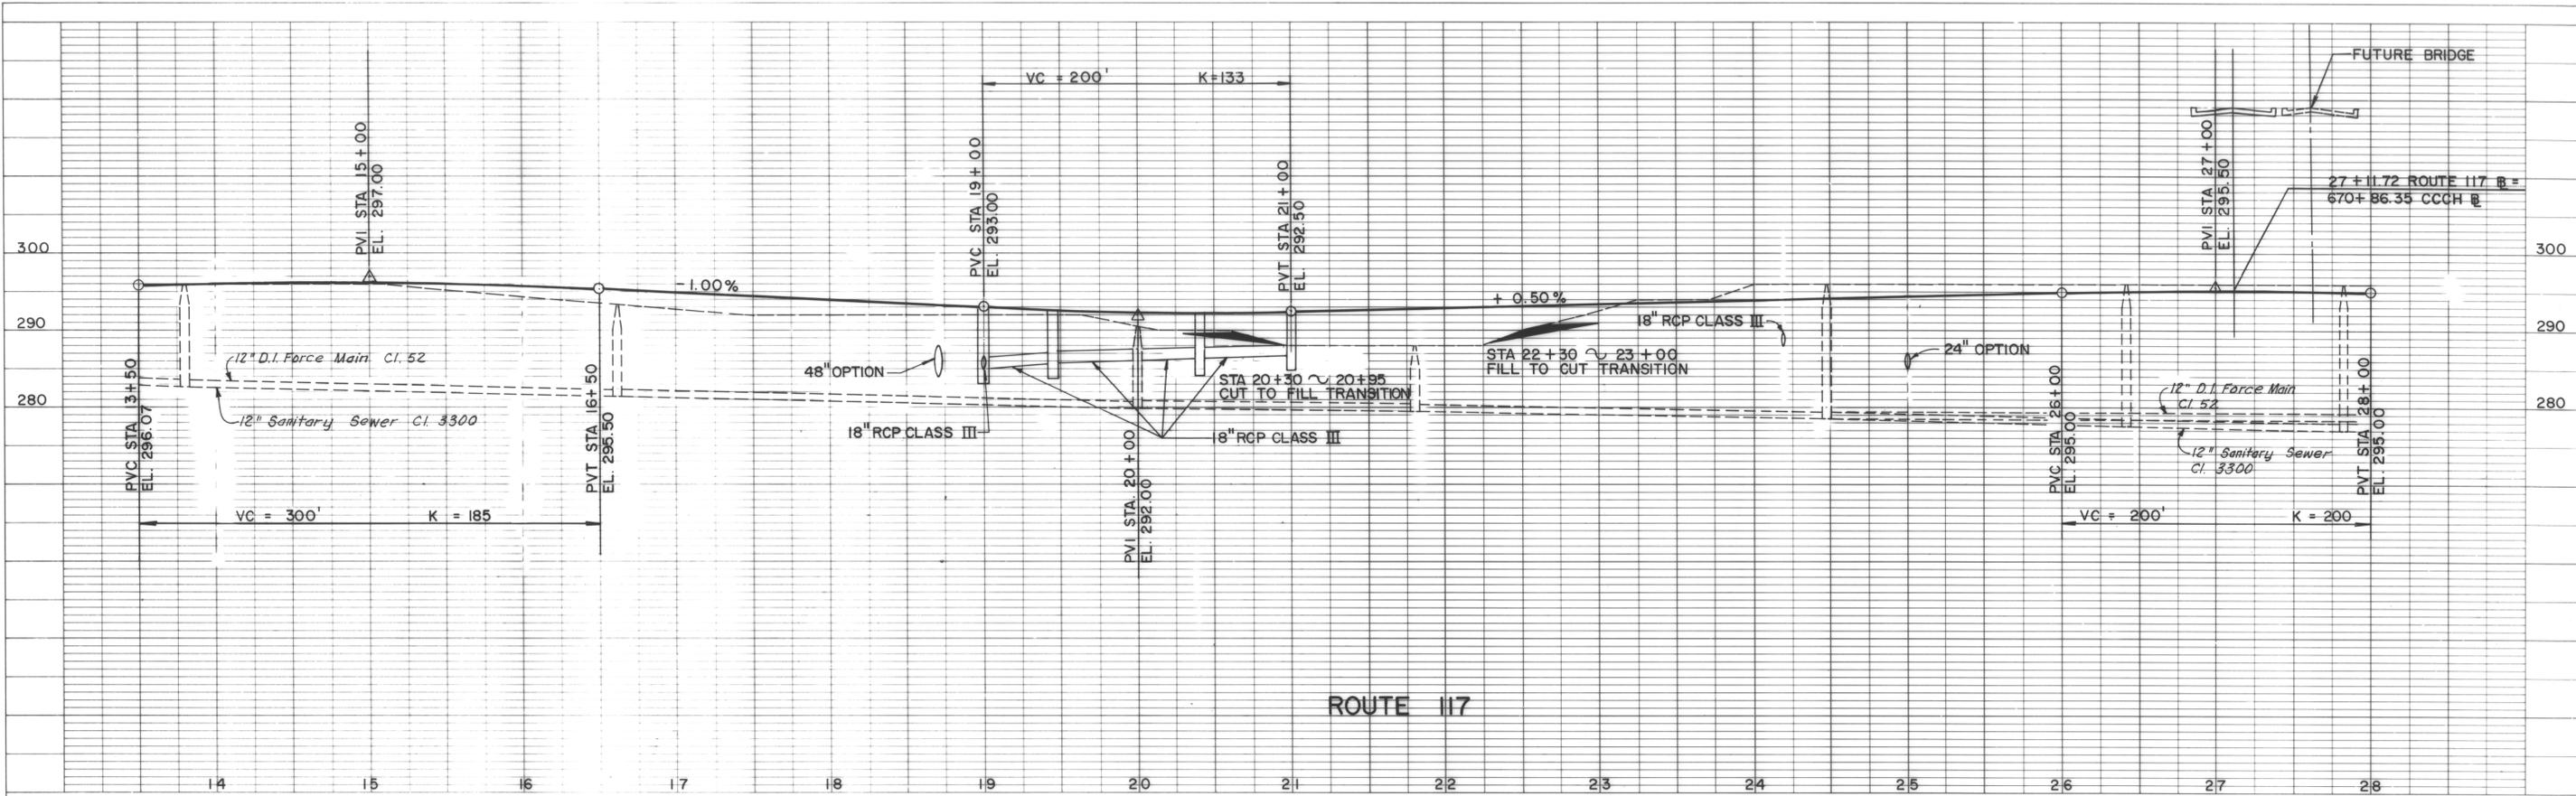


PROFILE SURVEYED BY DATE
 PLOTTED GRADES CHECKED
 NOTE BOOK B.M.'s NOTED
 NO. STRUCTURE NOTATIONS CHFD

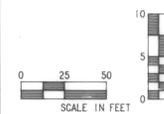

PROFILE SURVEYED BY DATE
 PLOTTED GRADES CHECKED
 NOTE BOOK B.M.'s NOTED
 NO. STRUCTURE NOTATIONS CHFD

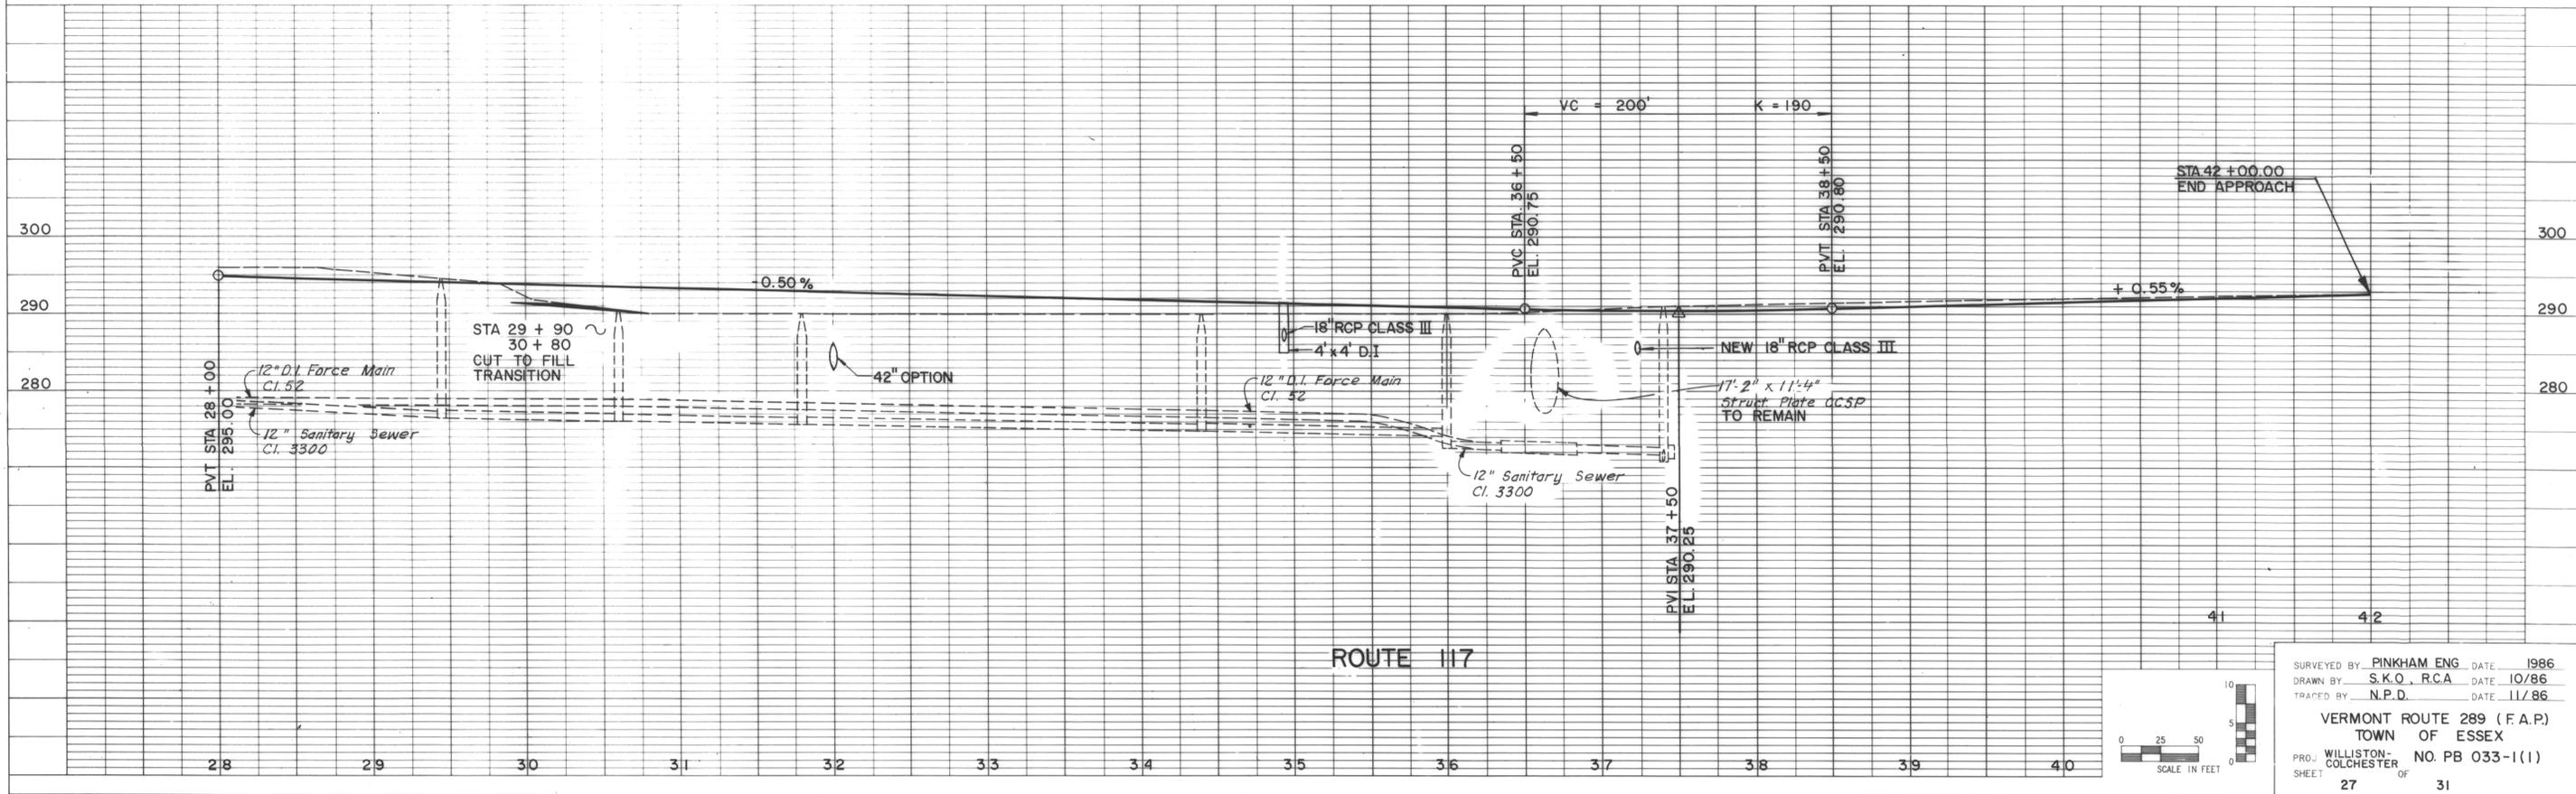

SURVEYED BY PINKHAM ENG DATE 1986
 DRAWN BY S.K.O., R.C.A DATE 10/86
 TRACED BY N.P.D. DATE 11/86
 VERMONT ROUTE 289 (F.A.P.)
 TOWN OF ESSEX
 PROJ WILLISTON- COLCHESTER NO. PB 033-1(1)
 SHEET 27 OF 31