

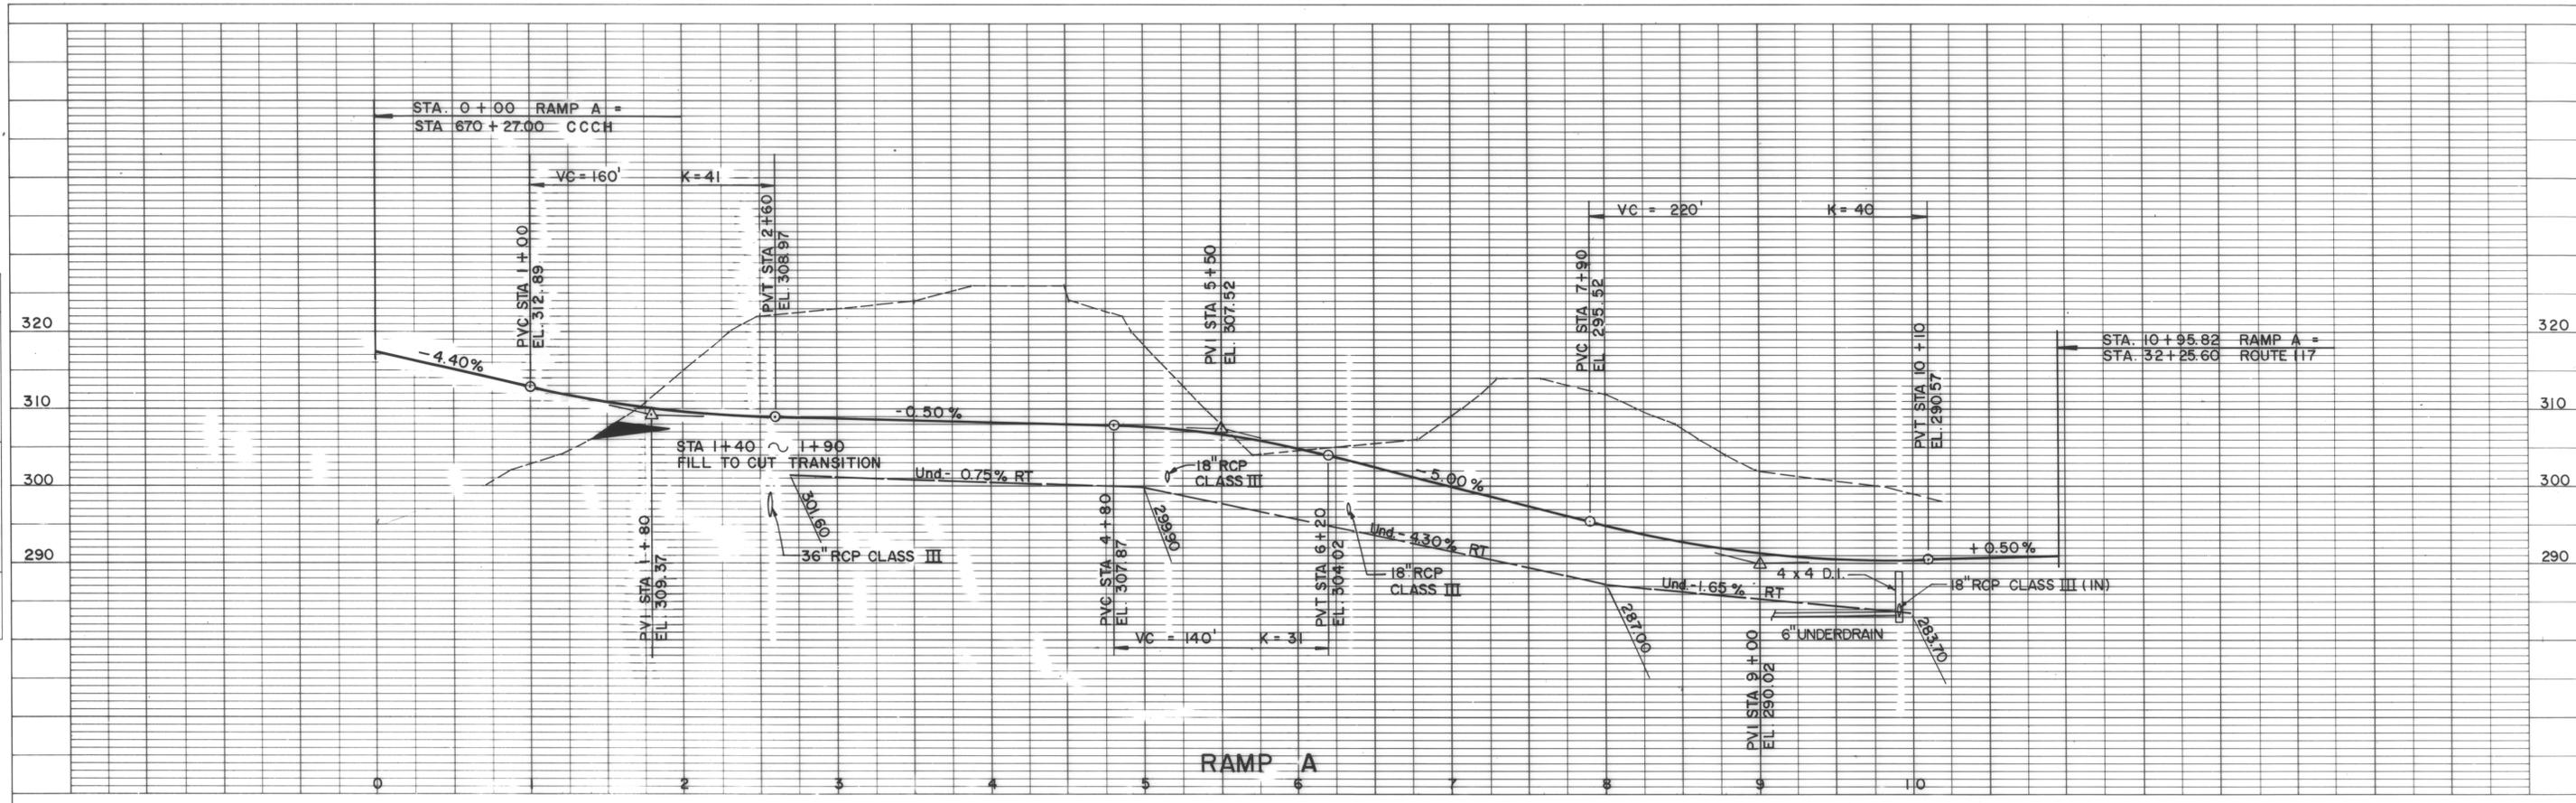


PROFILE
 SURVEYED BY _____ DATE _____
 NOTE BOOK _____
 GRADES CHECKED _____
 B.M.'s NOTED _____
 NO. _____ STRUCTURE NOTATIONS CH'RD

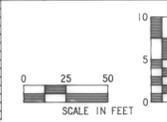

PROFILE
 SURVEYED BY _____ DATE _____
 NOTE BOOK _____
 GRADES CHECKED _____
 B.M.'s NOTED _____
 NO. _____ STRUCTURE NOTATIONS CH'RD

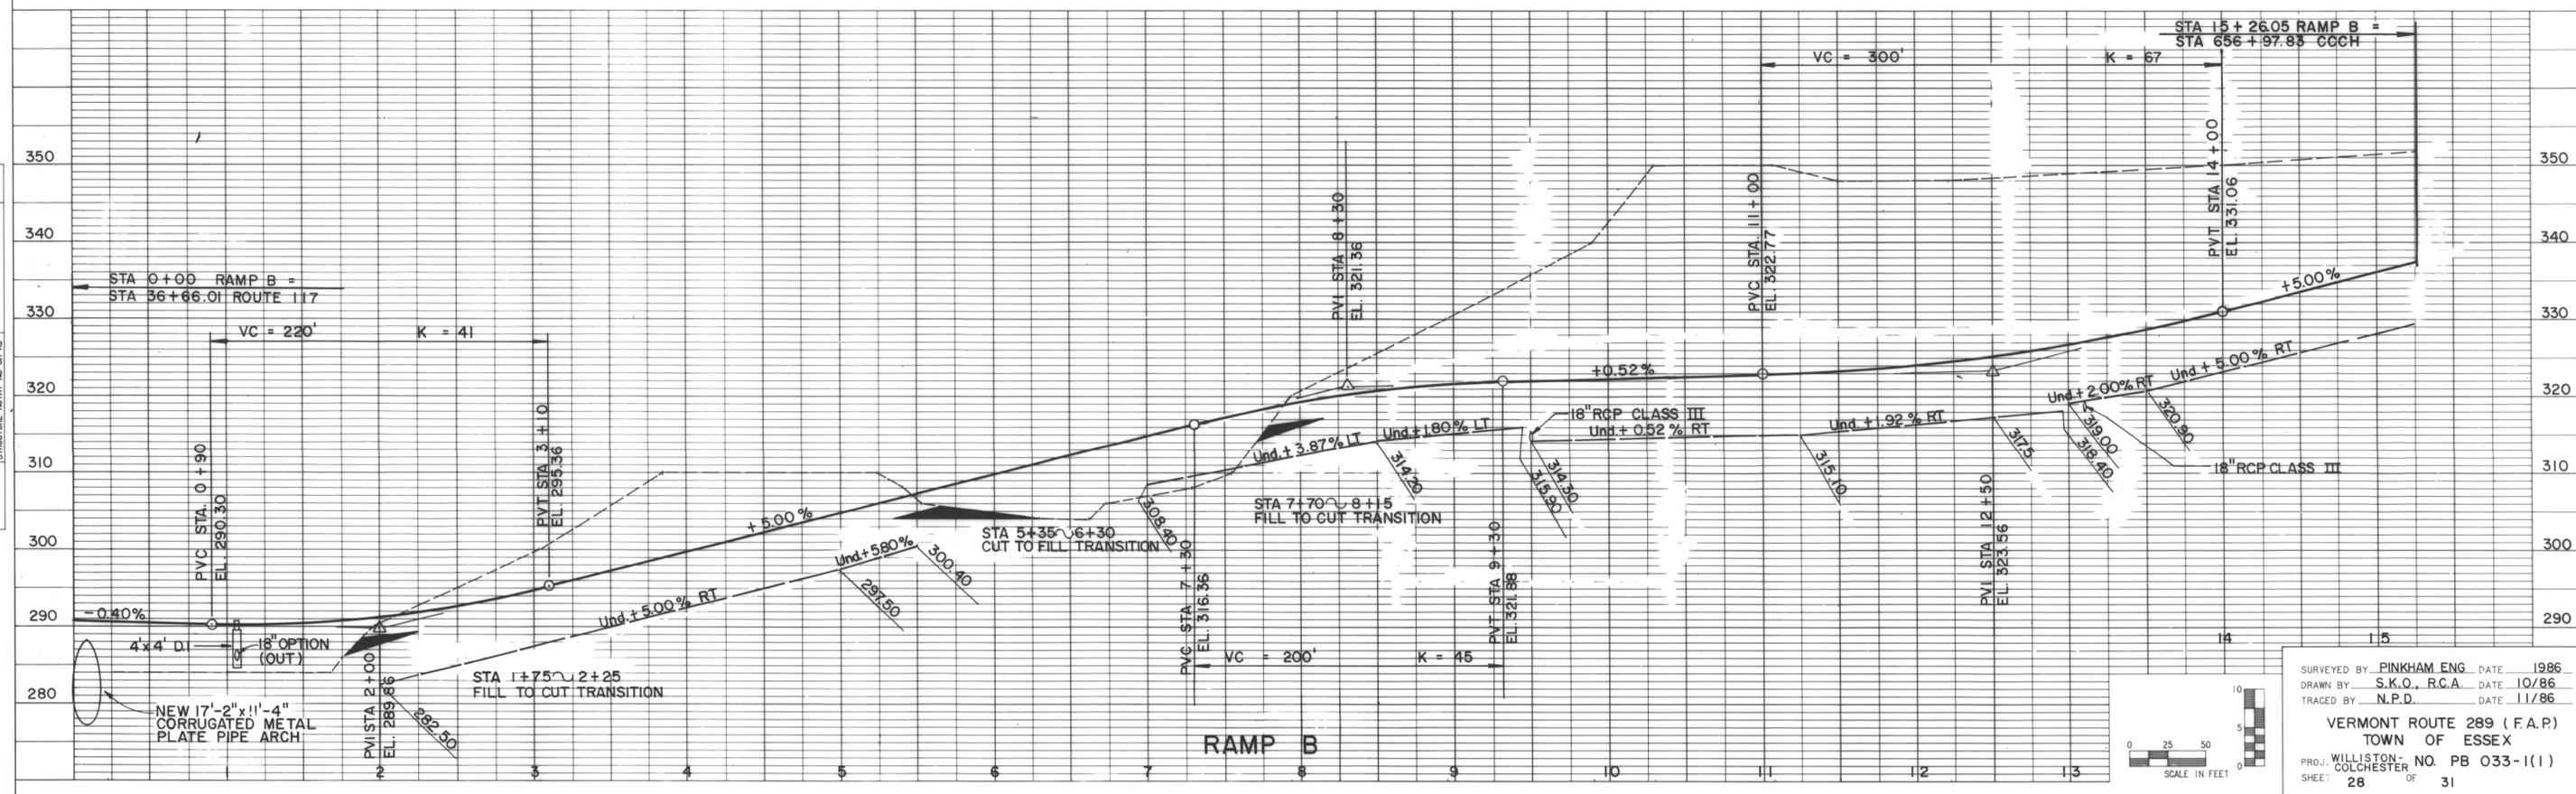

SURVEYED BY PINKHAM, ENG. DATE 1986
 DRAWN BY S.K.O., R.C.A. DATE 10/86
 TRACED BY N.P.D. DATE 11/86
 VERMONT ROUTE 289 (F.A.P.)
 TOWN OF ESSEX
 PROJ. WILLISTON, NO. PB 033-1(1)
 COLCHESTER
 SHEET 28 OF 31