



TYPICAL SECTIONS


3" BITUMINOUS CONCRETE PAVEMENT — 1/4" TYPE III WEARING COURSE, 1 3/4" TYPE II BINDING COURSE
 3" BITUMINOUS CONCRETE PAVEMENT, TYPE I - BASE COURSE 1-3" COURSE
 30" SUBBASE OF DENSE GRADED CRUSHED STONE
 SHOULDERS 1/4" BITUMINOUS CONCRETE PAVEMENT
 18" SAND BORROW

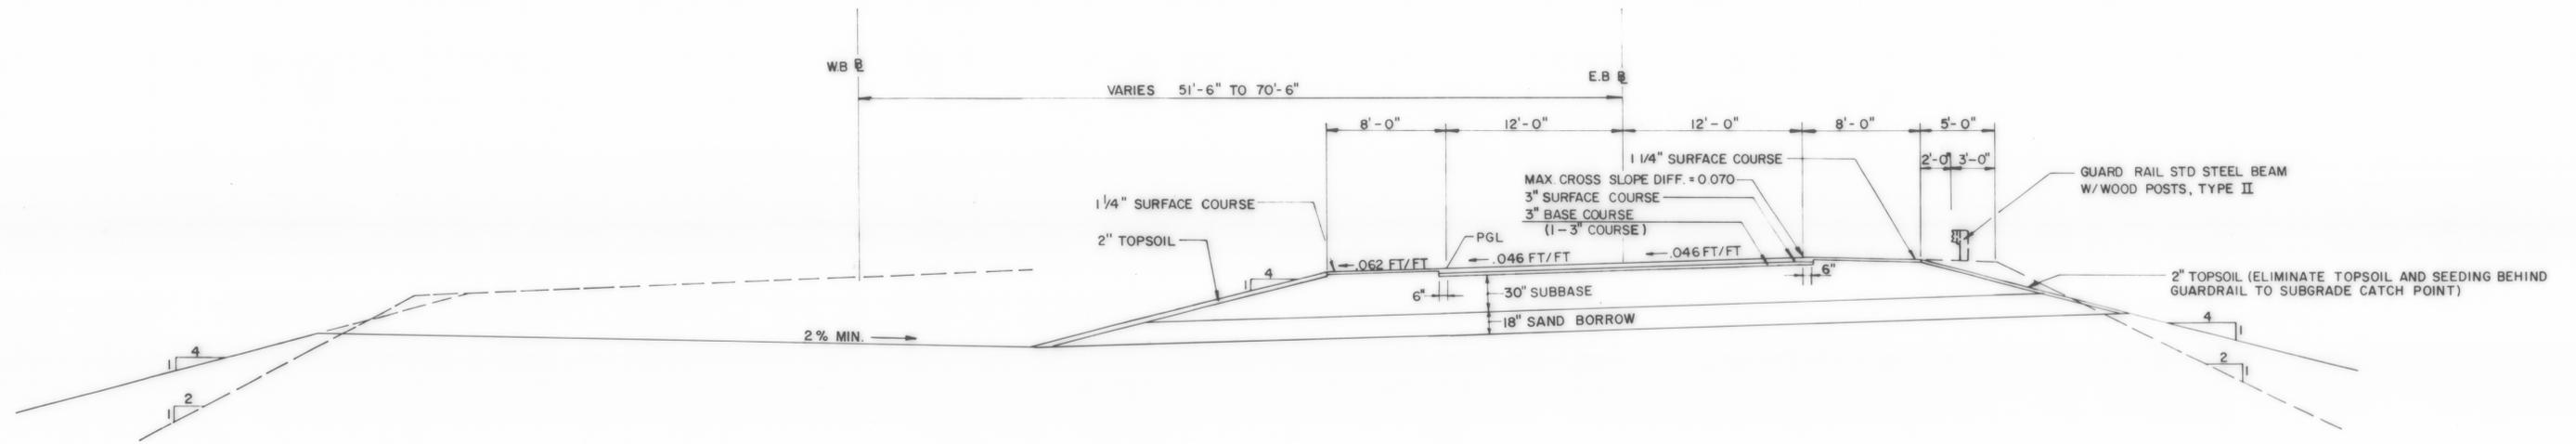

MAXIMUM BANKED SECTION

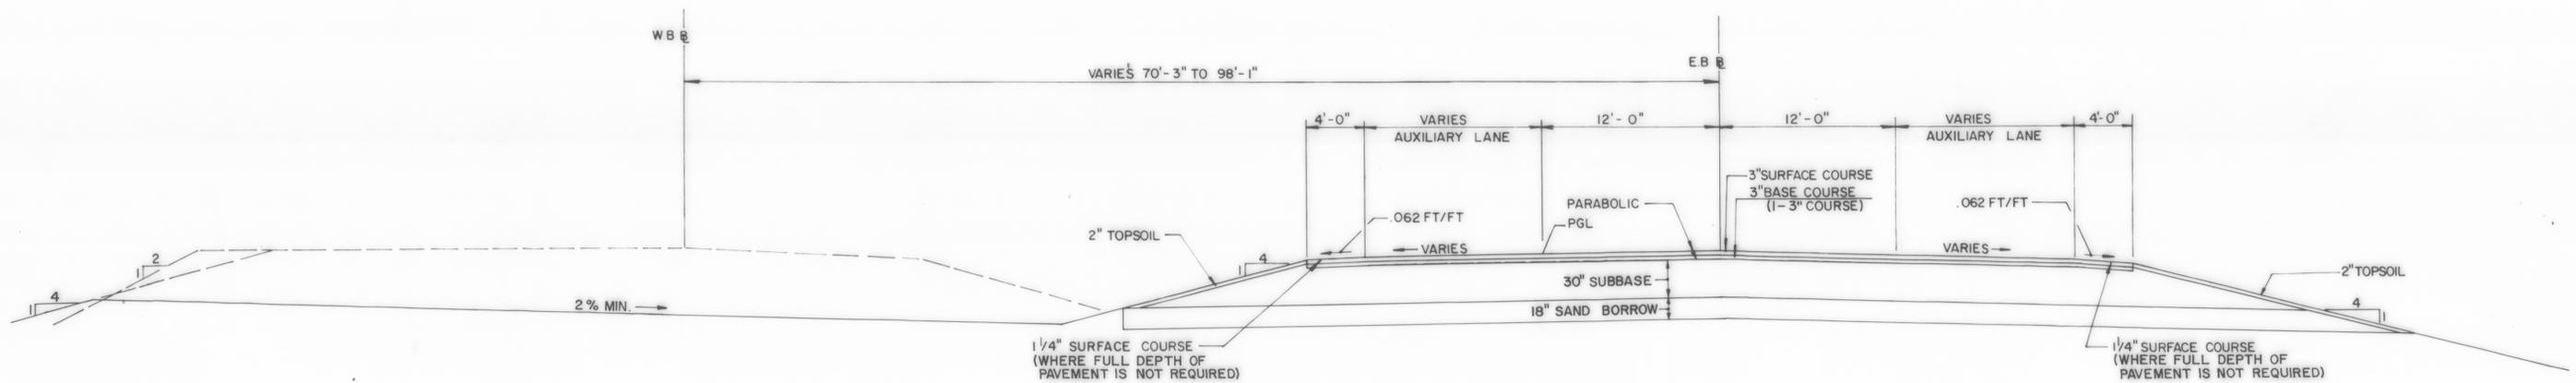

NORMAL SECTION

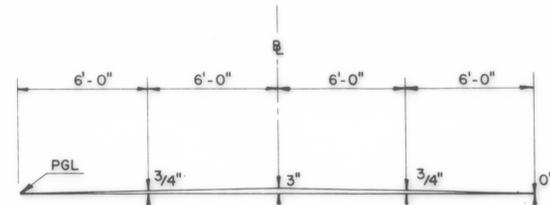

PARABOLIC DETAIL

SHOULDER PAVEMENT TO INCLUDE FULL DEPTH OF PAVEMENT AND BASE
 ROUTE 289 STA 612+00 TO 615+35 RT
 STA 615+00 TO 617+00 LT

DATUM
 VERTICAL _____
 HORIZONTAL _____

R. O. W. PLANS

SURVEYED BY PINKHAM ENG DATE 6/86
 DRAWN BY RCA DATE 6/87
 TRACED BY NPD DATE 6/87
 VERMONT ROUTE 289 (F.A.P.)
 TOWN OF ESSEX
 PROJ. WILLISTON NO. PB 033-1(1)
 COLCHESTER
 SHEET 6 OF 55