


TYPICAL SECTIONS


3" BITUMINOUS CONCRETE PAVEMENT - 1/4" TYPE III WEARING COURSE, 1 3/4" TYPE II BINDING COURSE
 3" BITUMINOUS CONCRETE PAVEMENT, TYPE I - BASE COURSE 1-3" COURSE
 30" SUBBASE OF DENSE GRADED CRUSHED STONE
 SHOULDERS 1/4" BITUMINOUS CONCRETE PAVEMENT
 18" SAND BORROW

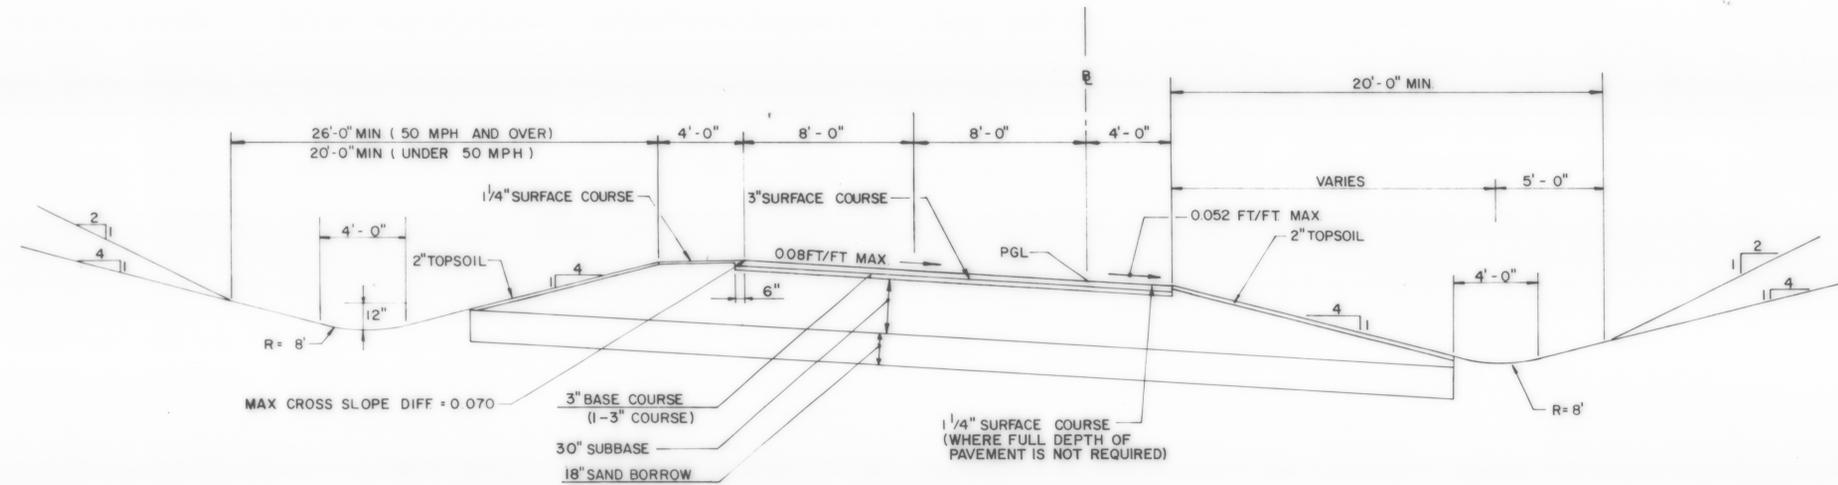

TYPICAL RAMP - BANKED SECTION

SHOULDER PAVEMENT TO INCLUDE FULL DEPTH OF PAVEMENT AND BASE
 RAMP A STA 0+00 TO 2+50 RT
 STA 2+50 TO 5+08 LT
 RAMP B STA 8+50 TO 14+25 RT
 RAMP C STA 2+20 TO 8+82 RT

NOTE:
 WHEN EXISTING SUBGRADE MATERIAL IN A CUT MEETS OR EXCEEDS THE REQUIREMENTS FOR SAND BORROW, THE EXISTING MATERIAL SHALL REMAIN AND THE SAND BORROW SHALL BE ELIMINATED IN THAT AREA.

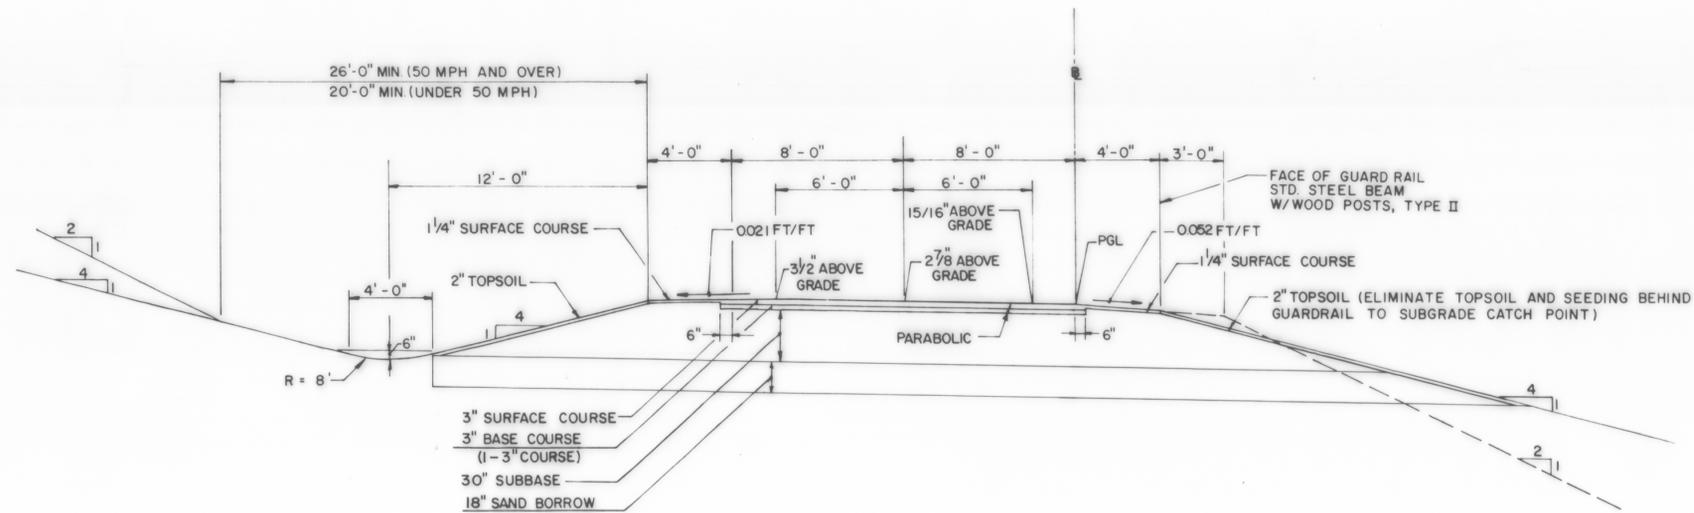

TYPICAL RAMP - NORMAL SECTION

DATUM
 VERTICAL _____
 HORIZONTAL _____

R. O. W. PLANS

SURVEYED BY PINKHAM ENG DATE 6/86
 DRAWN BY RCA DATE 6/87
 TRACED BY NPD DATE 6/87
 VERMONT ROUTE 289 (F.A.P.)
 TOWN OF ESSEX
 PROJ WILLISTON NO. PB 033-1(1)
 COLCHESTER
 SHEET 8 OF 55