
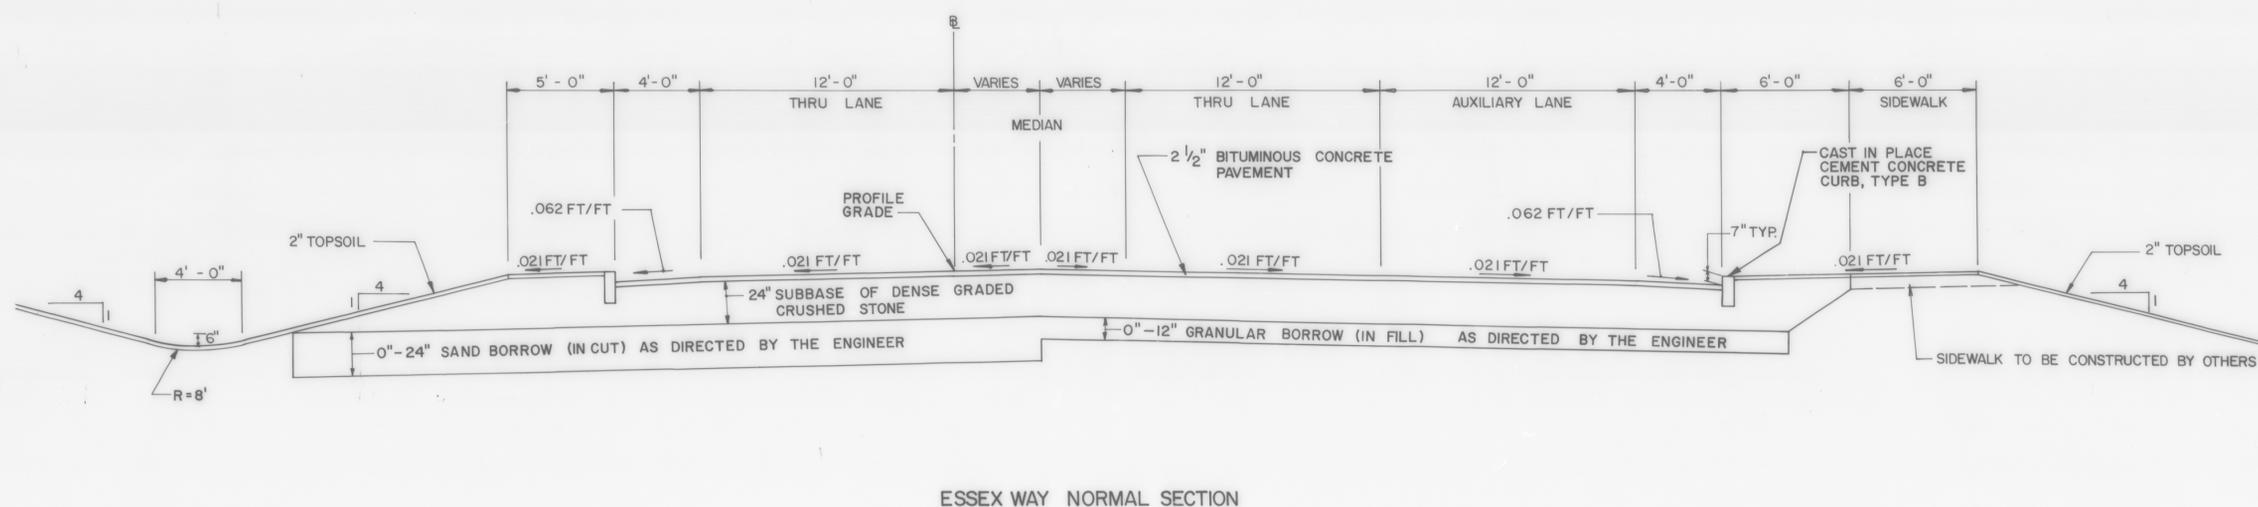


TYPICAL SECTIONS

2 1/2" BITUMINOUS CONCRETE PAVEMENT - 1" TYPE III WEARING COURSE, 1 1/2" TYPE II BINDING COURSE

24" SUBBASE OF DENSE GRADED CRUSHED STONE
 SHOULDERS 1 1/4" BITUMINOUS CONCRETE PAVEMENT
 0" TO 12" GRANULAR BORROW (IN FILLS) } AS DIRECTED BY THE ENGINEER
 0" TO 24" SAND BORROW (IN CUTS)

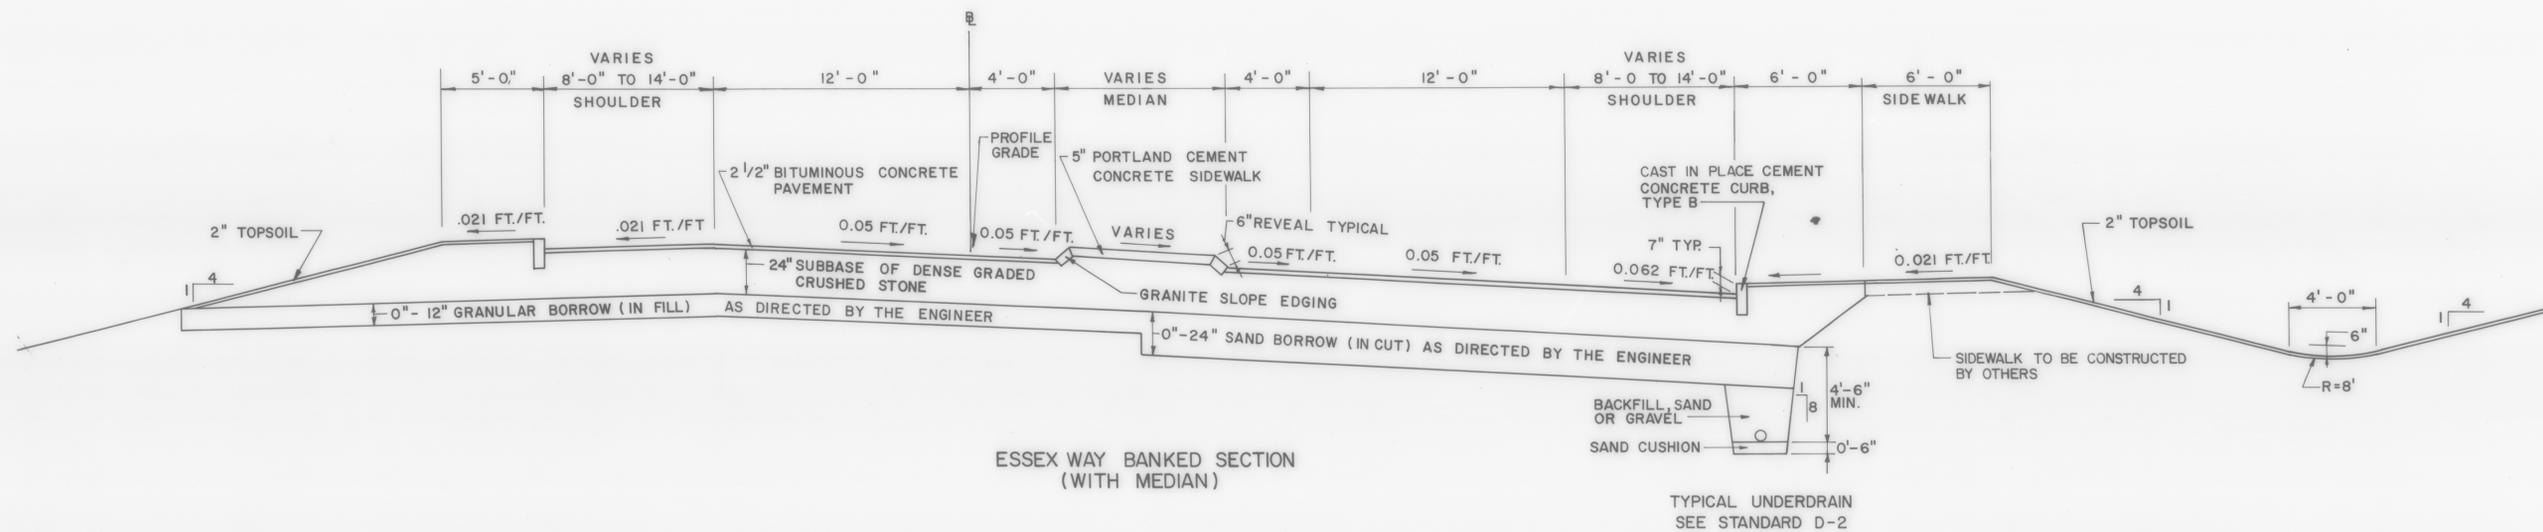

DATUM
 VERTICAL _____
 HORIZONTAL _____

R. O. W. PLANS

SURVEYED BY PINKHAM ENG DATE 6/86
 DRAWN BY RCA DATE 9/87
 TRACED BY NPD DATE 2/88
 VERMONT ROUTE 289 (F.A.P.)
 TOWN OF ESSEX
 PROJ WILLISTON No. PB 033-1(1)
 COLCHESTER
 SHEET 11 OF 55