



TYPICAL SECTIONS

3" BITUMINOUS CONCRETE PAVEMENT - 1/4" TYPE III WEARING COURSE, 1 3/4" TYPE II BINDING COURSE
 3" BITUMINOUS CONCRETE PAVEMENT, TYPE I - BASE COURSE 1-3" COURSE
 30" SUBBASE OF DENSE GRADED CRUSHED STONE
 SHOULDERS 1/4" BITUMINOUS CONCRETE PAVEMENT
 18" SAND BORROW

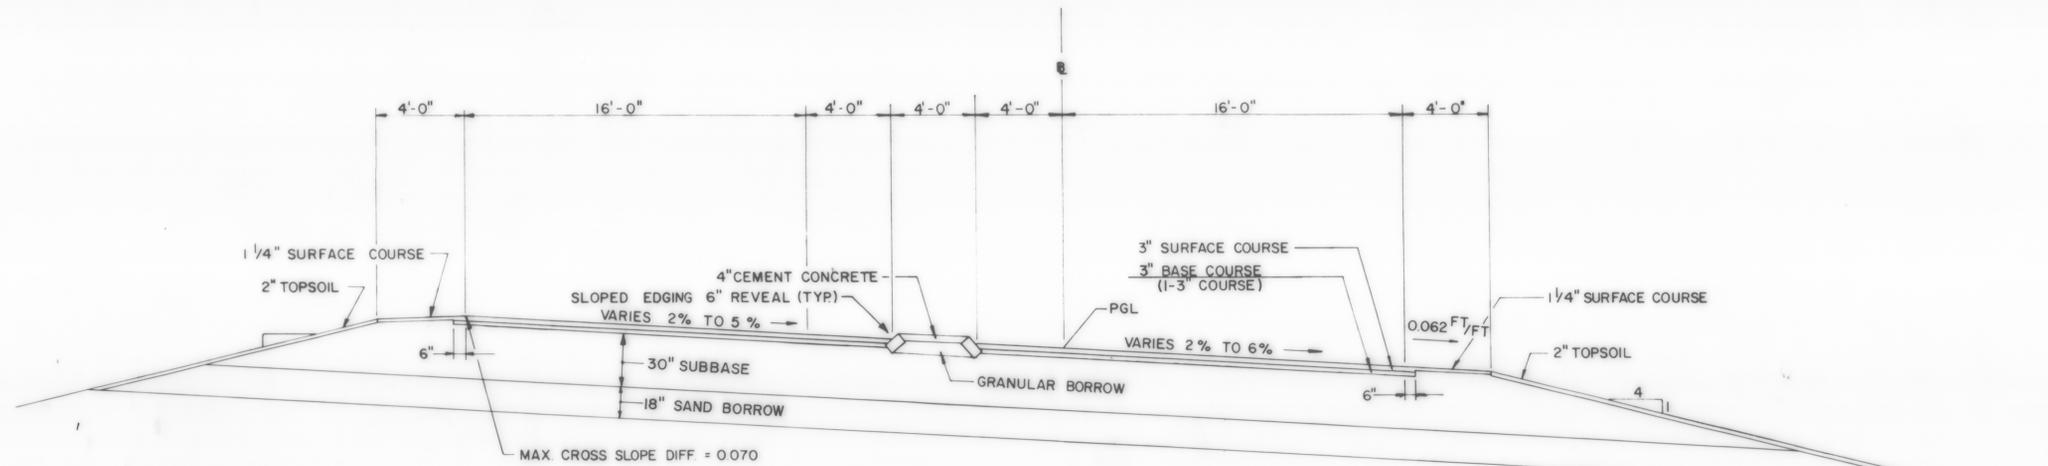

ALLEN MARTIN PARKWAY

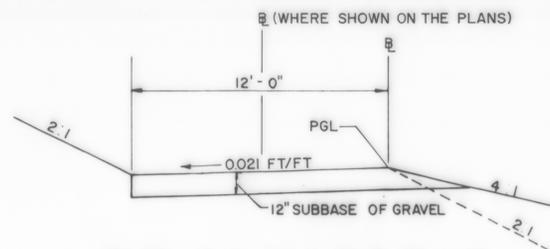

- STA 581 + 05 LT - STA 0 + 00 TO STA 4 + 81
- STA 595 + 45 RT - STA 0 + 00 TO STA 4 + 25
- STA 11 + 75 RAMP B RT - STA 0 + 00 TO STA 2 + 60
- STA 600 + 50 LT - STA 0 + 00 TO STA 3 + 50
- STA 623 + 50 LT - STA 0 + 00 TO STA 2 + 30

ACCESS DRIVE

DATUM
 VERTICAL _____
 HORIZONTAL _____

R. O. W. PLANS

SURVEYED BY PINKHAM ENG DATE 6/86
 DRAWN BY RCA DATE 6/87
 TRACED BY NPD DATE 6/87
 VERMONT ROUTE 289 (F.A.P.)
 TOWN OF ESSEX
 PROJ WILLISTON NO. PB 033-1(1)
 COLCHESTER
 SHEET 12 OF 55