

N 732.750

E 346.750


N 733.250

E 347.250



CONSTRUCT DRIVE  
26 + 90 LT  
28 + 25 RT  
29 + 25 LT

HAYES I. & SUSAN H. SOGOLOFF

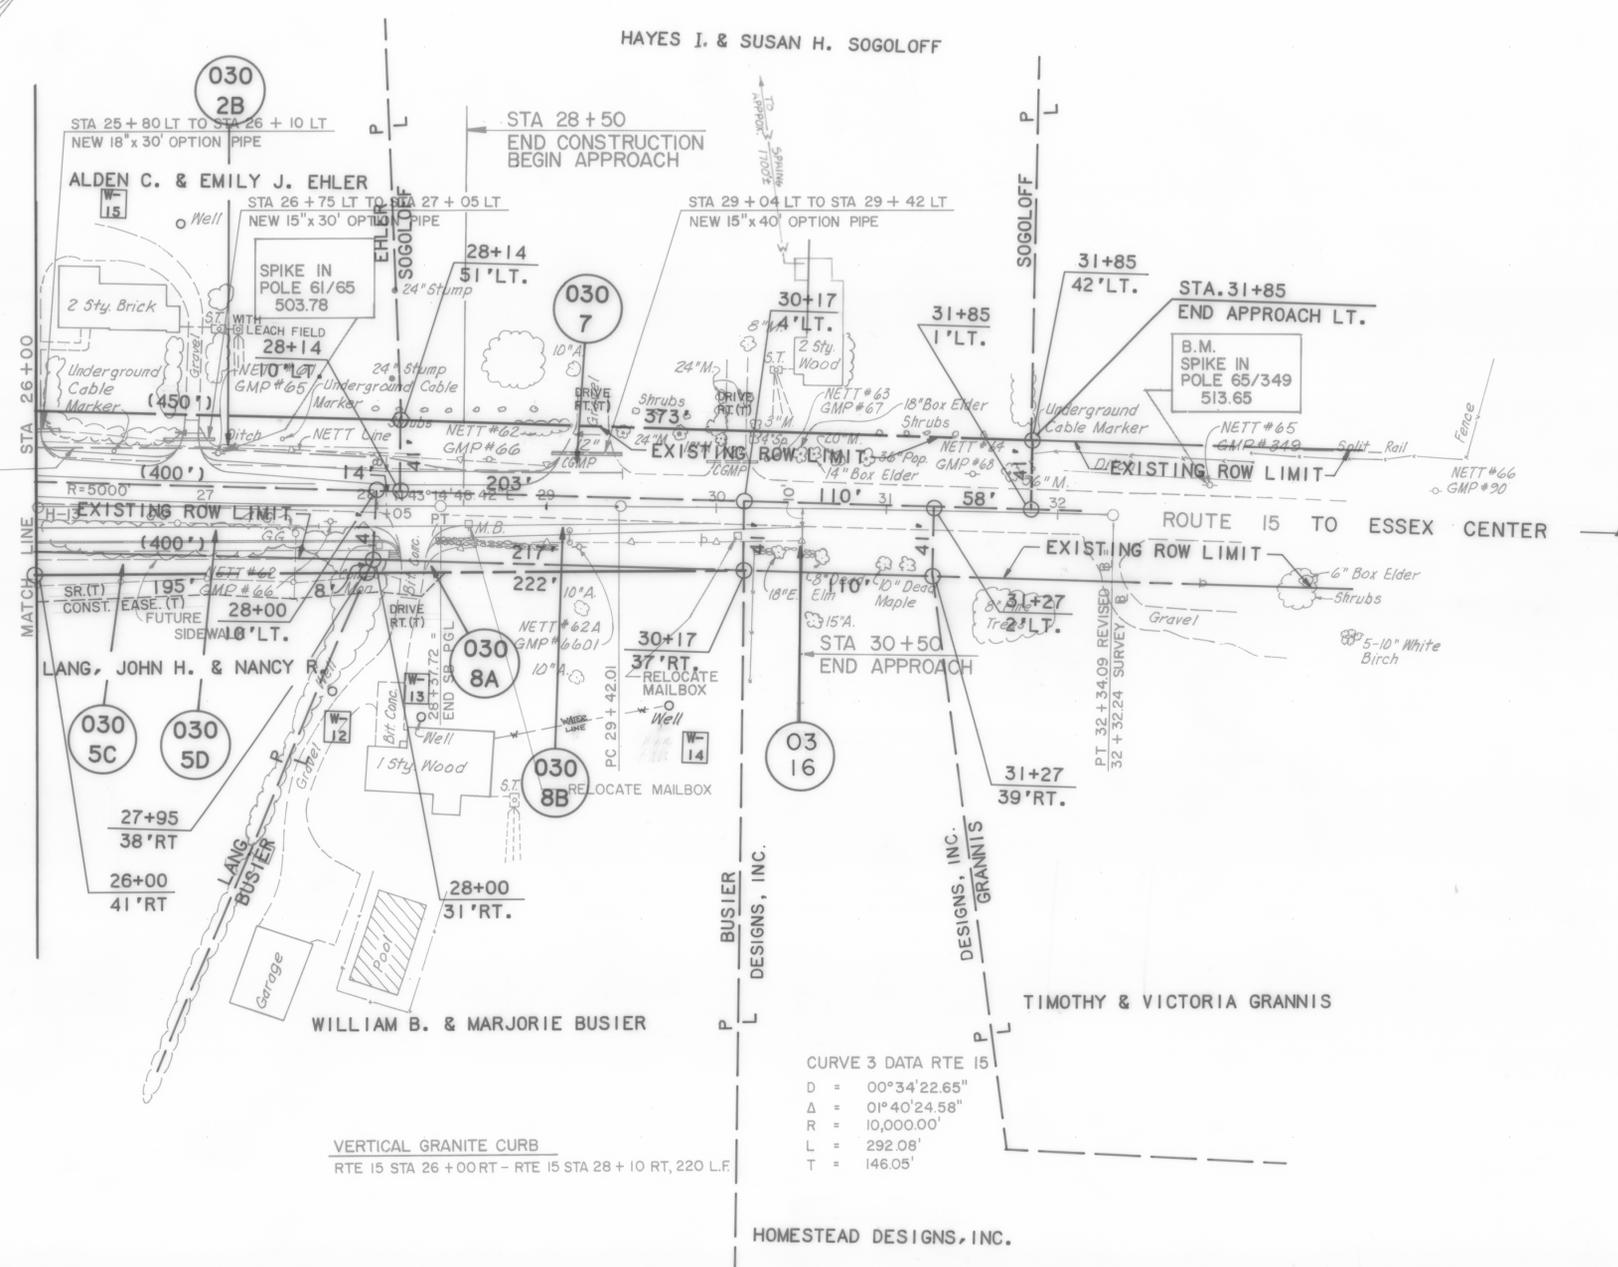

E 347.750

STA 24 + 51 LT TO STA 29 + 45 LT  
NEW 6" x 49' UNDERDRAIN  
W/CAP END

EXISTING ROW LIMIT  
(400')

EXISTING ROW LIMIT  
ROUTE 15 TO ESSEX CENTER

N 732.250

CURVE 3 DATA RTE 15  
D = 00°34'22.65"  
Δ = 01°40'24.58"  
R = 10,000.00'  
L = 292.08'  
T = 146.05'

VERTICAL GRANITE CURB  
RTE 15 STA 26 + 00 RT - RTE 15 STA 28 + 10 RT, 220 L.F.

HOMESTEAD DESIGNS, INC.

DATUM  
VERTICAL \_\_\_\_\_  
HORIZONTAL \_\_\_\_\_

E 347.250

N 732.250

E 347.750

N 732.750

N 733.250

R. O. W. PLANS

SURVEYED BY PINKHAM ENG DATE 12/85  
DRAWN BY D.R.O. DATE 10/88  
TRACED BY N.P.D. DATE 11/88  
VERMONT ROUTE 289 ( F.A.P.)  
TOWN OF ESSEX  
WILLISTON  
PROJ. COLCHESTER NO. PB 033-1(1)  
SHEET 35 OF 55