
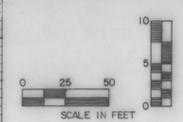


PLAN	DATE	BY
	NO.	
NOTE BOOK	DESIGN NO.	
	ALIGNMENT CHECKED	
No.	RT. OF WAY CHECKED	

PROFILE	DATE	BY
	NO.	
NOTE BOOK	SURVEYED	
	GRADES CHECKED	
No.	B.M.'S NOTED	
	SPOT GRADES CHECKED	

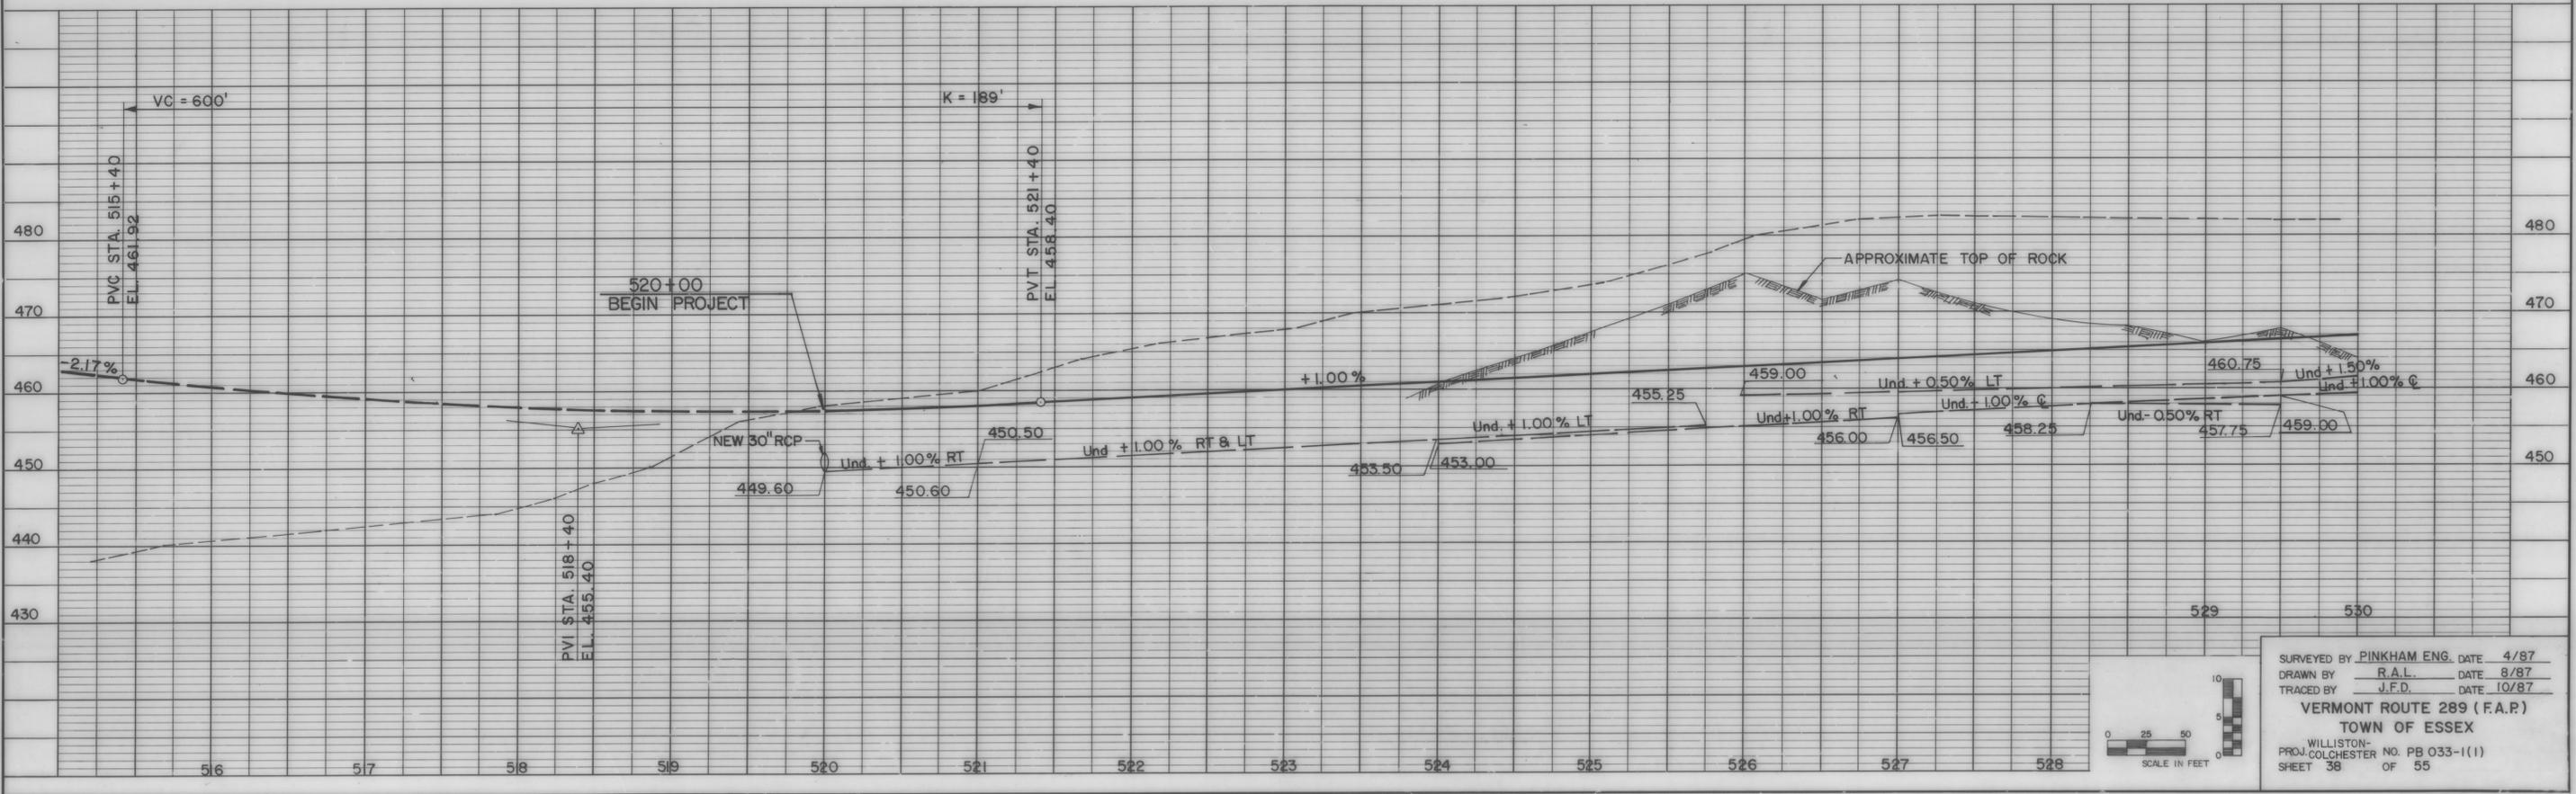

SURVEYED BY PINKHAM ENG. DATE 4/87  
 DRAWN BY R.A.L. DATE 8/87  
 TRACED BY J.F.D. DATE 10/87  
**VERMONT ROUTE 289 (F.A.P.)**  
**TOWN OF ESSEX**  
 WILLISTON-  
 PROJ. COLCHESTER NO. PB 033-1(1)  
 SHEET 38 OF 55