

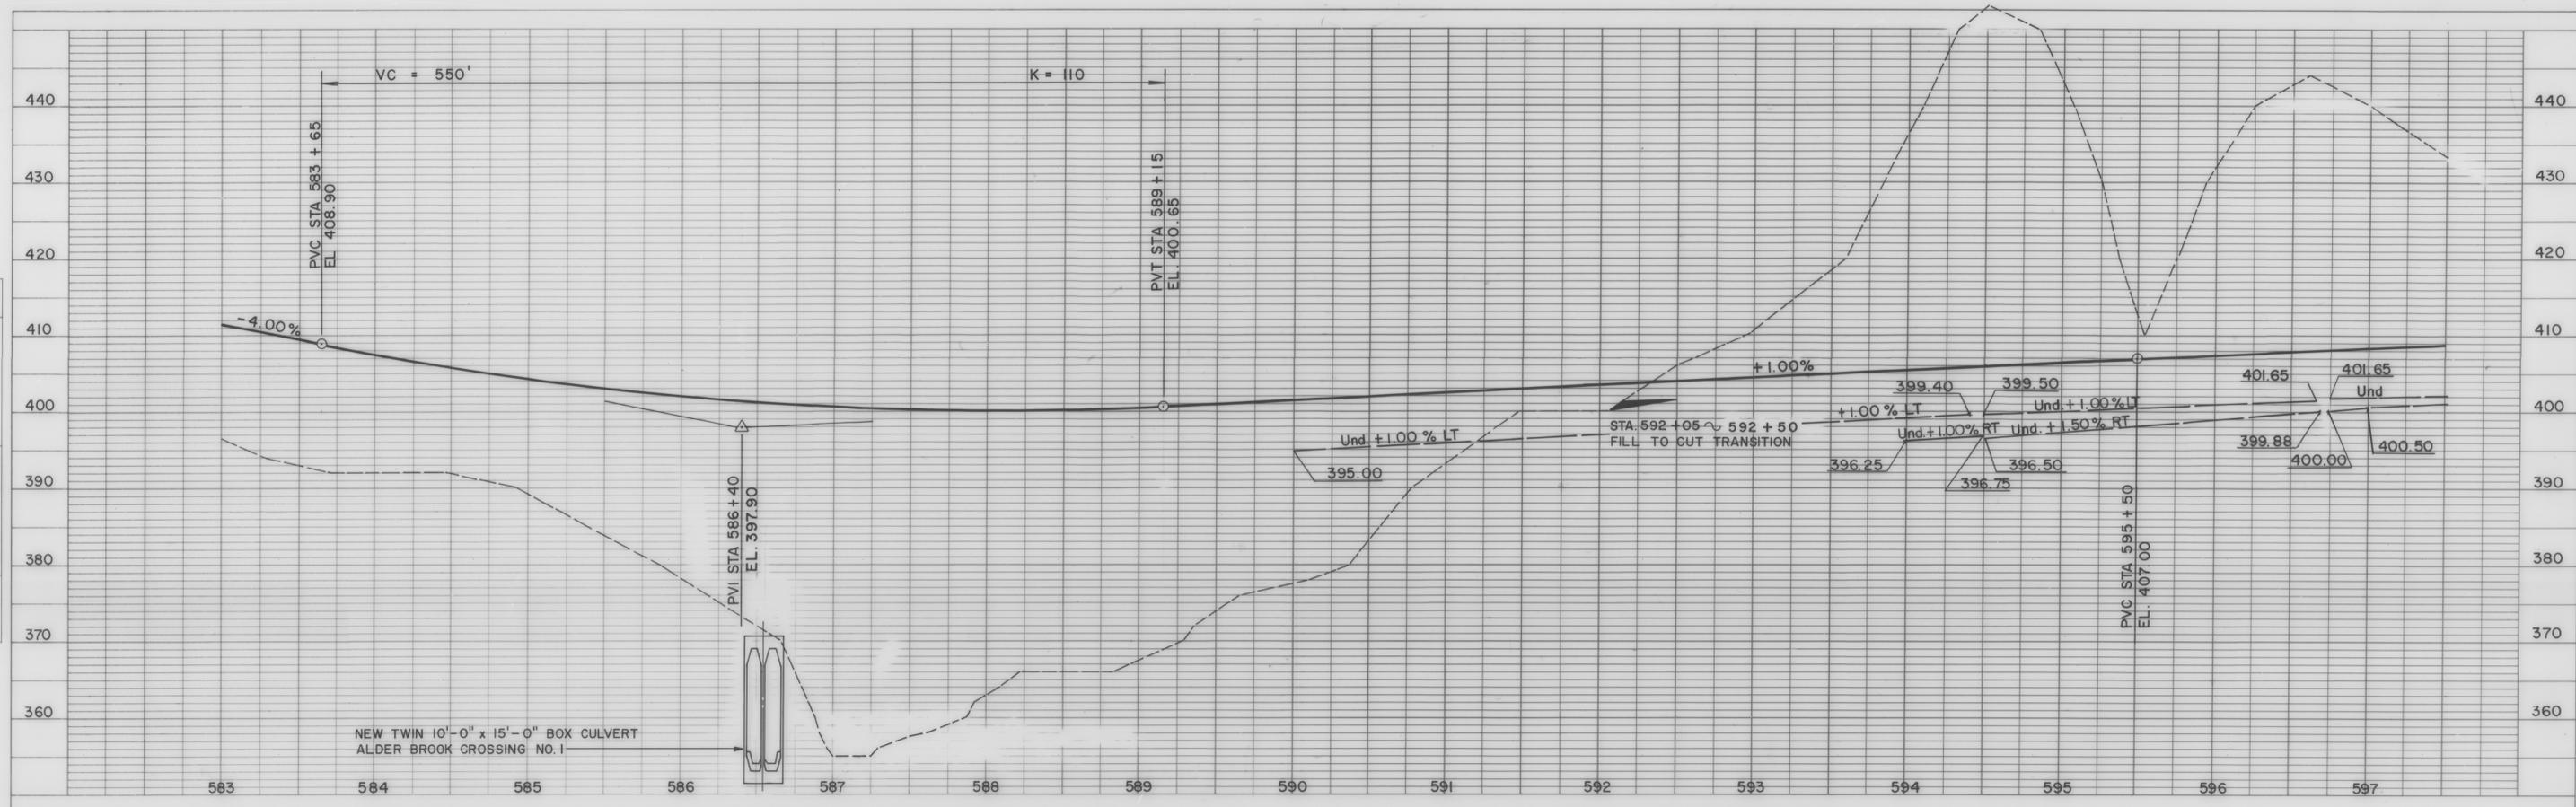


PROFILE SURVEYED BY DATE
 PLOTTED BY DATE
 NOTE BOOK GRADES CHECKED
 B.M. # NOTED
 NO. STRUCTURE NOTATIONS CH'VD

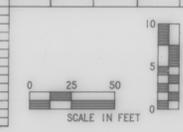

PROFILE SURVEYED BY DATE
 PLOTTED BY DATE
 NOTE BOOK GRADES CHECKED
 B.M. # NOTED
 NO. STRUCTURE NOTATIONS CH'VD

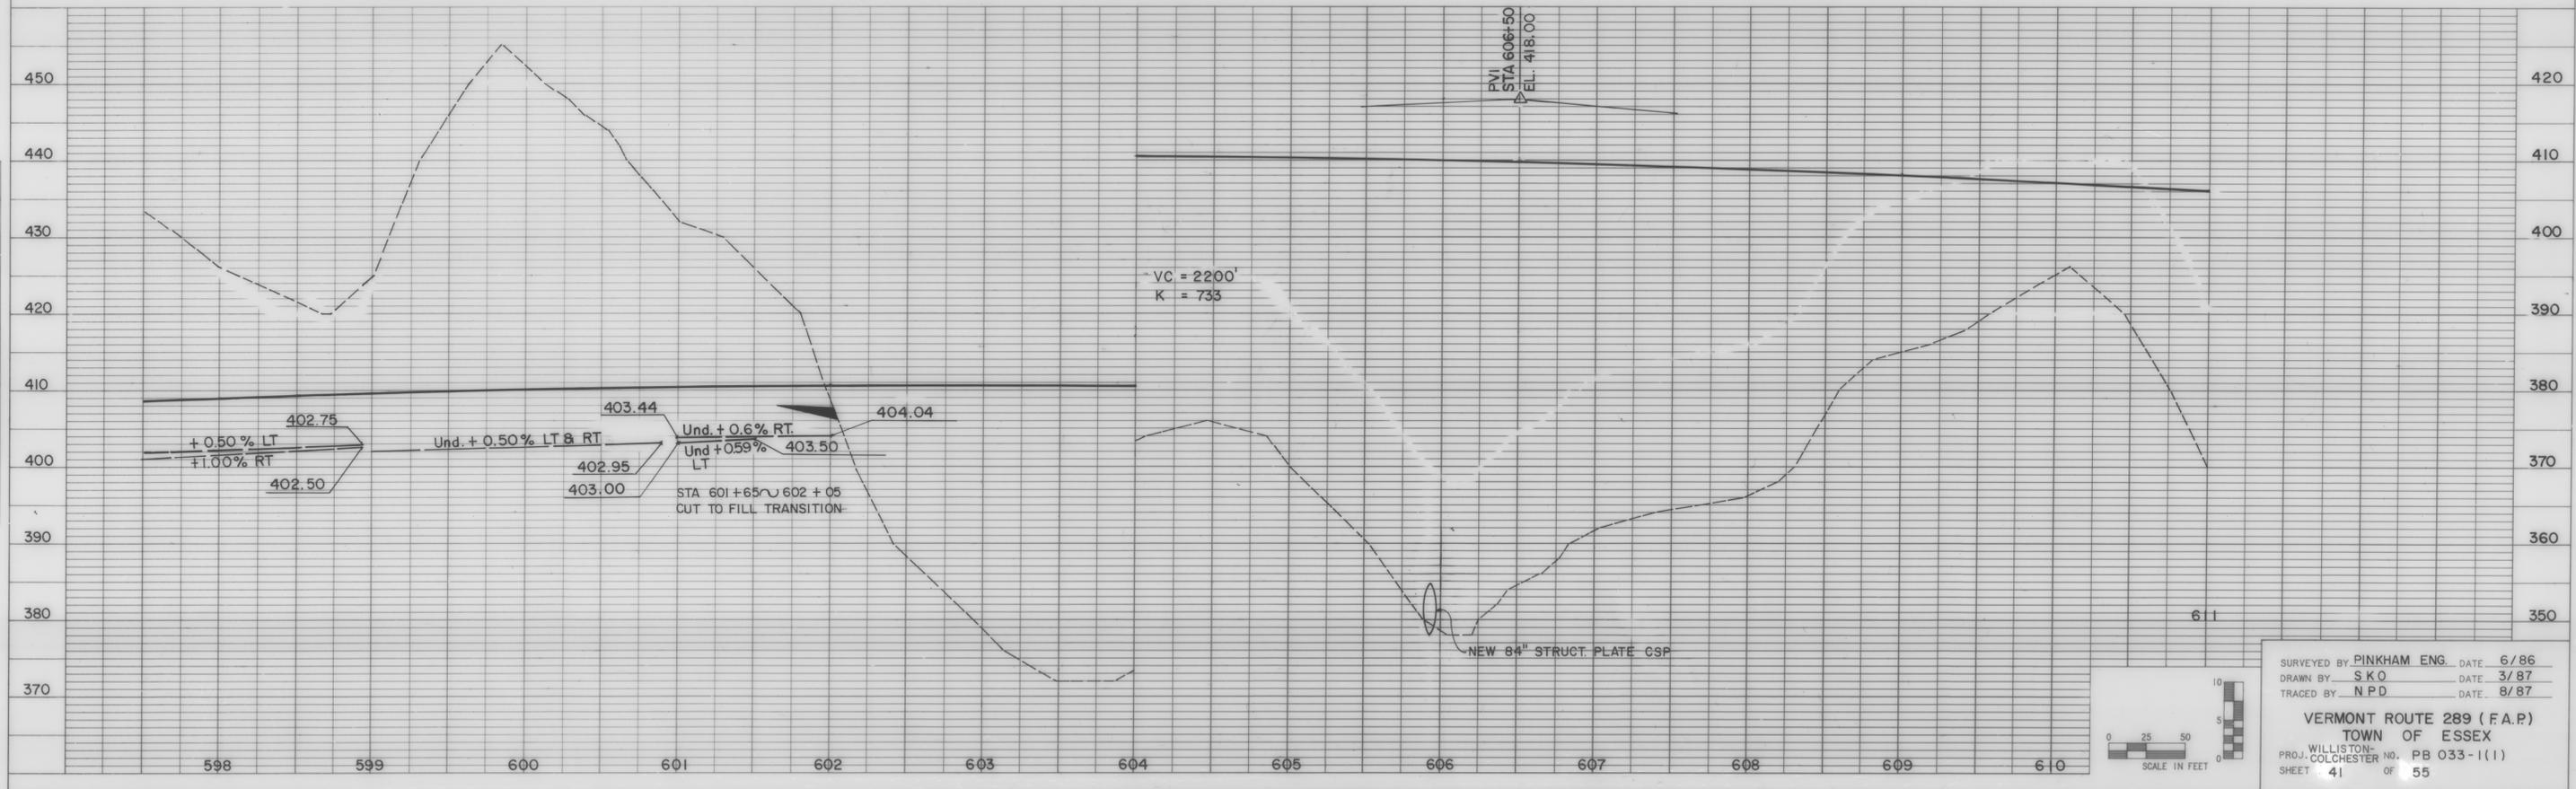

SURVEYED BY PINKHAM ENG. DATE 6/86
 DRAWN BY S K O DATE 3/87
 TRACED BY N P D DATE 8/87
 VERMONT ROUTE 289 (F.A.P.)
 TOWN OF ESSEX
 WILLISTON PROJ. NO. PB 033-1(1)
 SHEET 41 OF 55