


PROFILE SURVEYED BY DATE
 NOTE BOOK GRADES CHECKED PLOTTED
 NO. STRUCTURE NO. DATE



PROFILE SURVEYED BY DATE
 NOTE BOOK GRADES CHECKED PLOTTED
 NO. STRUCTURE NO. DATE

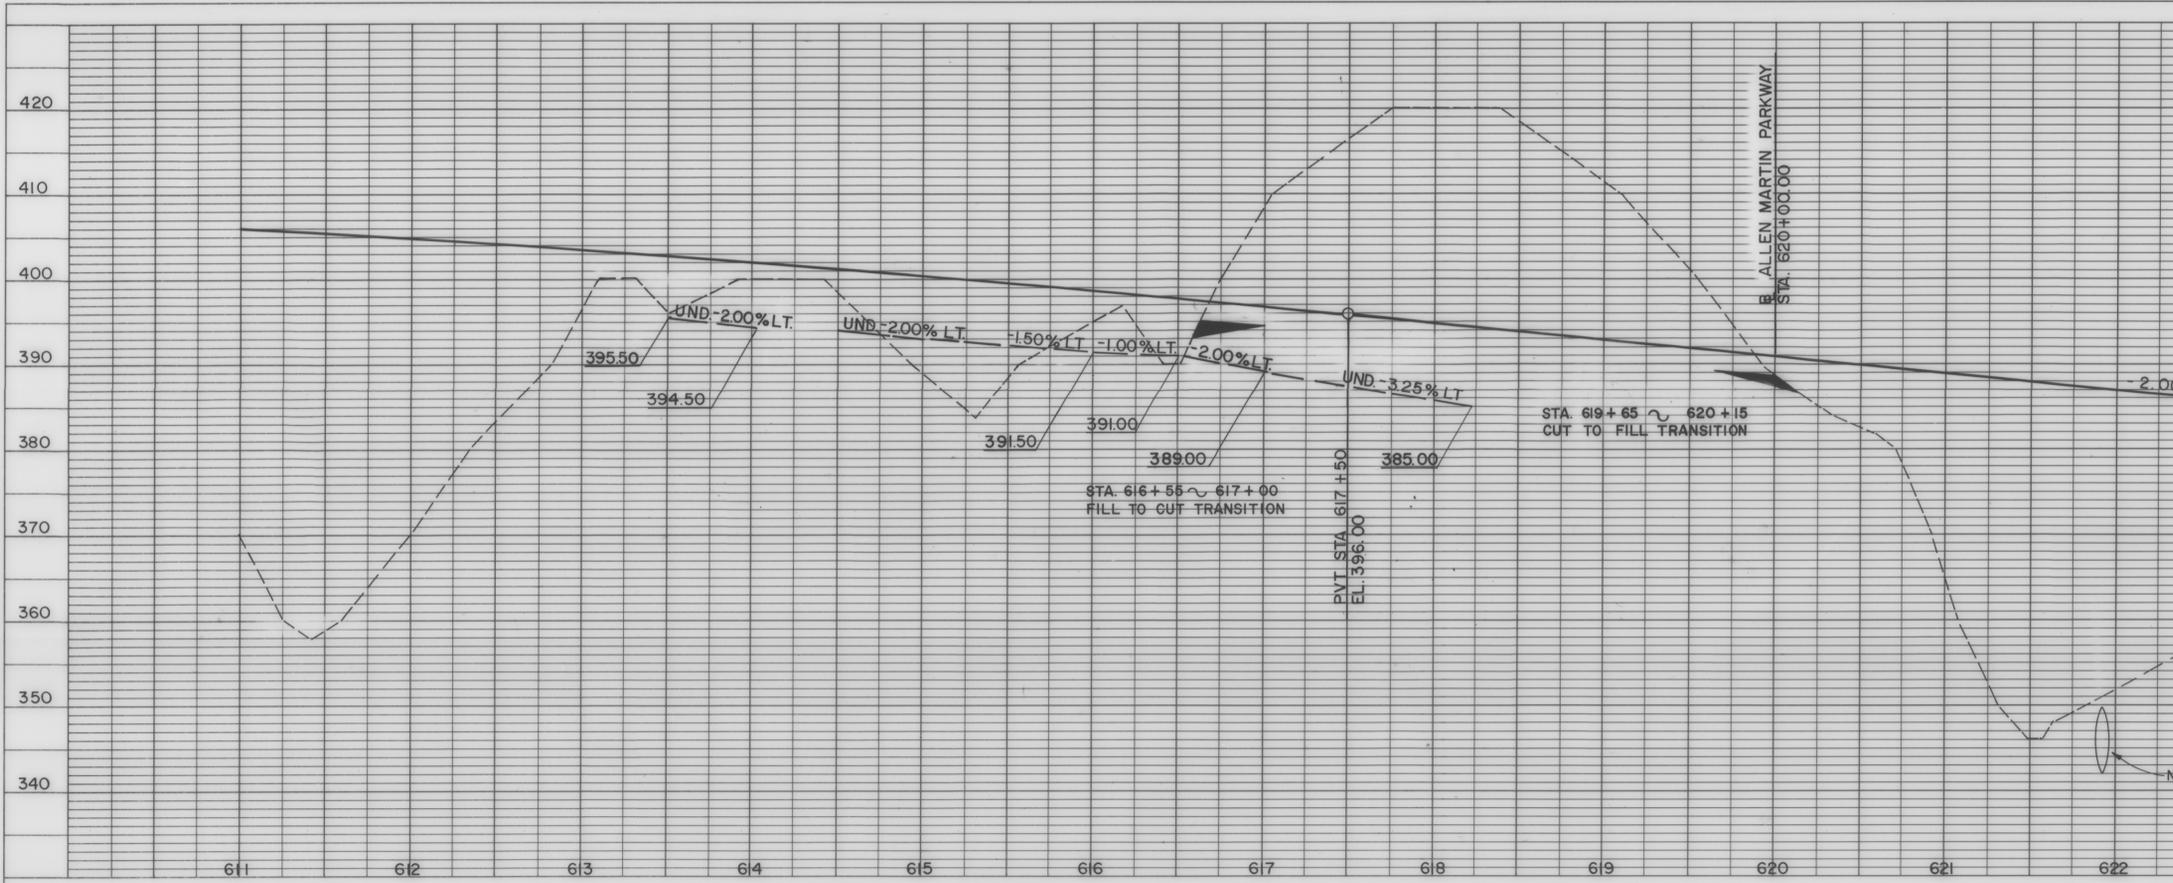