



PROFILE SURVEYED BY DATE
 NOTE BOOK GRADES CHECKED
 B.M.'s NOTED
 NO. STRUCTURE NOTATIONS CH'VD

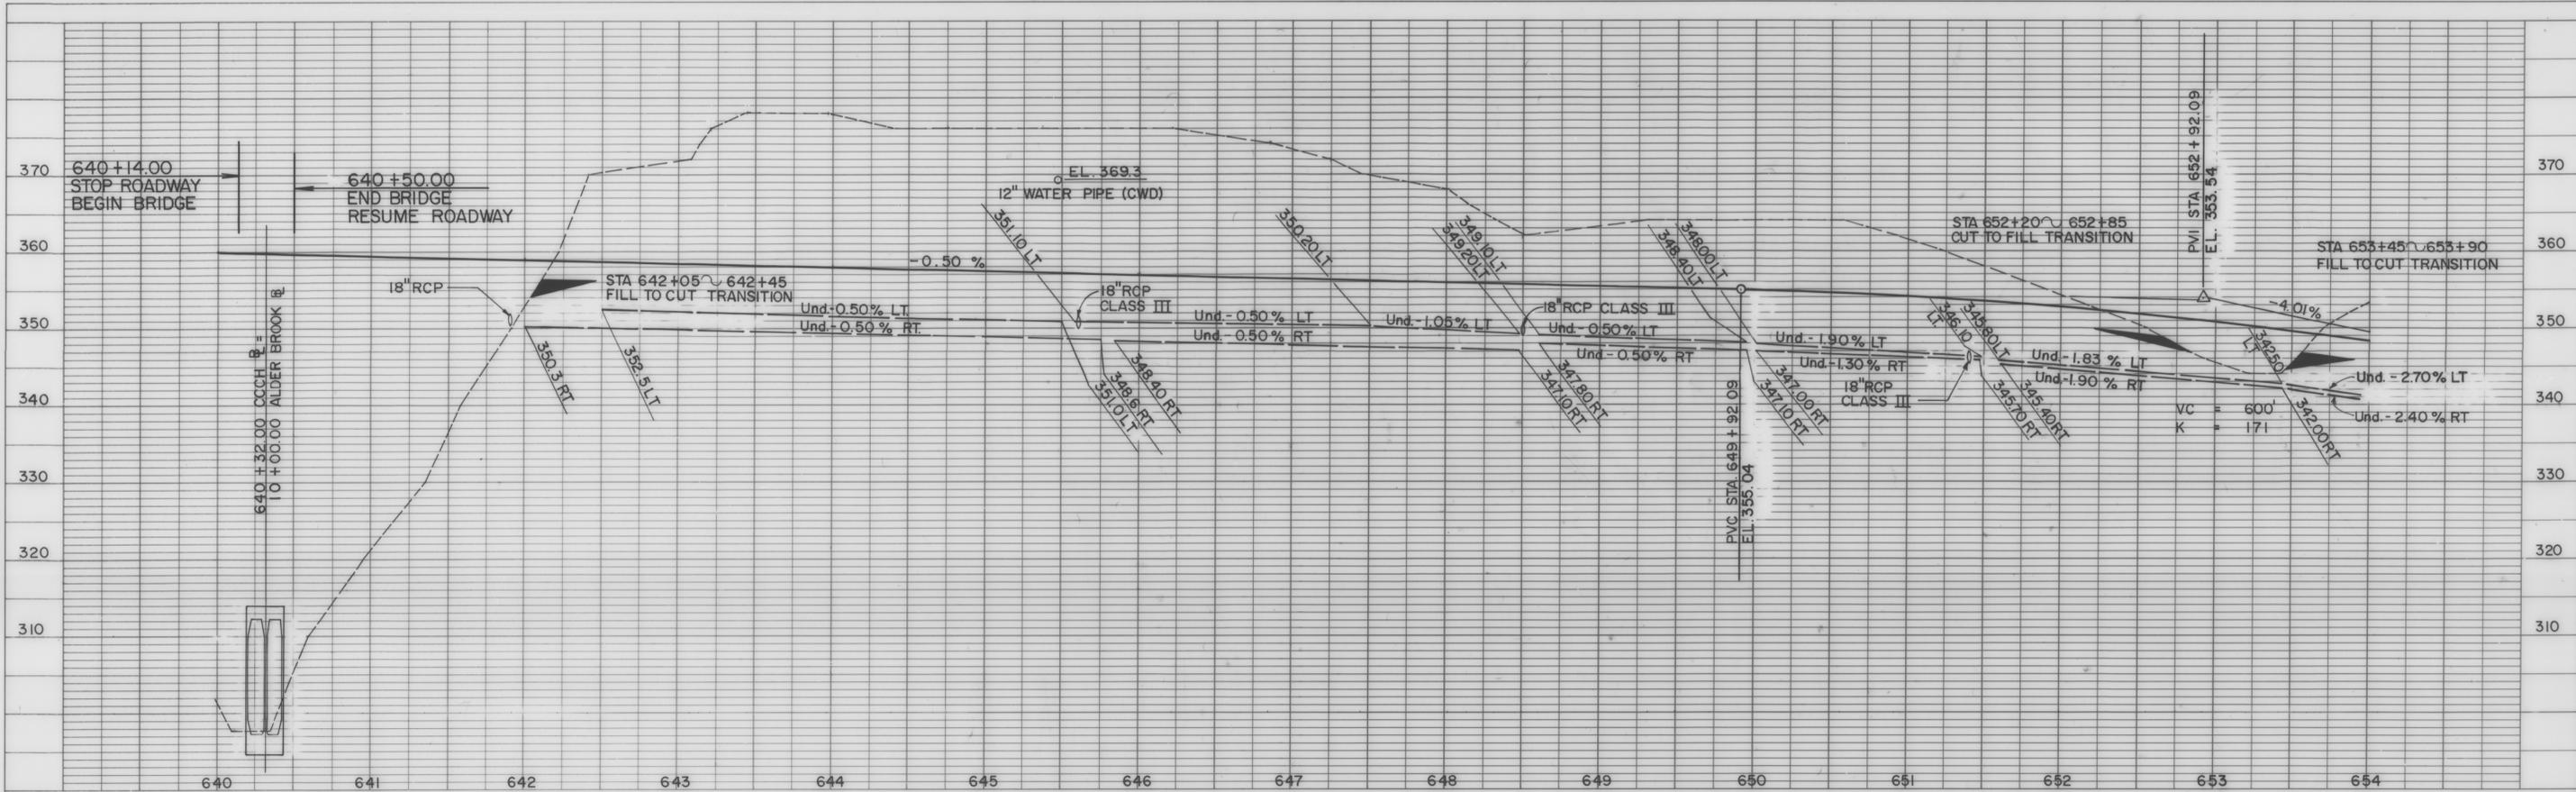

PROFILE SURVEYED BY DATE
 NOTE BOOK GRADES CHECKED
 B.M.'s NOTED
 NO. STRUCTURE NOTATIONS CH'VD

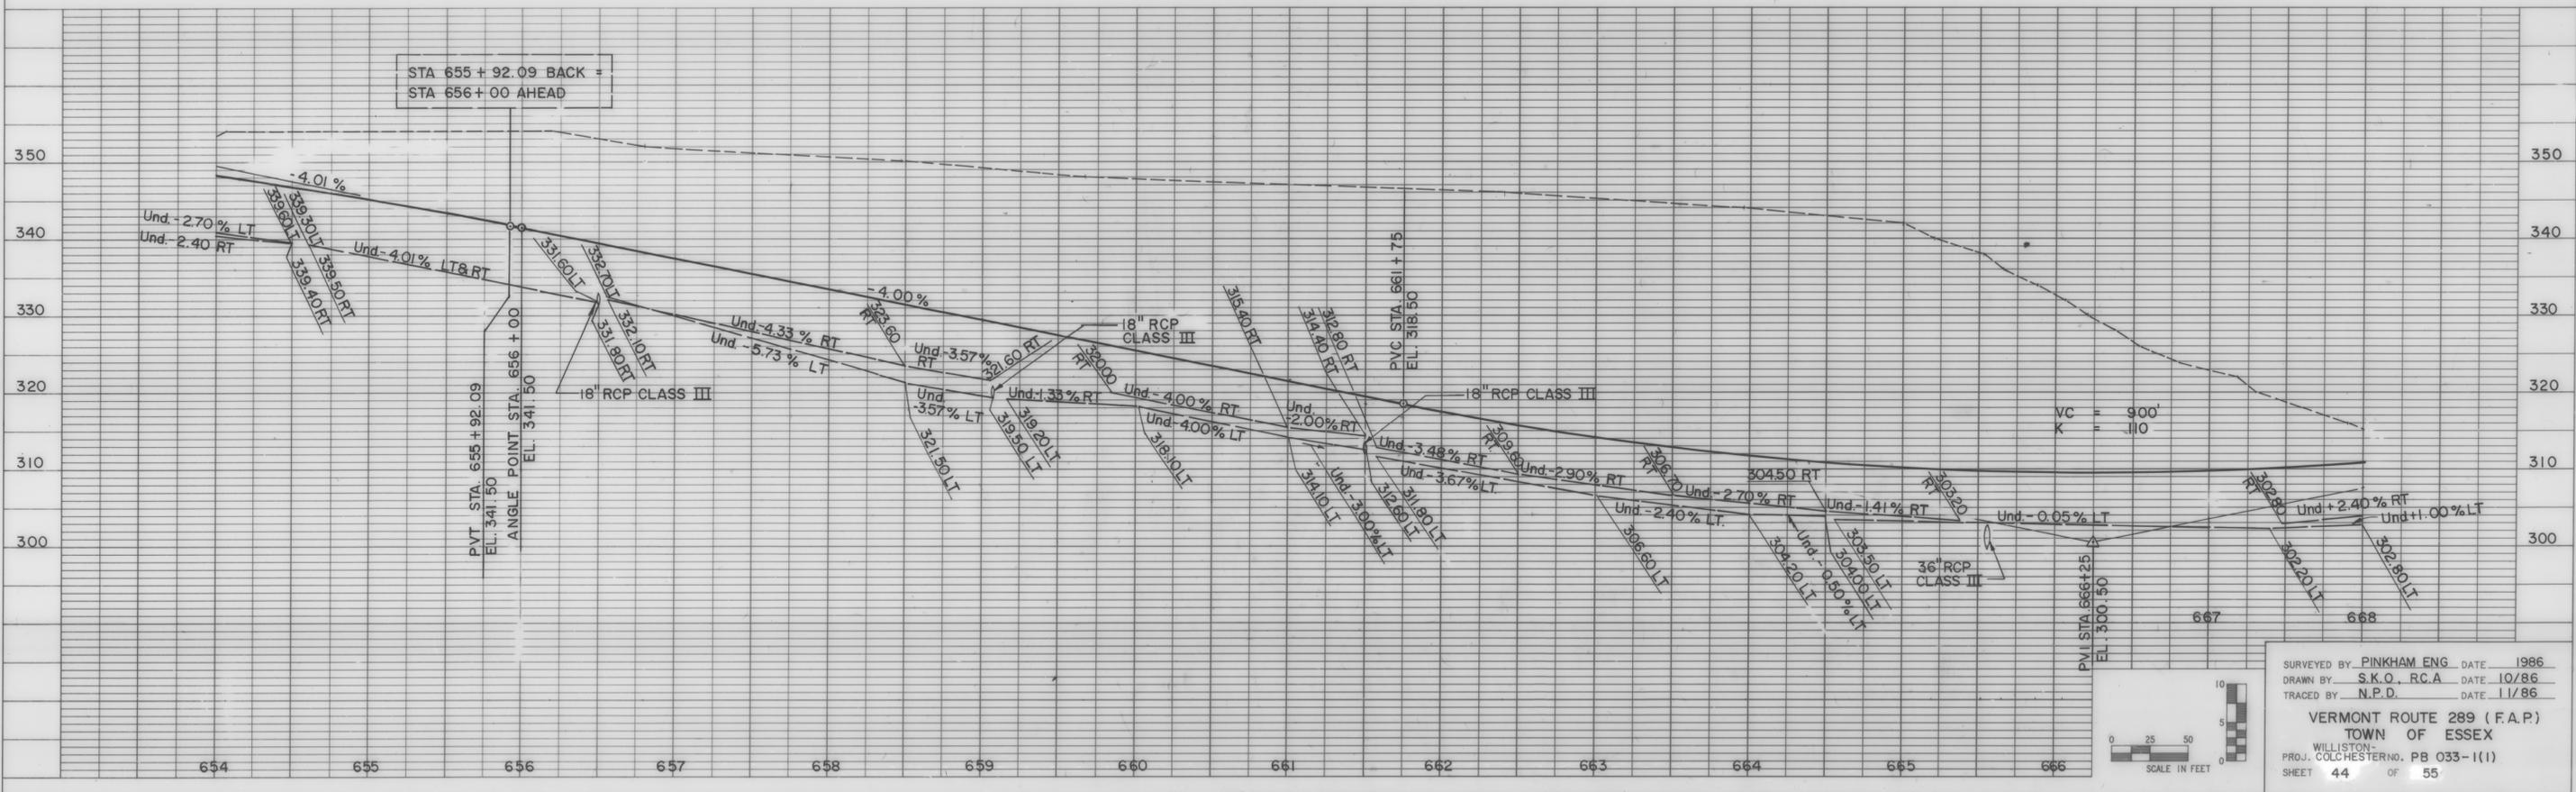

SURVEYED BY PINKHAM ENG DATE 1986
 DRAWN BY S.K.O. R.C.A DATE 10/86
 TRACED BY N.P.D. DATE 11/86
 VERMONT ROUTE 289 (F.A.P.)
 TOWN OF ESSEX
 WILLISTON
 PROJ. COLCHESTERNO. PB 033-1(1)
 SHEET 44 OF 55