

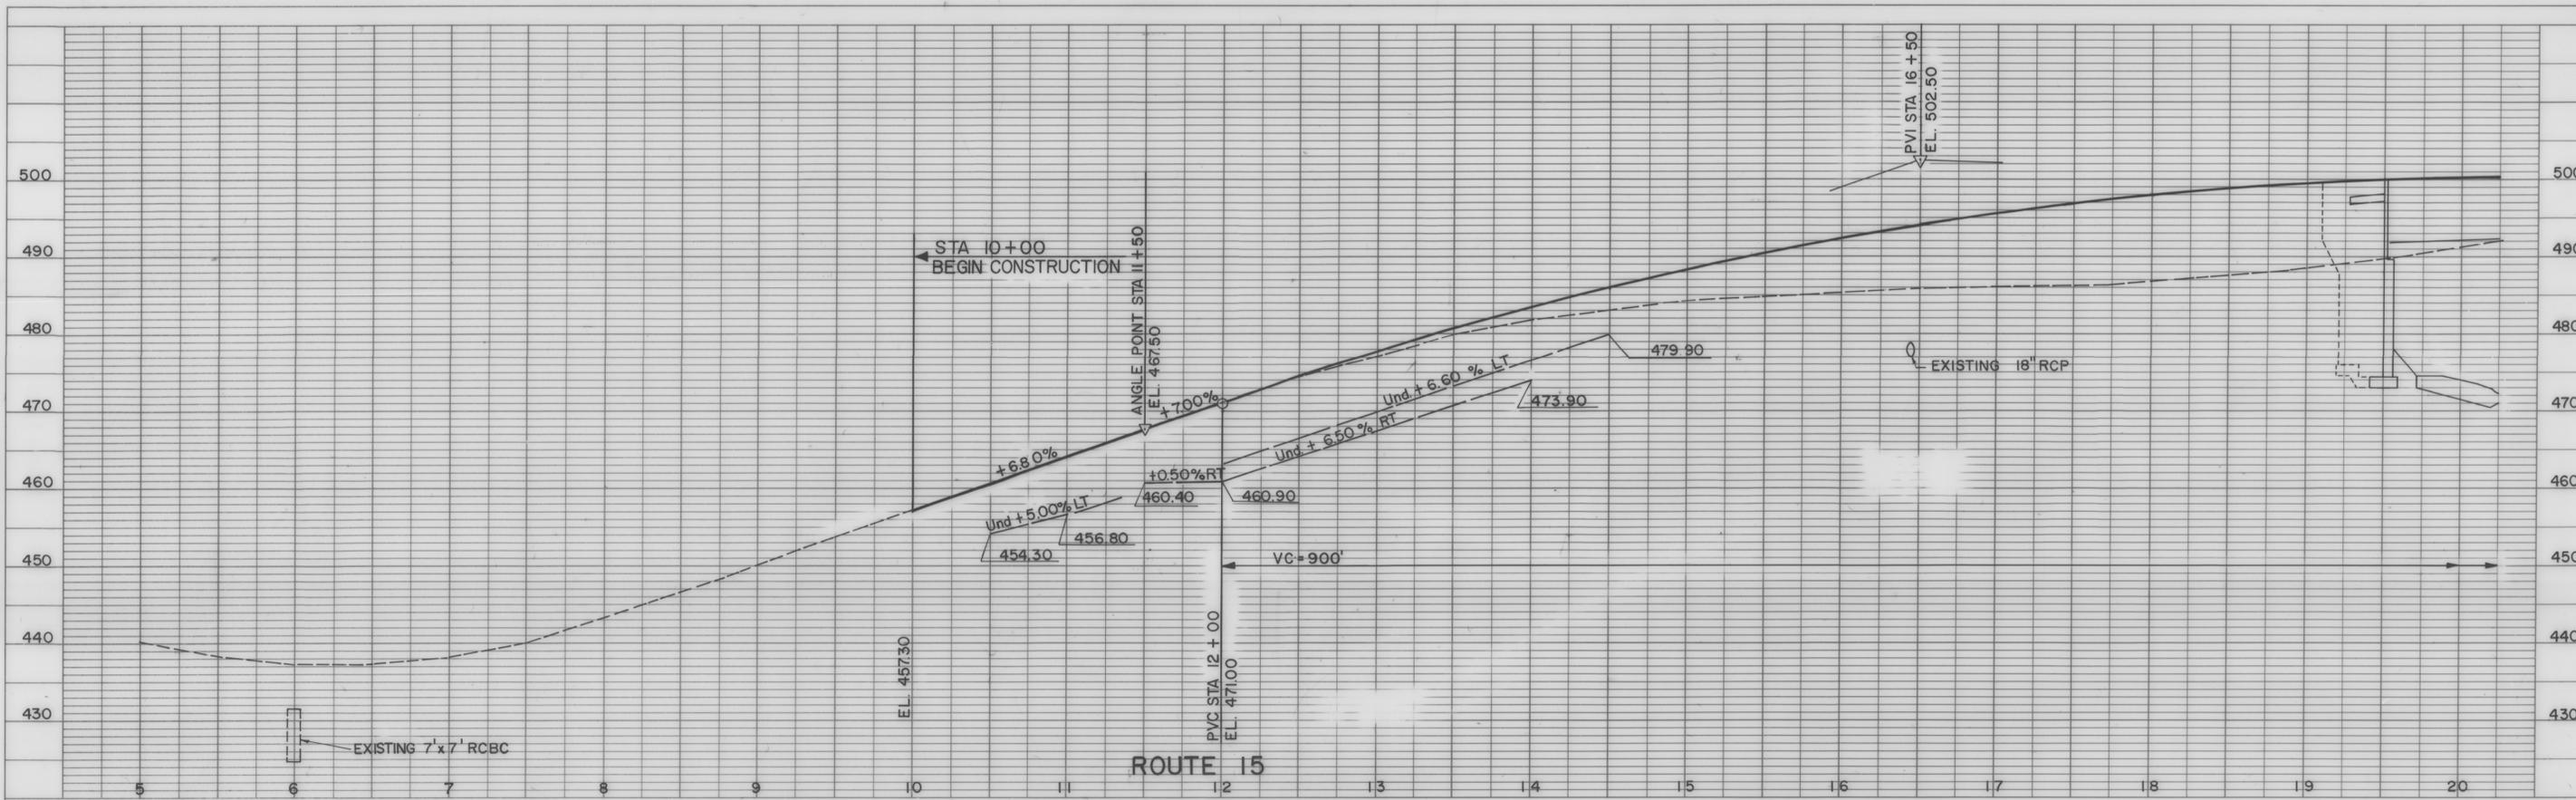


PROFILE
 SURVEYED BY _____ DATE _____
 NOTE BOOK GRADES CHECKED _____
 B.M.'s NOTED _____
 NO. _____ STRUCTURE NOTATIONS CH'VD _____

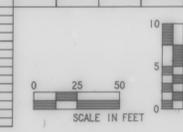

PROFILE
 SURVEYED BY _____ DATE _____
 NOTE BOOK GRADES CHECKED _____
 B.M.'s NOTED _____
 NO. _____ STRUCTURE NOTATIONS CH'VD _____

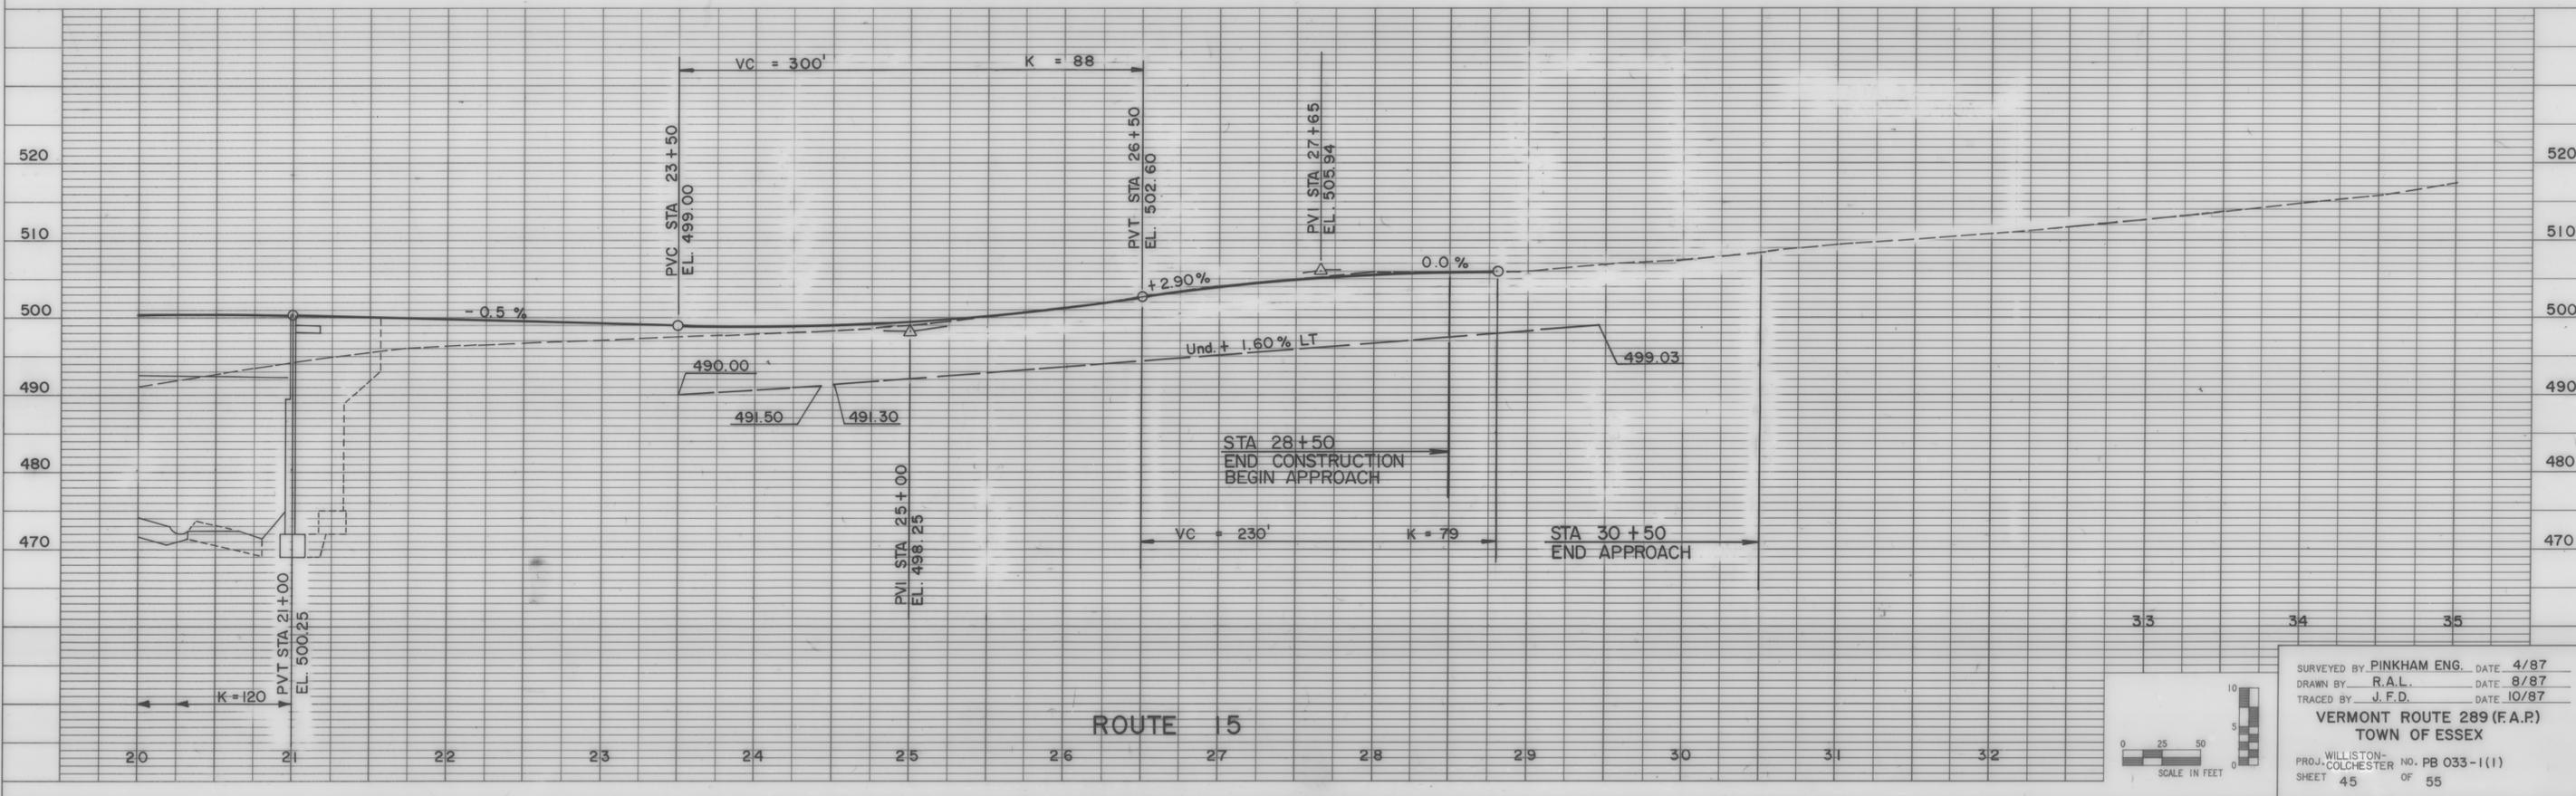

SURVEYED BY PINKHAM ENG. DATE 4/87
 DRAWN BY R.A.L. DATE 8/87
 TRACED BY J.F.D. DATE 10/87
VERMONT ROUTE 289 (F.A.P.)
TOWN OF ESSEX
 PROJ. WILLISTON-COLCHESTER NO. PB 033-1(1)
 SHEET 45 OF 55